


C.H. 114 60° R/W

T.H. 157 Old T.H. 129 40° R/W

Section 22 Walnut Creek Twp

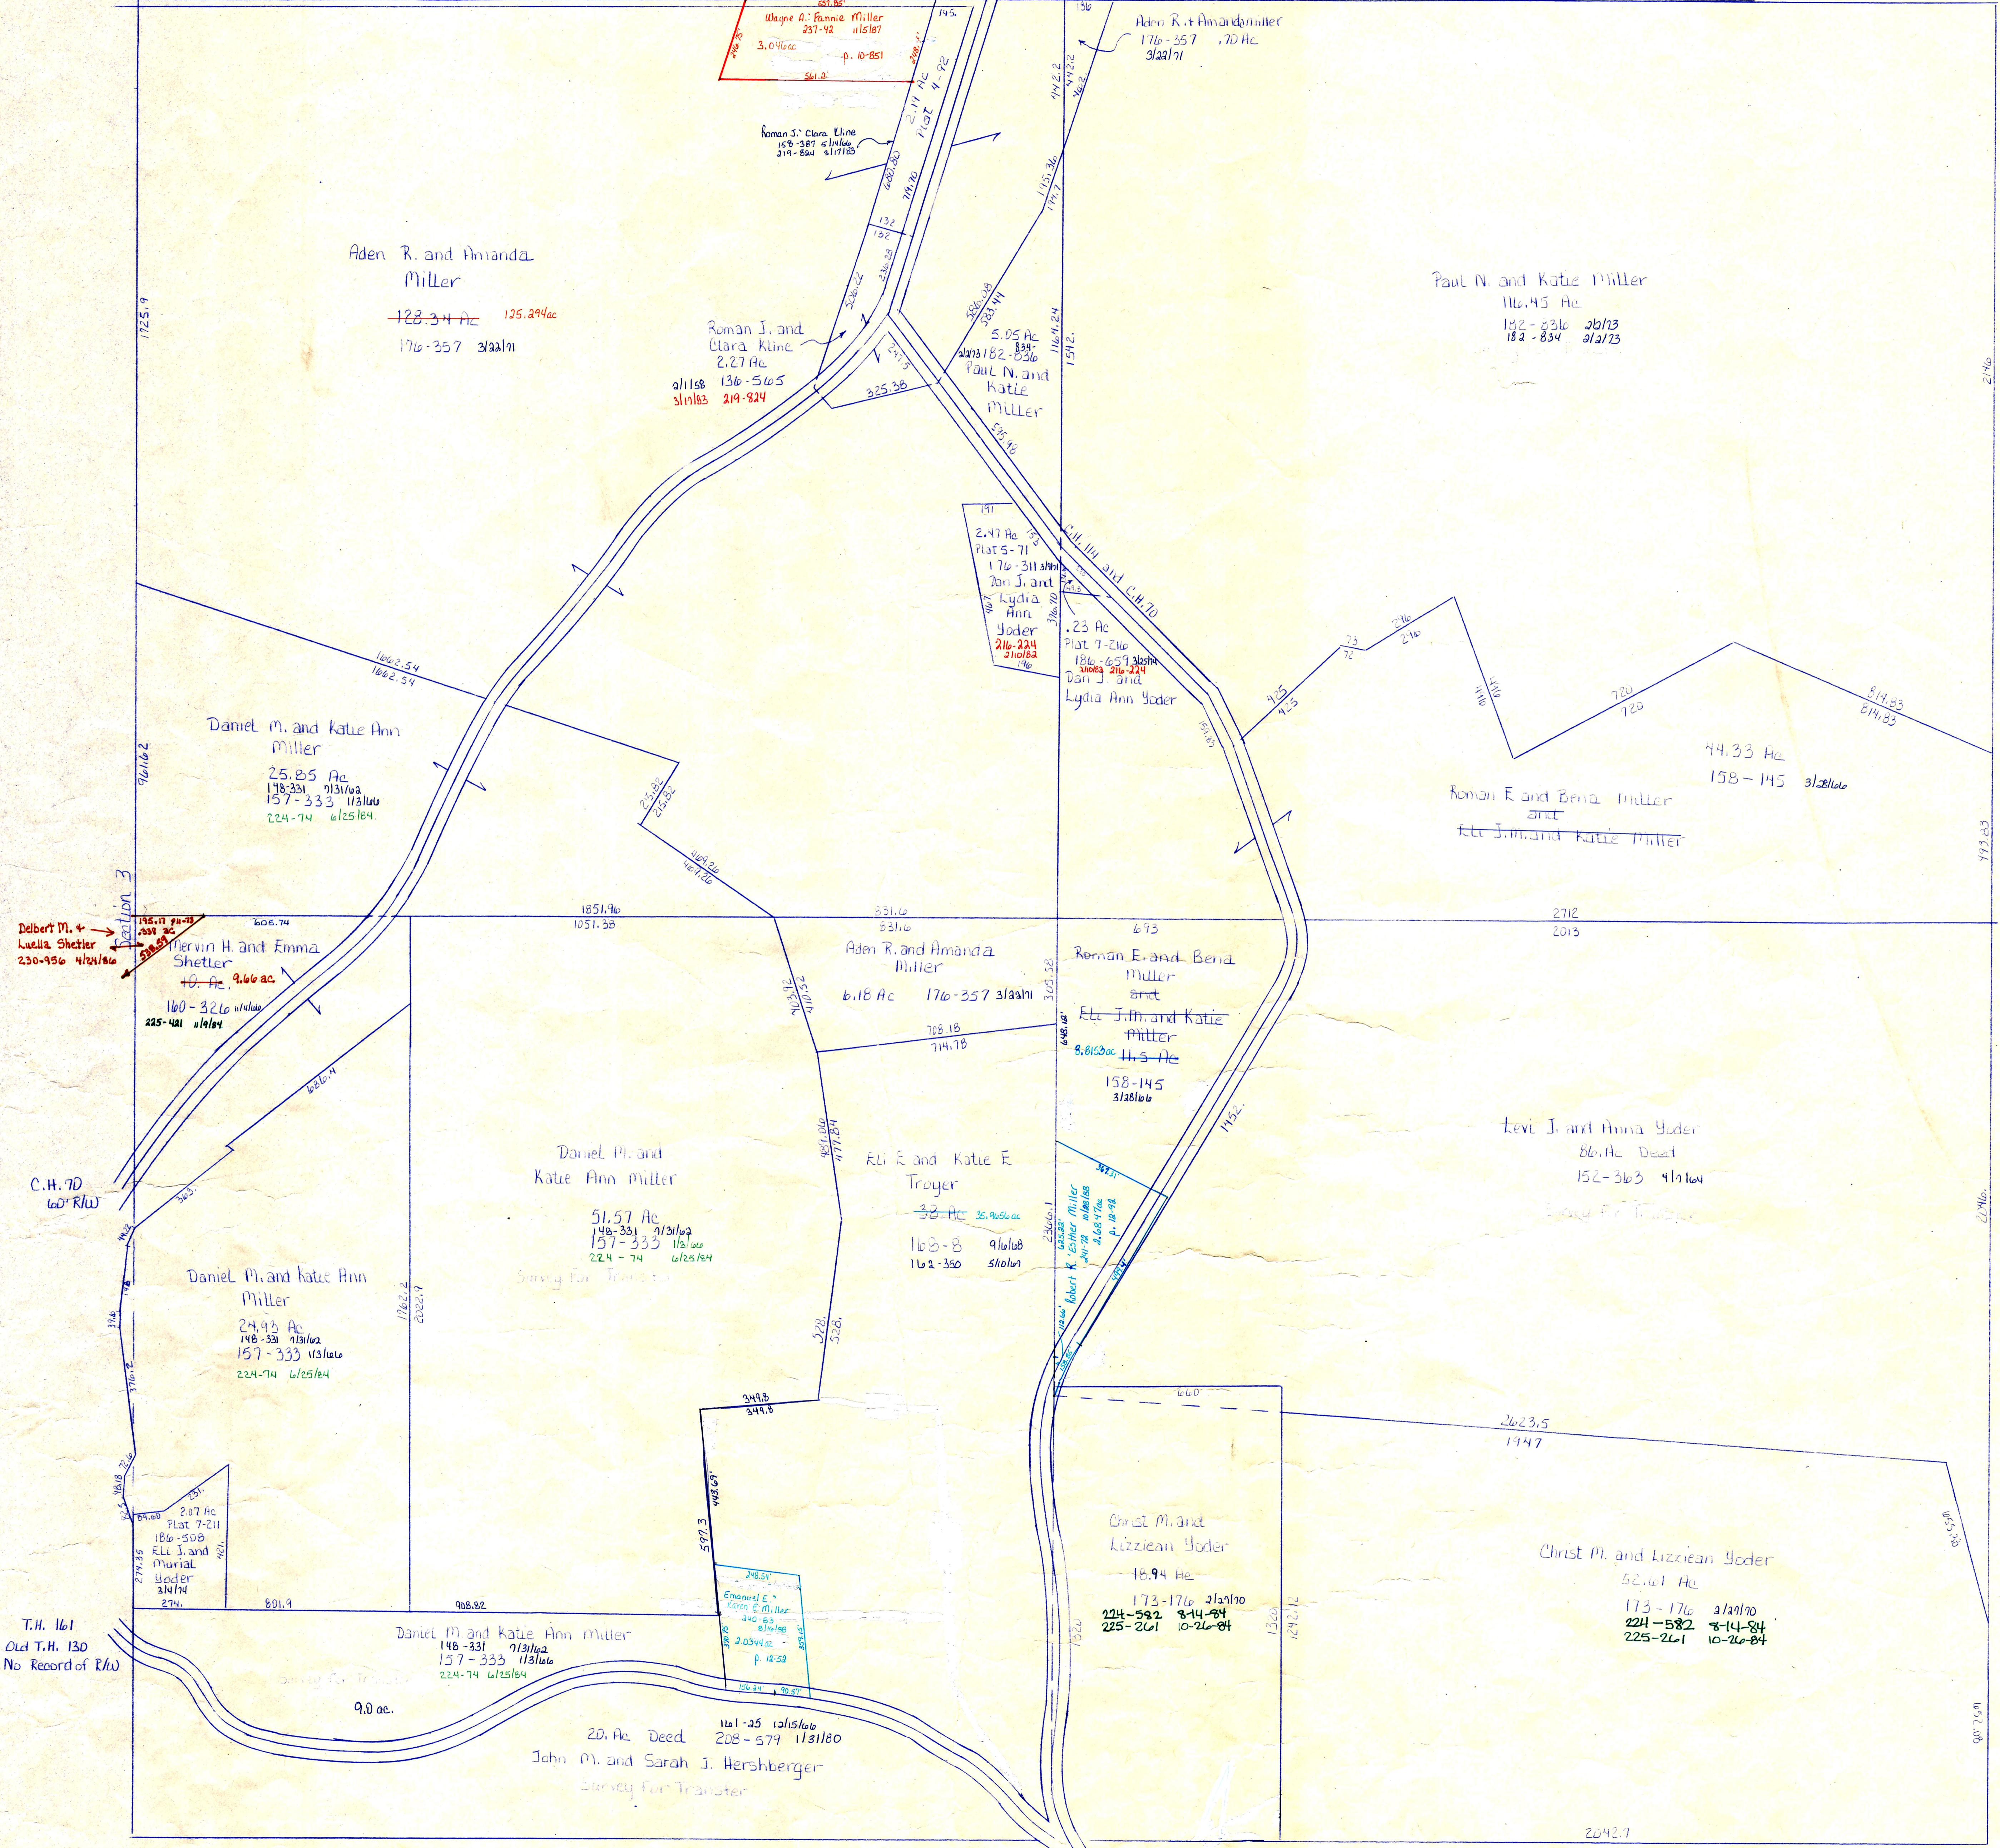

Section 1
Walnut Creek Twp
Clark Twp

Section 9

Survey for Transfer
See Sec. 9 - J. Gate Survey

T-8, R-5, Sec. 2
CLARK TWP