


SECTION 11

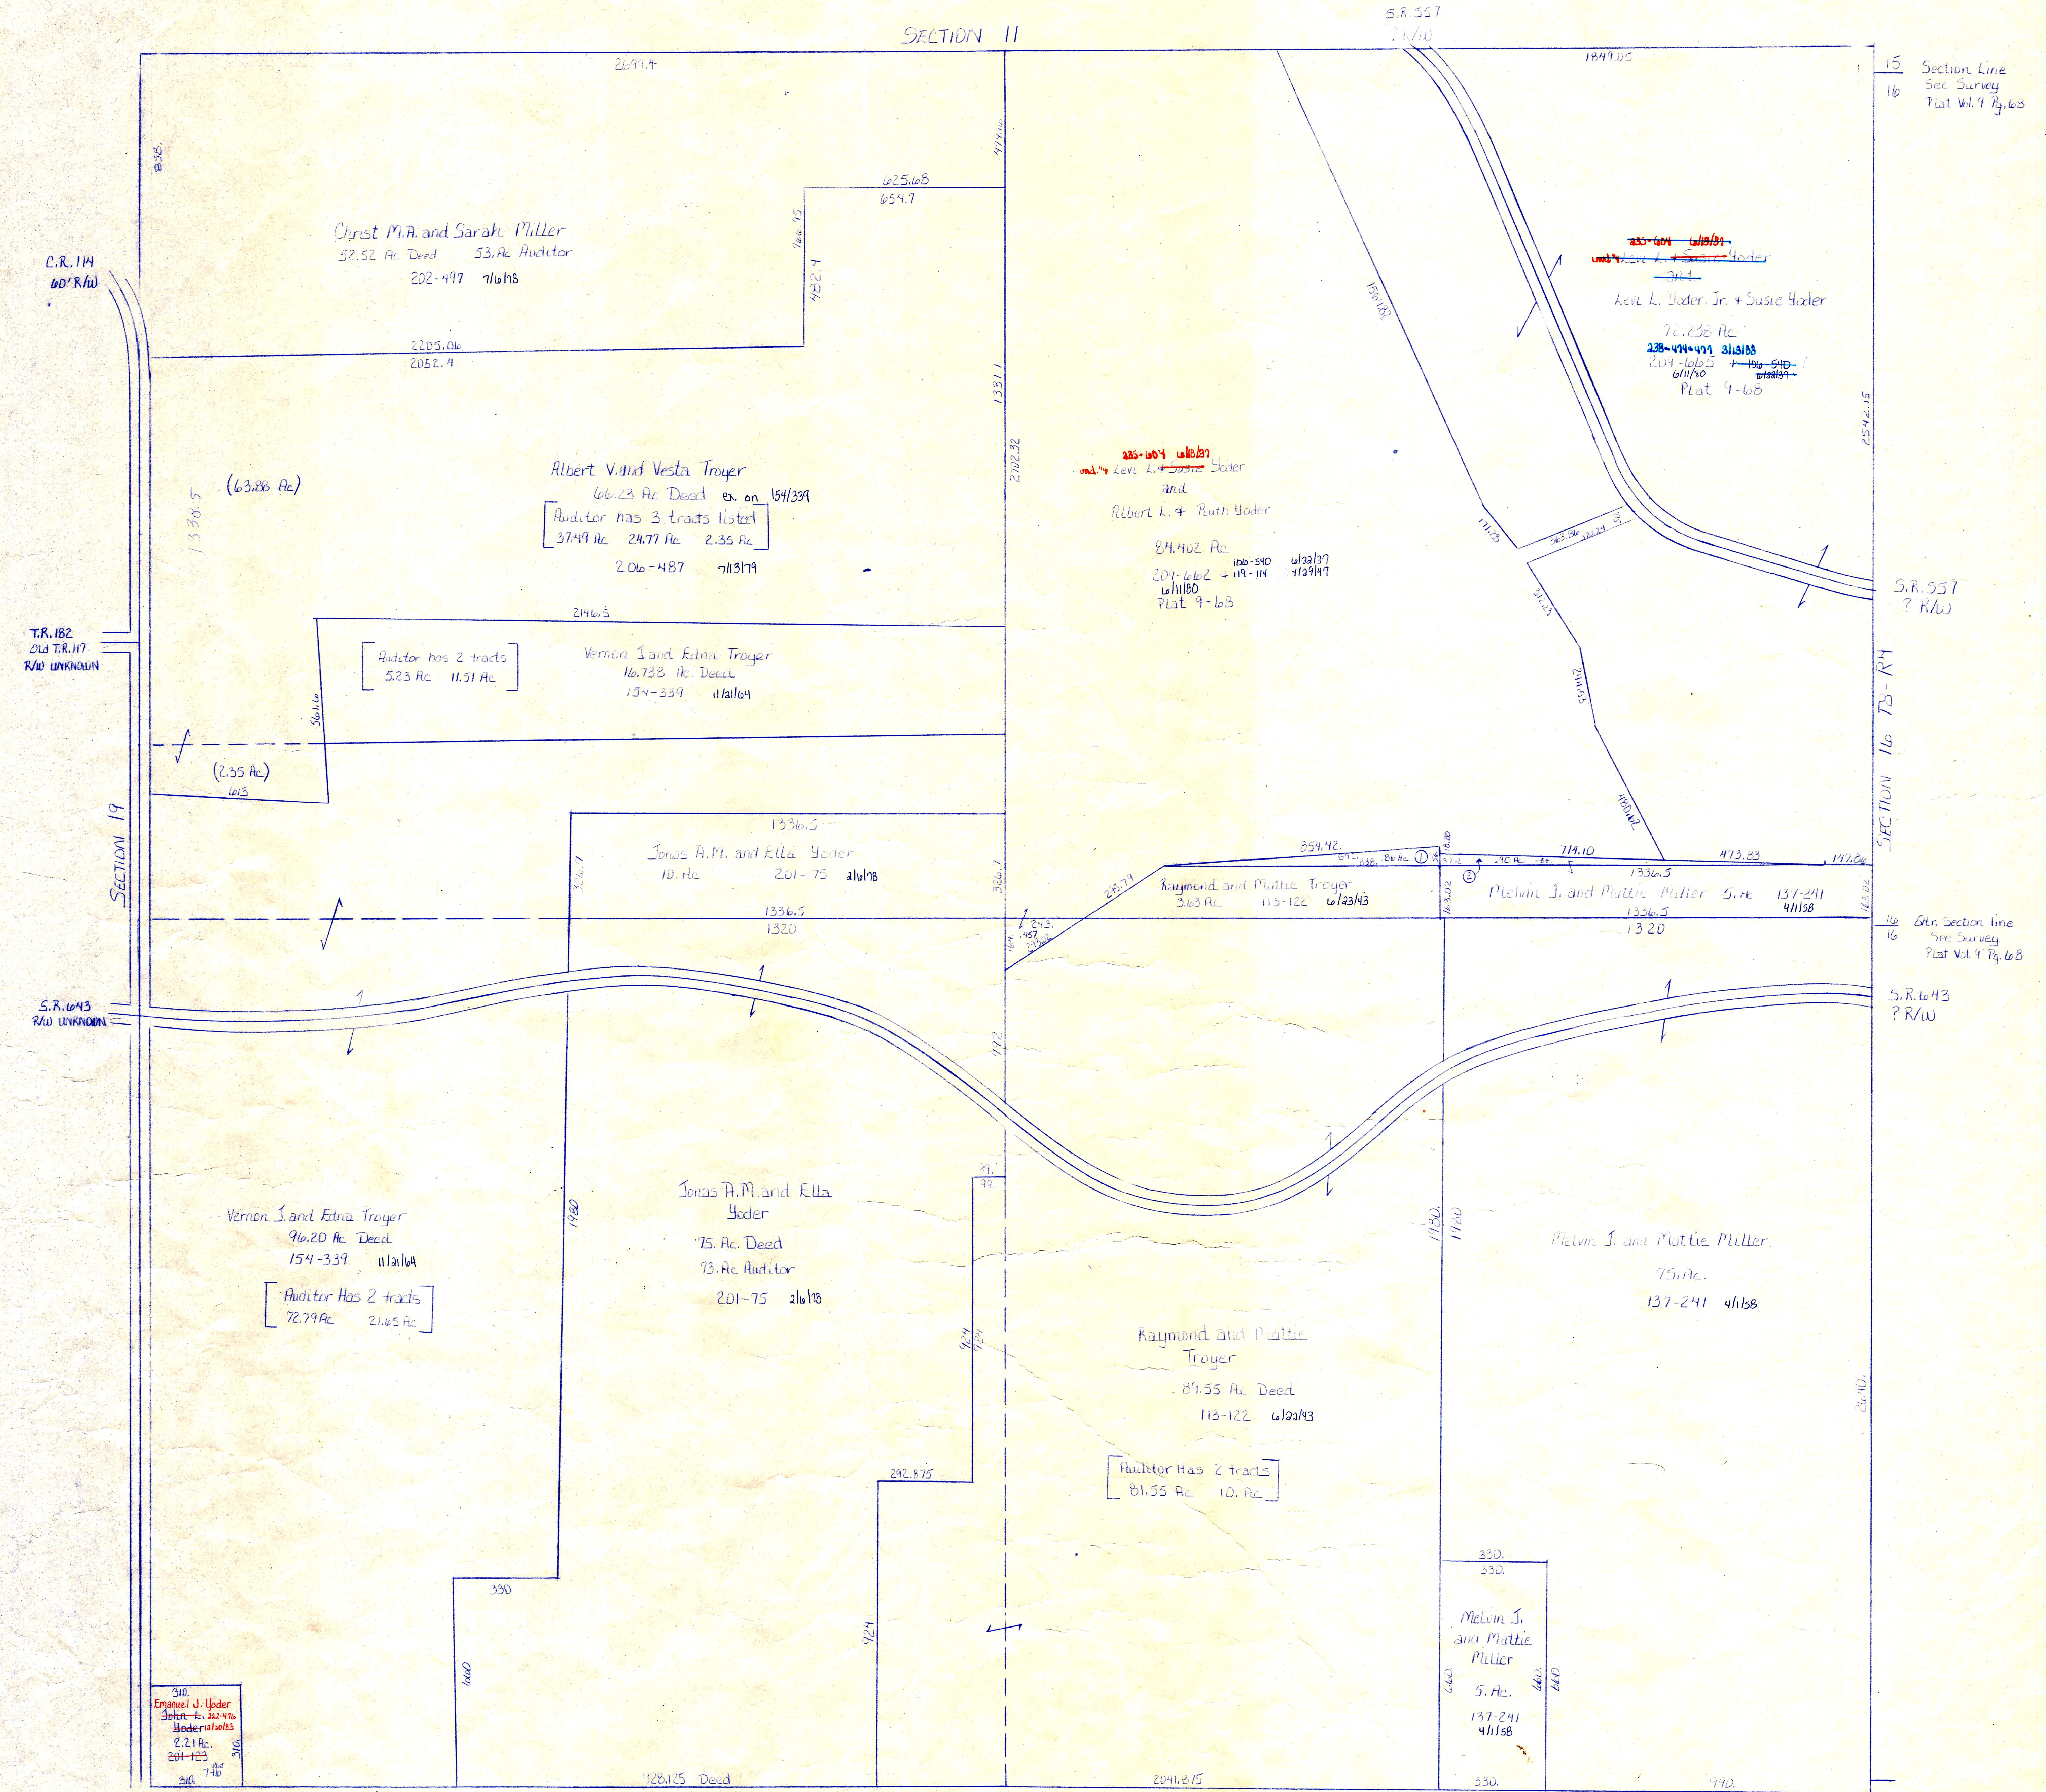


No.	Ac.	Vol. - Pg.	Name	412147
1.	.86	119-113	Raymond and Mattie Troyer	412147
2.	.90	137-241	Melvin J. and Mattie Miller	411158

T-8, R-5, Sec. 20
CLARK TWP.

Outside Section Dimensions
from S. R. 5 Pg. 94