


T.H. 162 40' R/W
Old T.H. 137

SECTION I

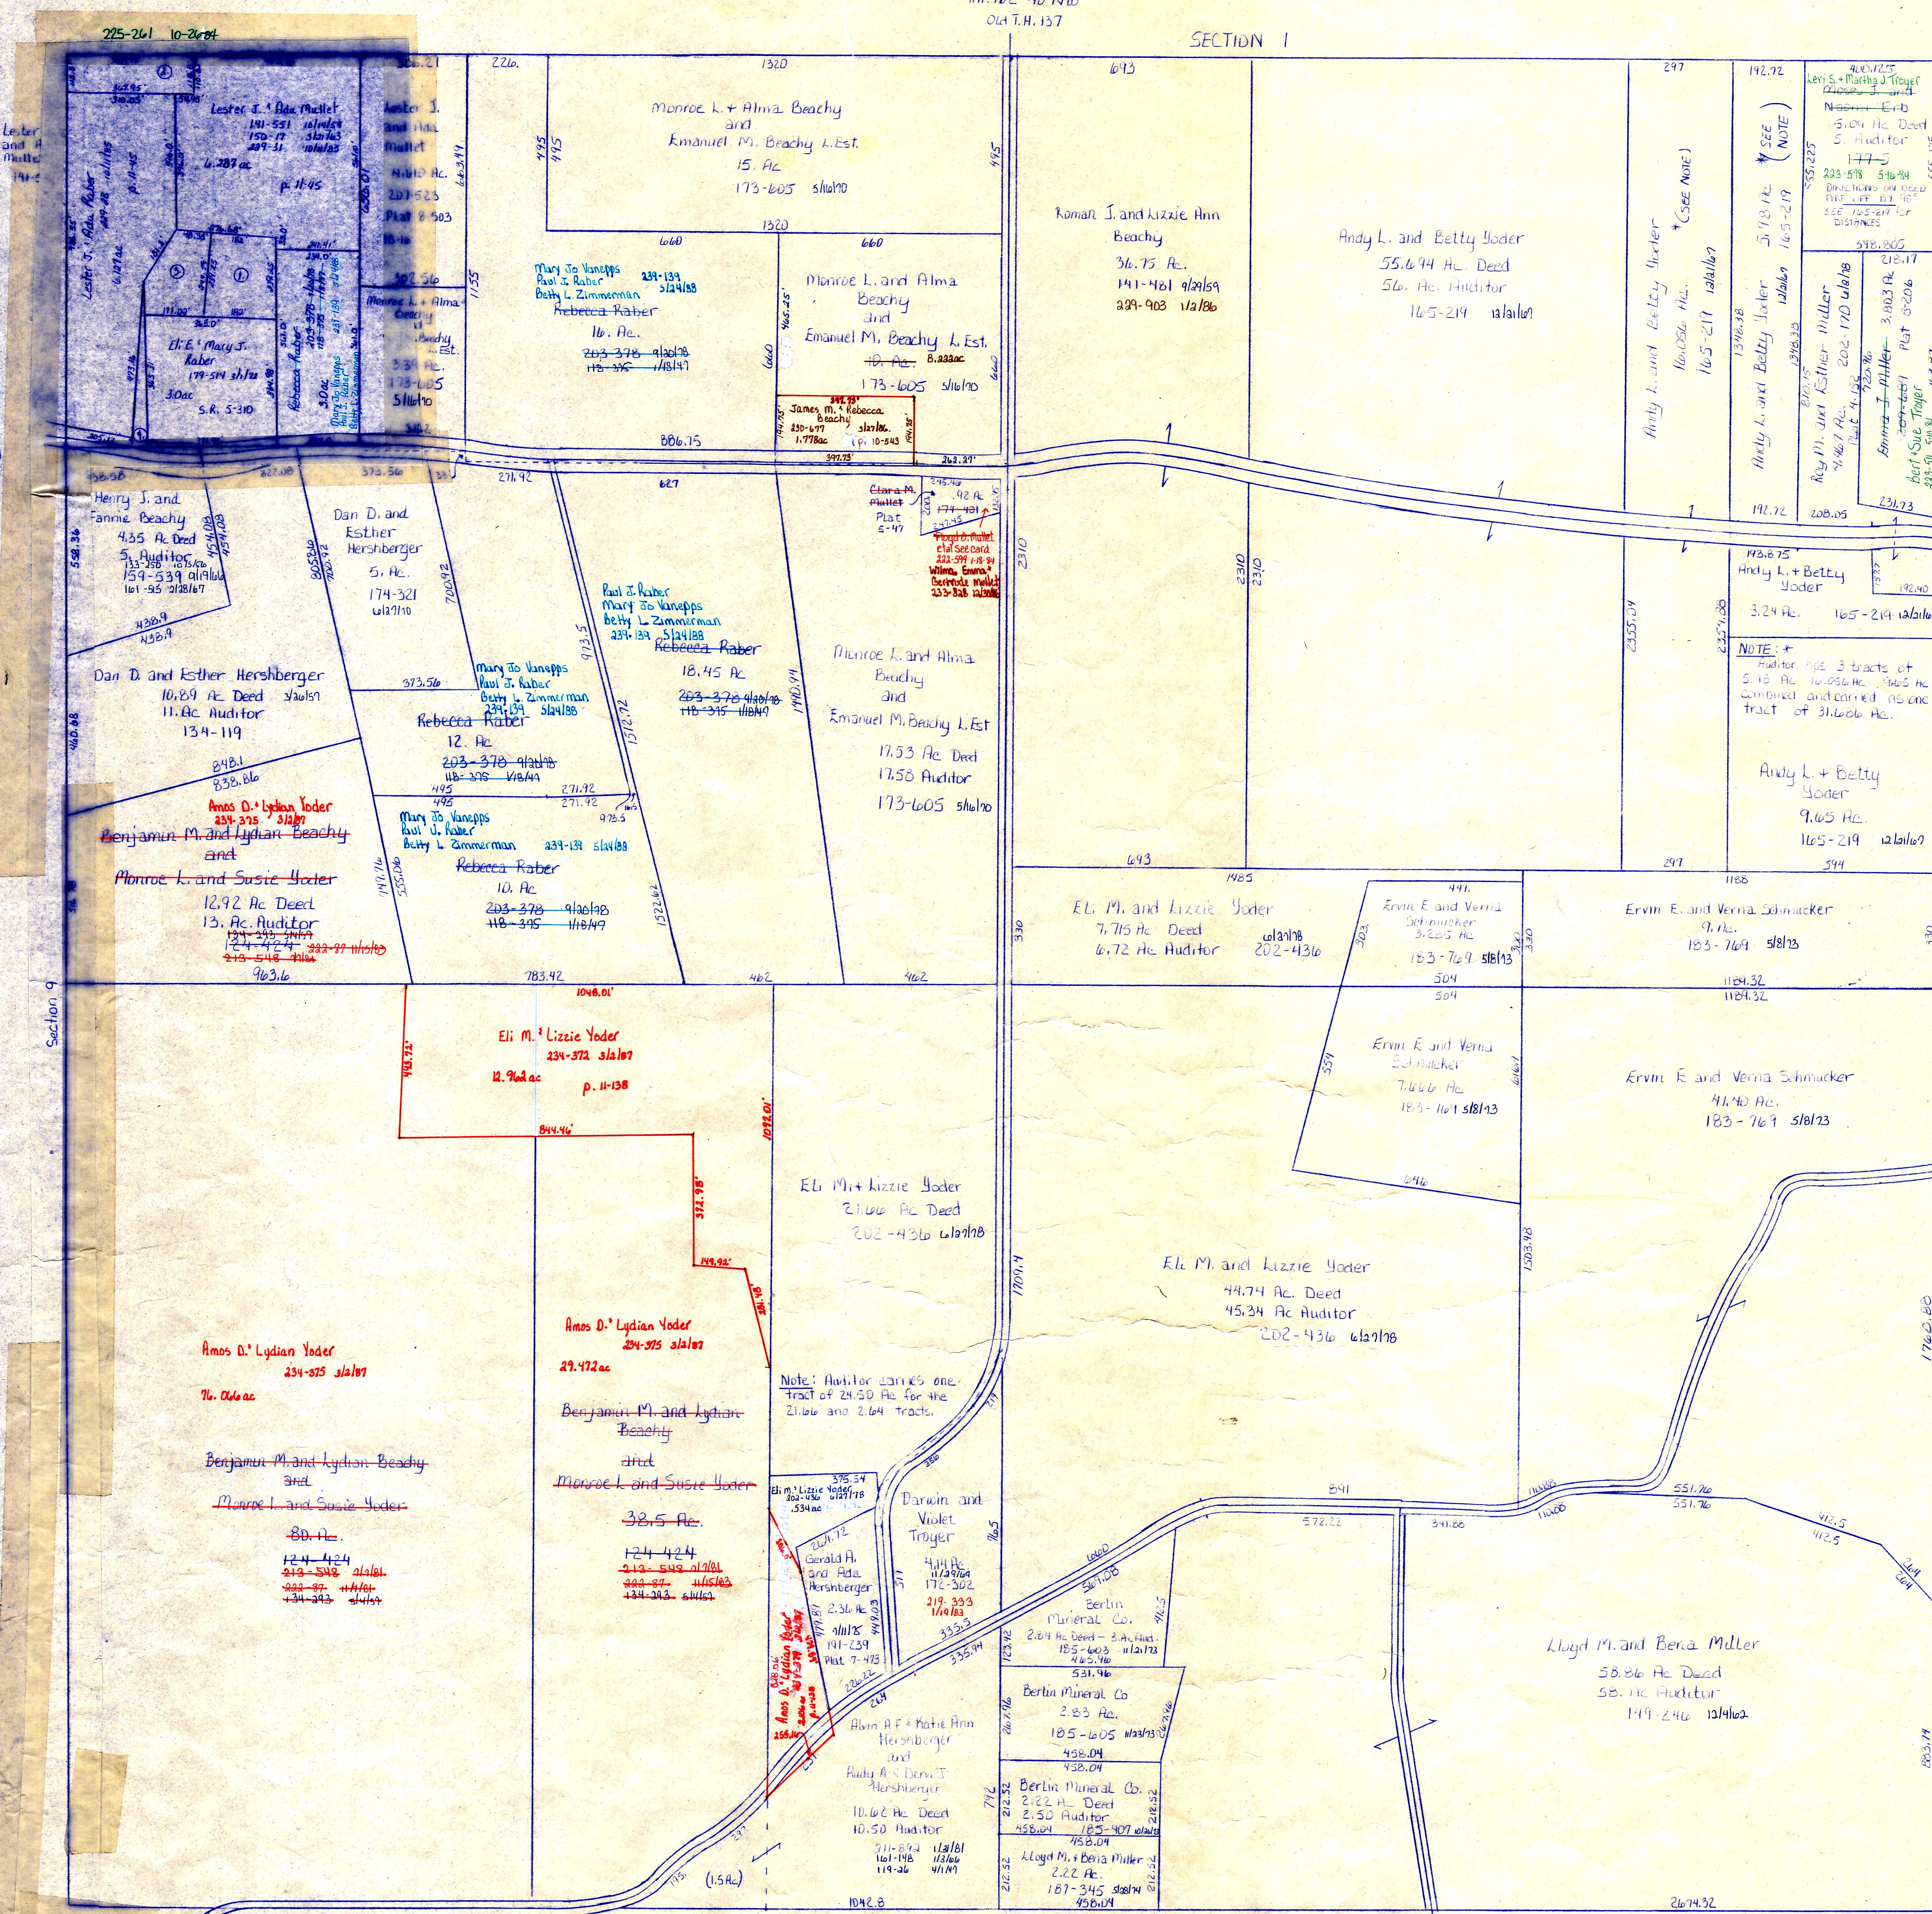

SECTION II

T.H. 165 35' R/W
Old T.H. 141

T-8, R-5, Sec. 10
CLARK TWP.