


T.H. 166 Dld T.H. 139
60' R/W

SECTION 15

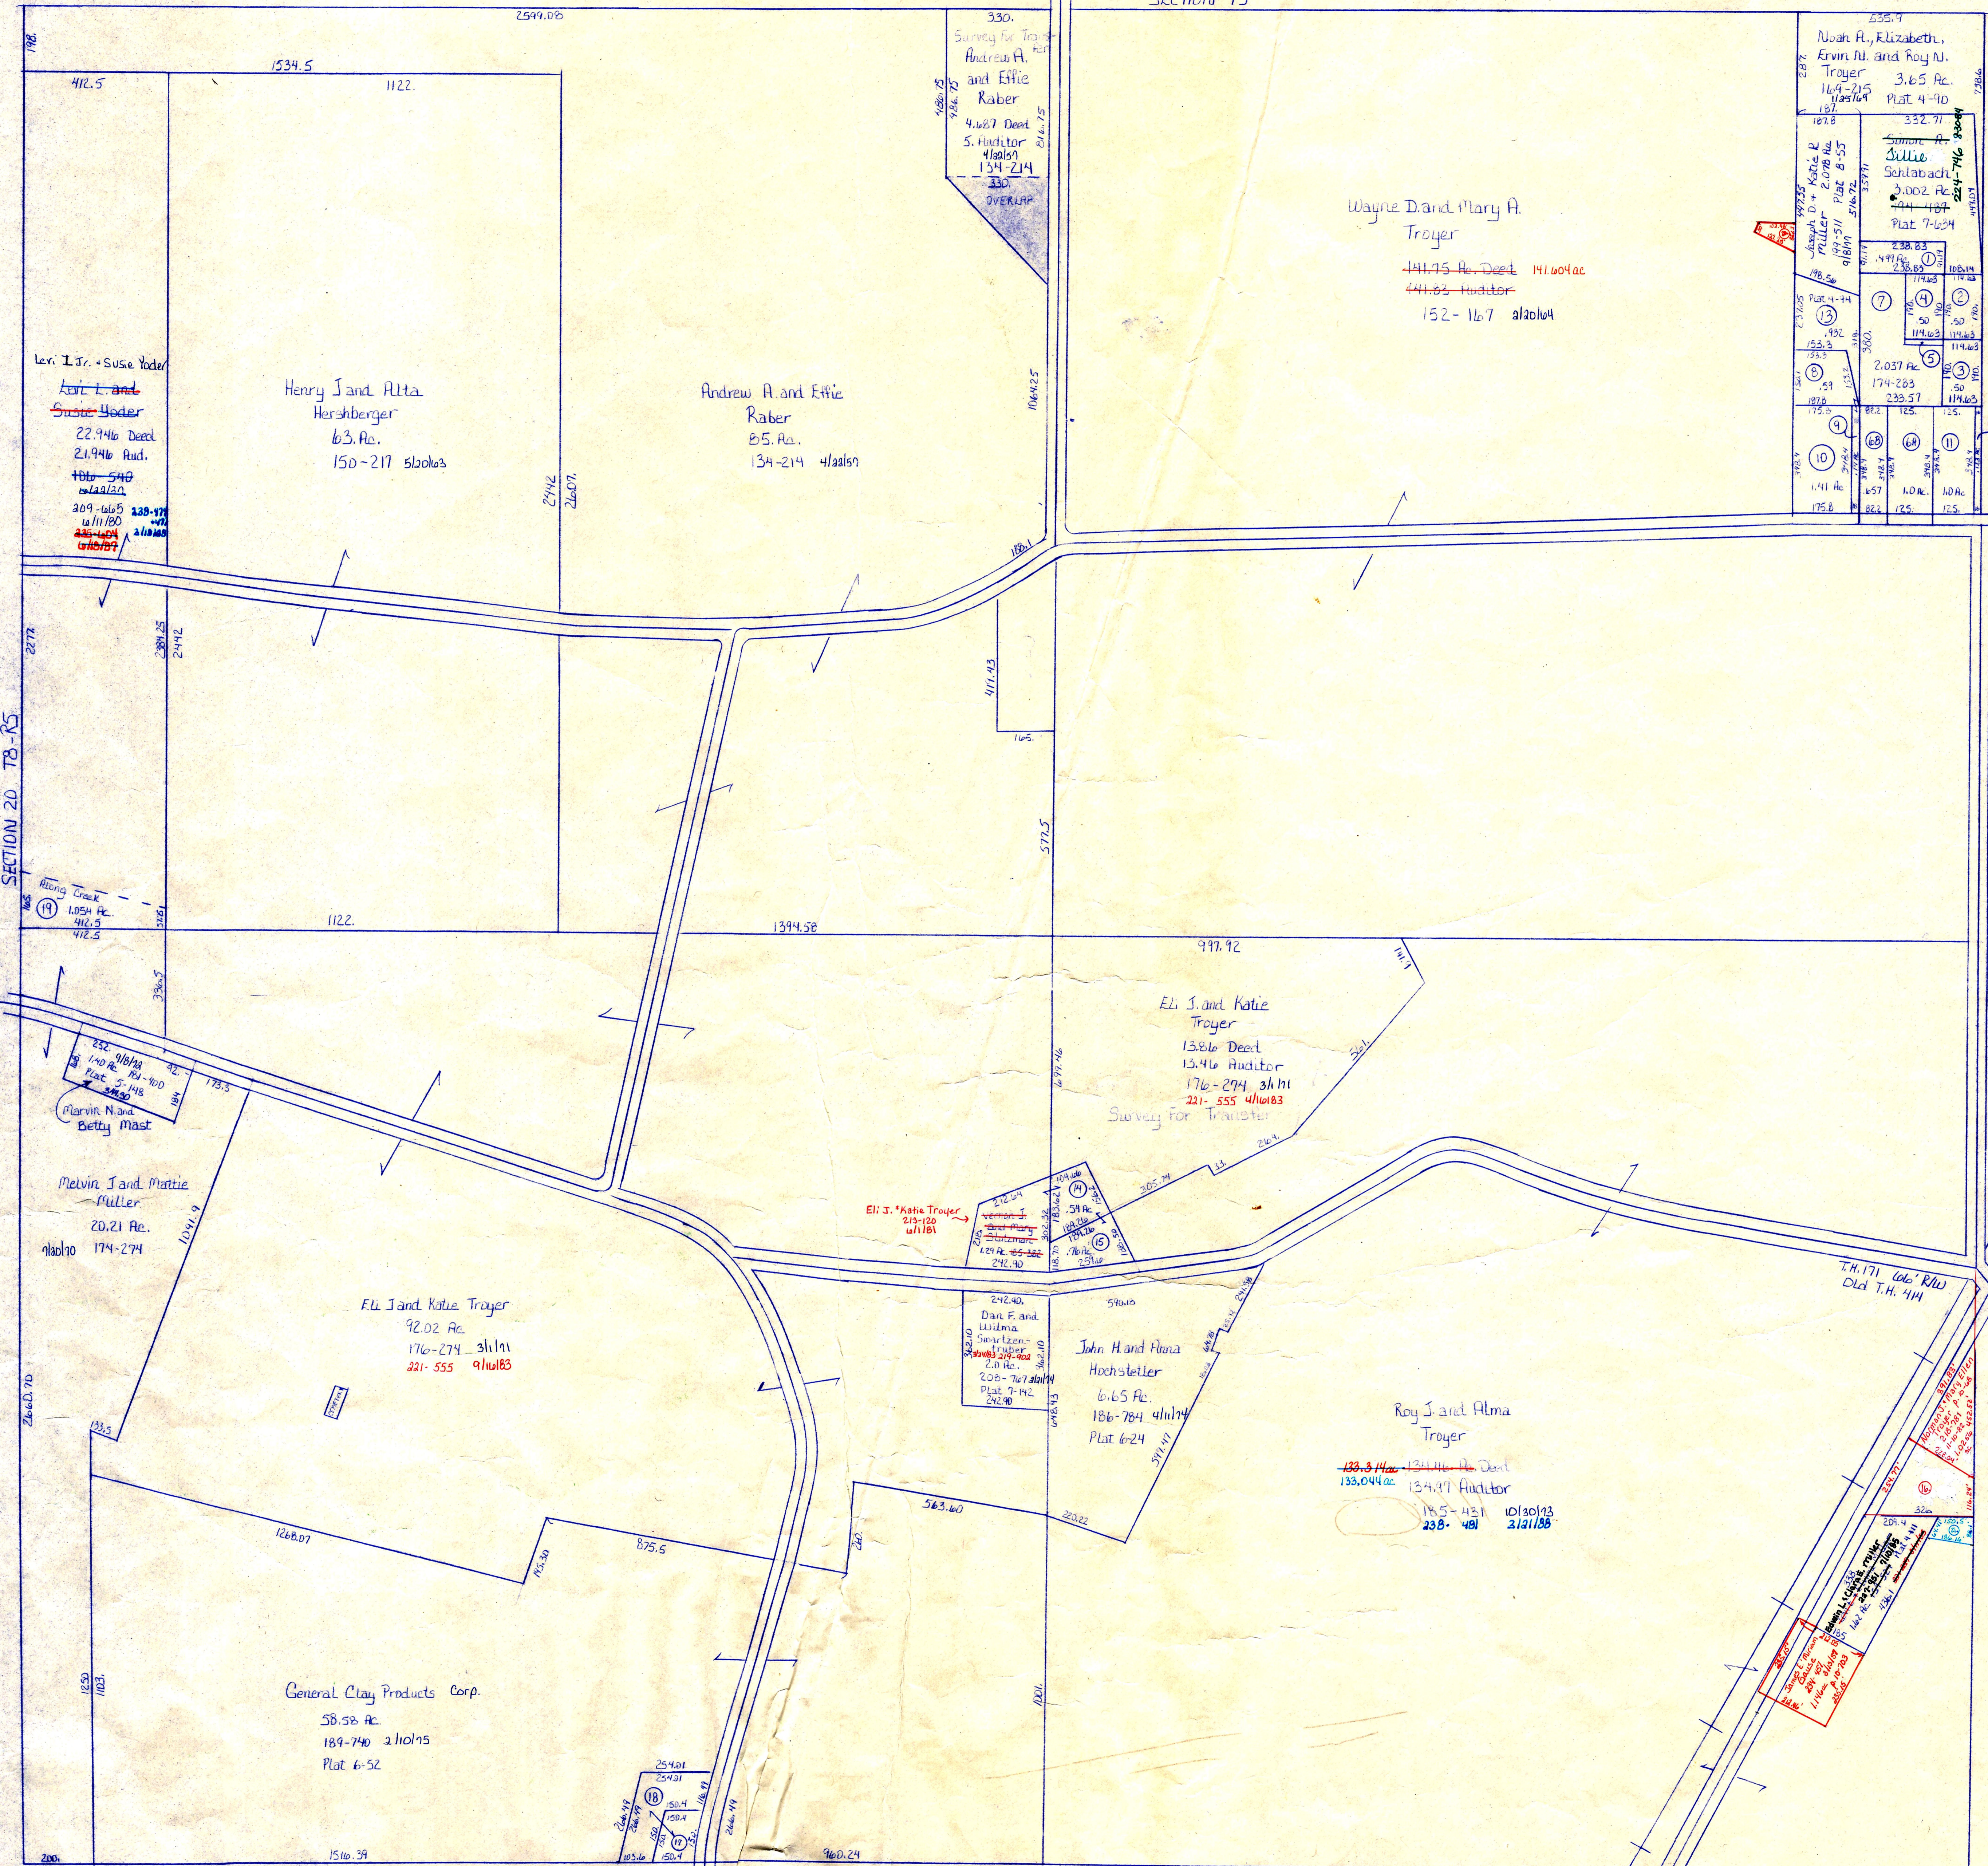




SECTION 25
C.H. 57 Old C.H. 557
60' R/W

① Joseph D. & Katie Miller 236-451 9/10/87 - Misc. p. 10-228
② Mrs. H. Ina S. Mast 238-447 1/10/88 - 27ac p. 10-243

T-8, R-4, Sec. 16
CLARK TWP.