


SECTION 5

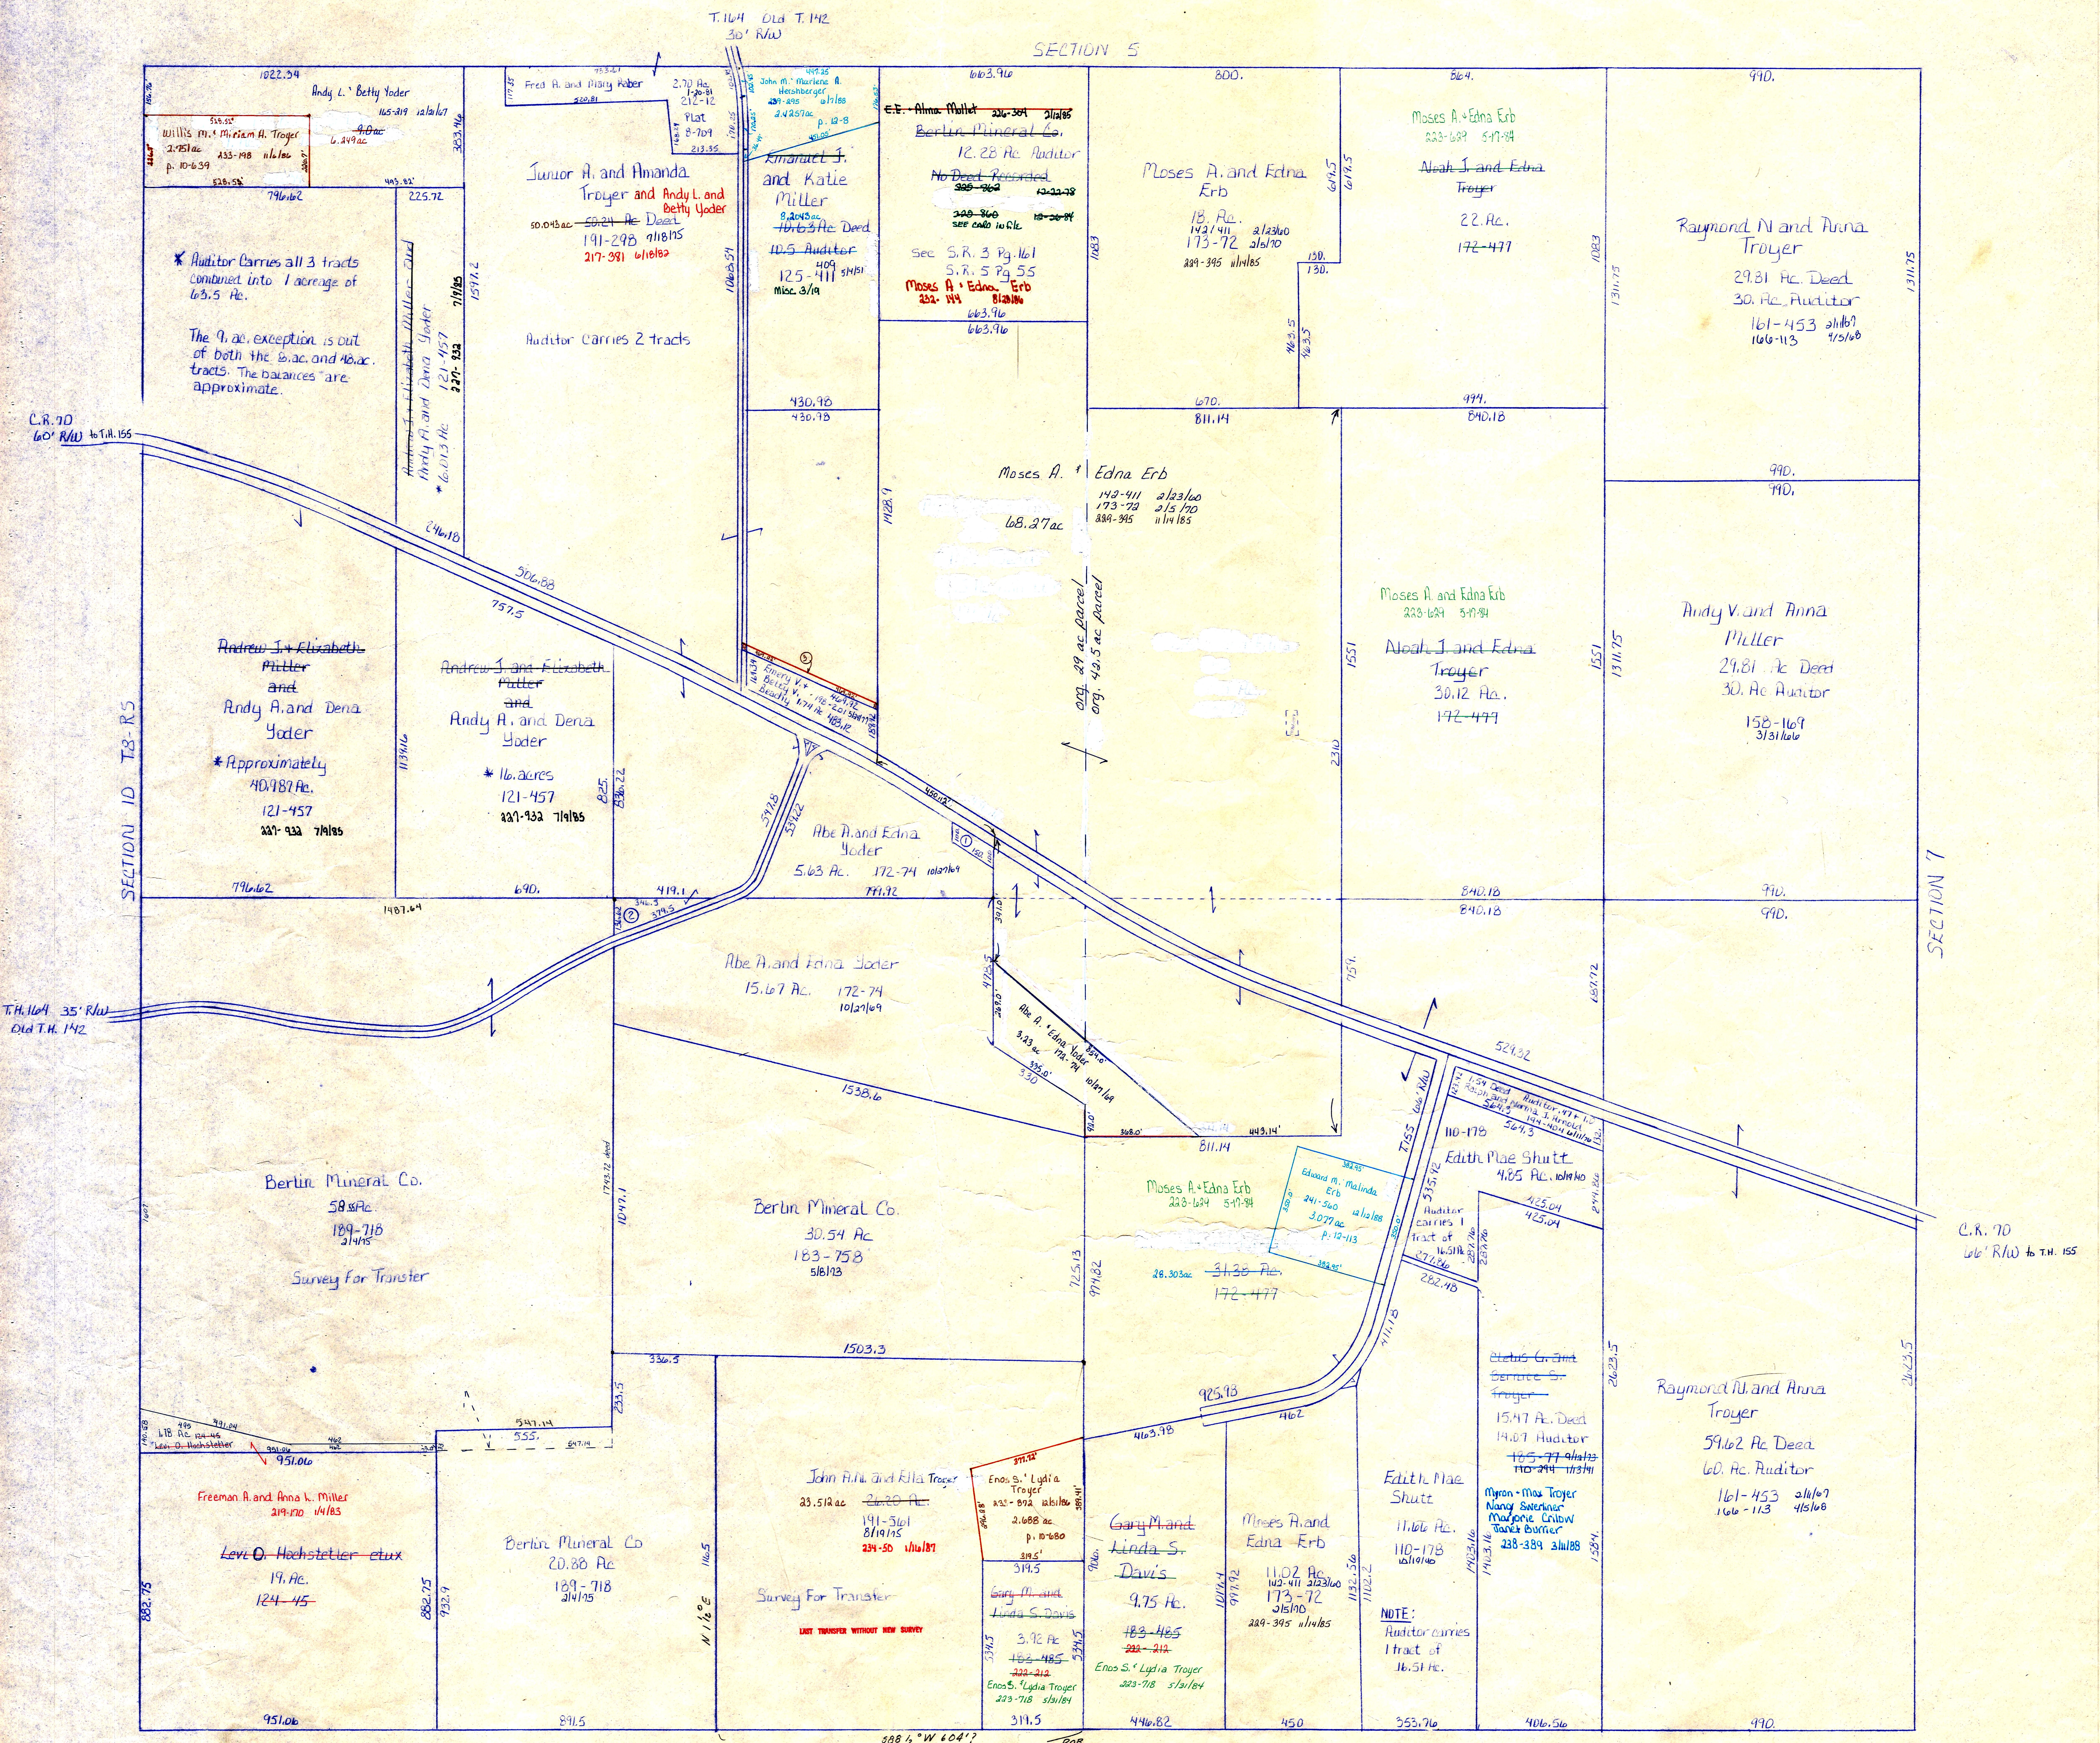

1. 34 4350123-577 Grover Jr. and Dorothy Yakley  
 2. 54 74875191-298 Junior A. and Amanda Troyer (Cords don't match deed)  
 4-18-82 217-381 and Andy L. and Betty Yoder

© Emery V. & Betty V. Beachy 223-106 10/21/66 .197 ac. p. 10-287

T-8, R-4, Sec. 6  
 CLARK TWP.