


T.H. 162 40' R/W
Old T.H. 137

SECTION 1

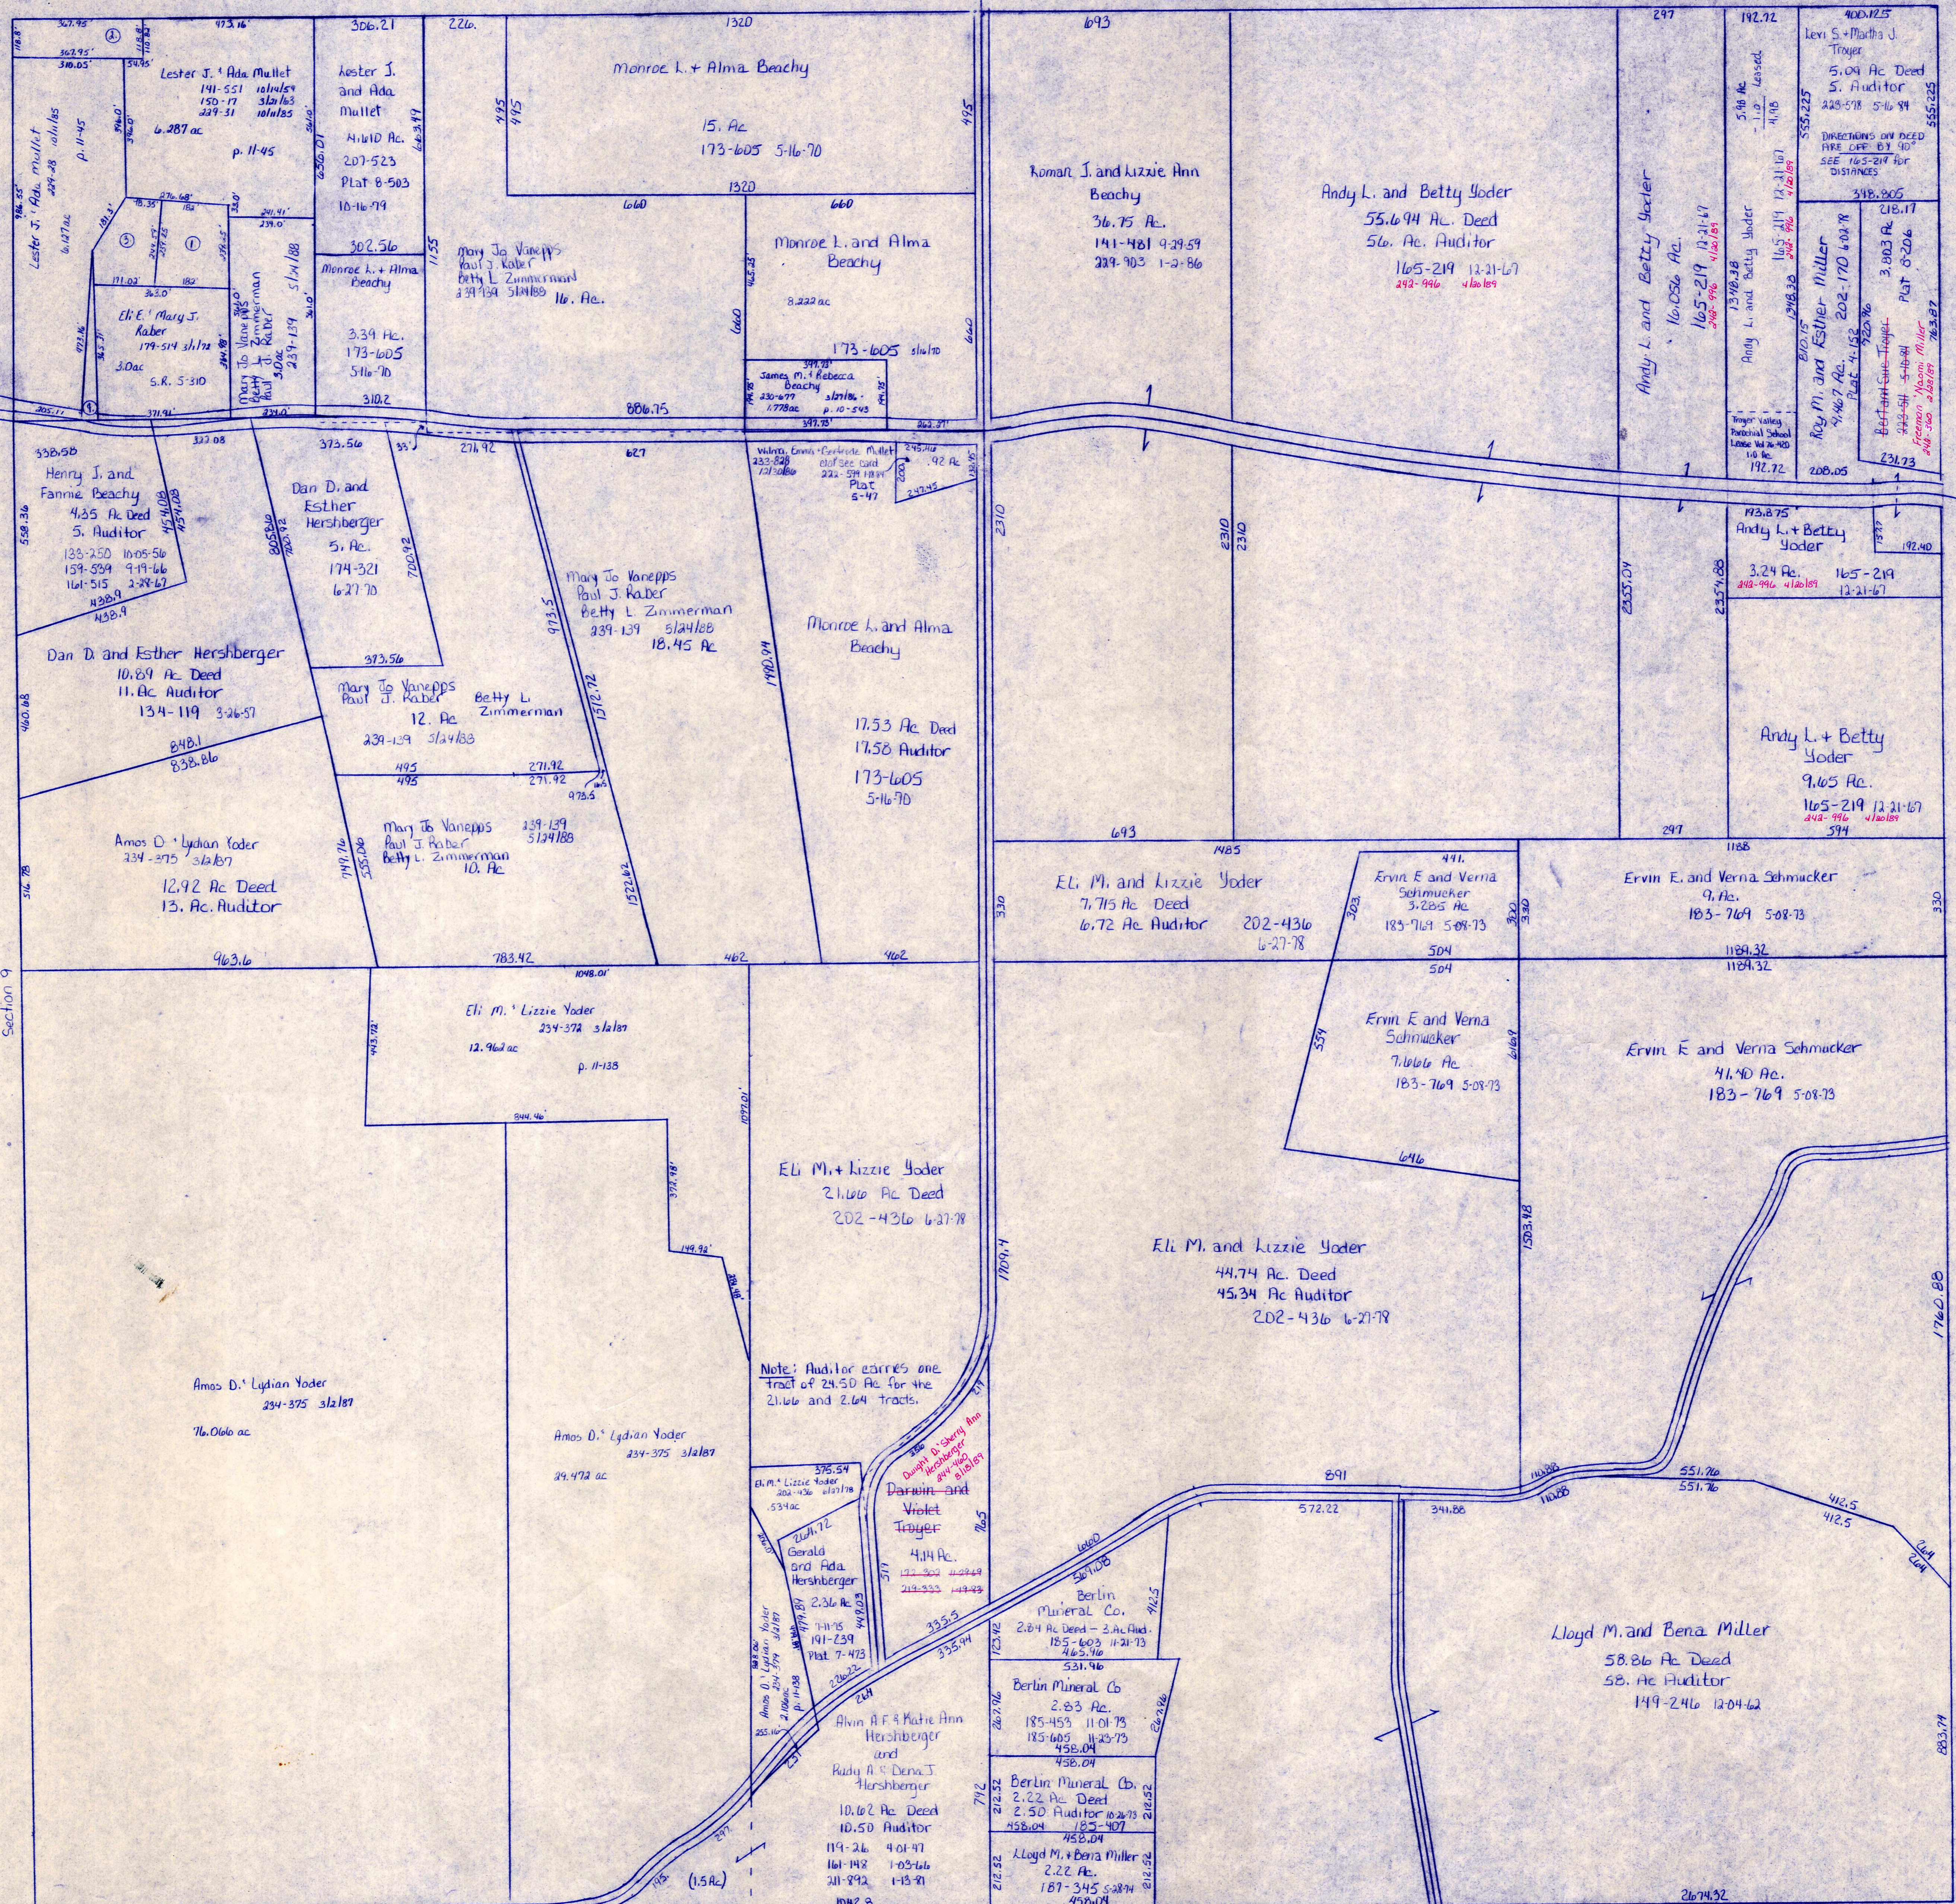

C.H. 70
60' R/W

C.H. 70
60' R/W

SECTION 8 T8-R4

T.H. 164 35' R/W
Old T.H. 142

SECTION 11

T.H. 165 35' R/W
Old T.H. 141

T.H. 164 40' R/W
Old T.H. 142

- ① Edwin D. Anna Troyer 225-762 whole 1.0 ac
- ② Christ McClellan Yoder 173-776 21-770, 221-522 whole, 225-261 whole 1.0 ac
- ③ Eli E. Mary J. Raber 279-26 whole, 185-89 ac p. 10-486
- ④ Eli E. Mary J. Raber 174-574 whole 78 ac

T-8, R-5, Sec. 10
CLARK TWP.
SCALE: 1"=200'

LET IT BE KNOWN, THIS MAP HAS BEEN PREPARED AS A REFERENCE GUIDE TO PROPERTY OWNERSHIP. WE BELIEVE THIS INFORMATION TO BE CORRECT AND CURRENT. HOWEVER, IT IS NOT INTENDED FOR ANY LEGAL USE, WHETHER IT BE IN SALES, TRANSFERS, TRUSTS, LEASES OF ANY TYPE, ETC., AND DO NOT ACCEPT RESPONSIBILITY FOR ERRORS OF ANY NATURE OR OMISSIONS CONTAINED HEREIN.