


1 SW	OSWALD	SHAWN E. AND JACQUELYN A.	256-114	7/5/92	12-975	1.201
2 NW	SCHLABACH	LARRY D. AND EUGENE E.	251-452	5/22/91	7-331	.724
3 SW	BARKMAN	MELVIN A. AND FANNIE	218-470	10/8/82	9-143	1.037
4 SW	SHETLER	PAUL D. AND MARY ANN	218-466	10/8/82	9-143	1.337
5 NW	SHETLER	PAUL D. AND MARY ANN	218-462	10/8/82	9-143	.878
6 NW	BARKMAN-SHETLER	MELVIN A. AND FANNIE Paul D. Mary Ann 218-478 11-154	104-109 208-879	6/8/73 9/28/87	11-154	.5058
7 NW	BARKMAN-SHETLER	MELVIN A. AND FANNIE Paul D. Mary Ann 218-478 11-154	104-120 208-879	6/8/73 9/28/87	11-154	.102


8 NW	YODER	MORRIS	225-777	7/2/87	10-774	1.3717
9 NW	YODER	MORRIS C. AND DORA A.	207-241 221-276	9/12/79 8/16/83	8-59	1.004
10 NW	BARKMAN	MELVIN A. AND FANNIE	194-129 226-570	6/5/73 9/28/87	11-154	.4577
11 NW	MILLER	MARGARET E.	175-593	12/24/70		.5
12 NW	KIEFFABER	NIWA L.	123-270 245-462	1/22/50 11/23/89		1.25
13 NW	KIEFFABER	NIWA L.	125-556	8/10/51		.045

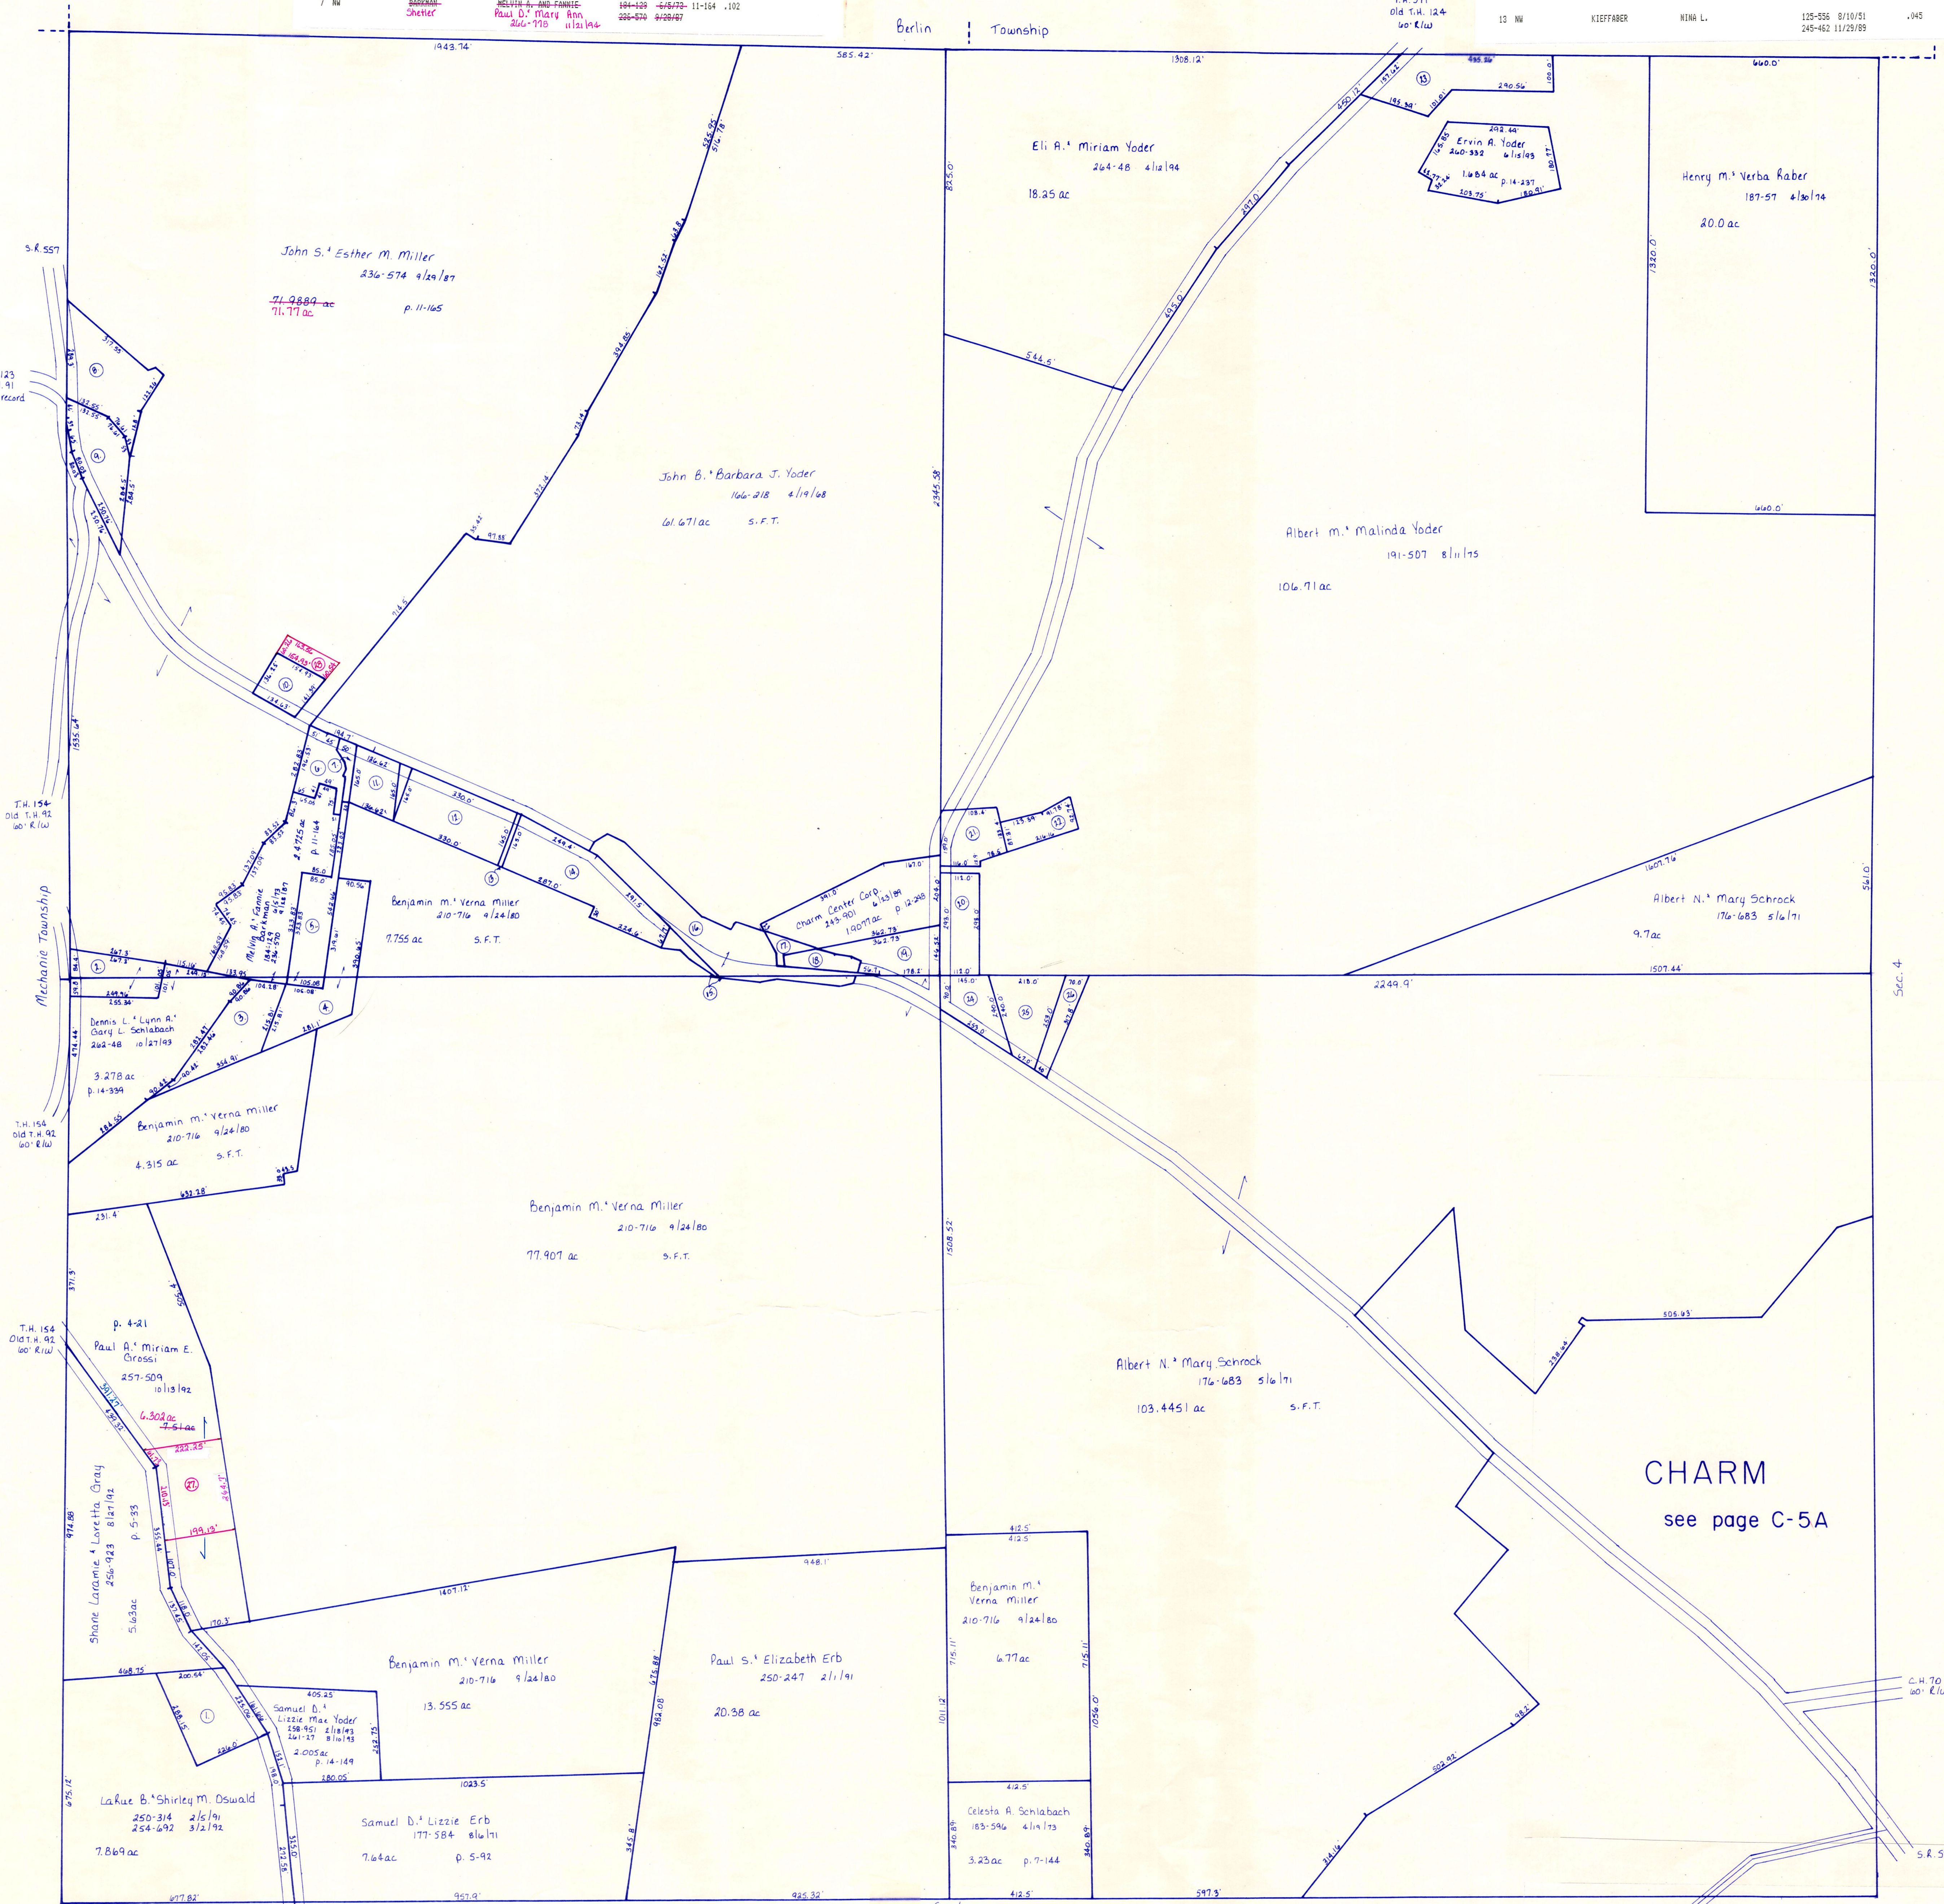

22 NE	MILLER	BEN D. AND ANNA	193-27	1/23/76	7-561	.409
23 NE	YODER	IVAN A. AND MARY ESTHER	242-589	3/16/89	12-167	1.357
24 SE	MAST	SUSIE E. AND MATTIE E. AND FANNIE E.	141-559 164-415 228-612 249-330	10/19/59 9/4/85 1/3/91		.5
25 SE	FARVER	DAVID E. AND OPAL JEAN	166-575	5/23/68		.79
26 SE	FARVER	DAVID E. AND OPAL JEAN	166-575	5/23/68		.150
27 SW	Hawkins	Robert F. III Marcia K.	266-389	10/14/94	14-628	1.308 ac
28 NW	Barkman	Melvin A. Fannie	266-384	8/20/94	14-633	.2189 ac
35 NW	Mast	Abraham J and Miller, Moses M	84-288 118-379	4/4/1918 1/20/1947		.06 ac relocated on 143-339

14 NW	YODER	ELI A.	177-886	8/6/71		1.58
15 SW	STATE	OF OHIO	258-589	1/13/33	2-225	.284
16 NW	STATE	OF OHIO	258-593	1/13/33	2-225	1.48
17 NW	STATE	OF OHIO	258-587	1/13/33	2-225	.1113
18 NW	STATE	OF OHIO	258-592	1/13/33	2-225	.226
19 NW	BAMPSEL	JANET M. AND PERRY L.	257-483	10/13/92		.734
20 NE	MAST	SUSIE E. AND MATTIE E. AND FANNIE E.	164-415 228-612 249-330	12/9/59 9/4/85 1/3/91	3-82	.75
21 NE	MILLER	BEN D. AND ANNA	152-254	3/13/84	4-16	.59

T-8, R-5, Sec. 5  
Clark Township  
Holmes County, Ohio scale: 1" = 200'

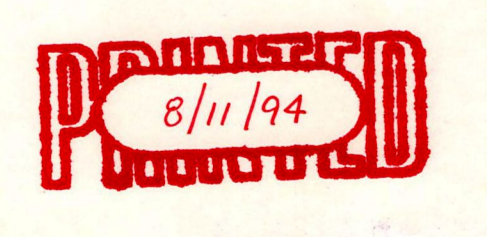

LET IT BE KNOWN, THIS MAP HAS BEEN PREPARED AS A REFERENCE GUIDE TO PROPERTY OWNERSHIP. WE BELIEVE THIS INFORMATION TO BE CORRECT AND CURRENT. HOWEVER, IT IS NOT INTENDED FOR ANY LEGAL USE, WHETHER IT BE IN SALES, TRANSFERS, TRADES, LEASES OF ANY TYPE, ETC., AND DO NOT ACCEPT RESPONSIBILITY FOR ERRORS OF ANY NATURE OR OMISSIONS CONTAINED HEREIN.

C-5