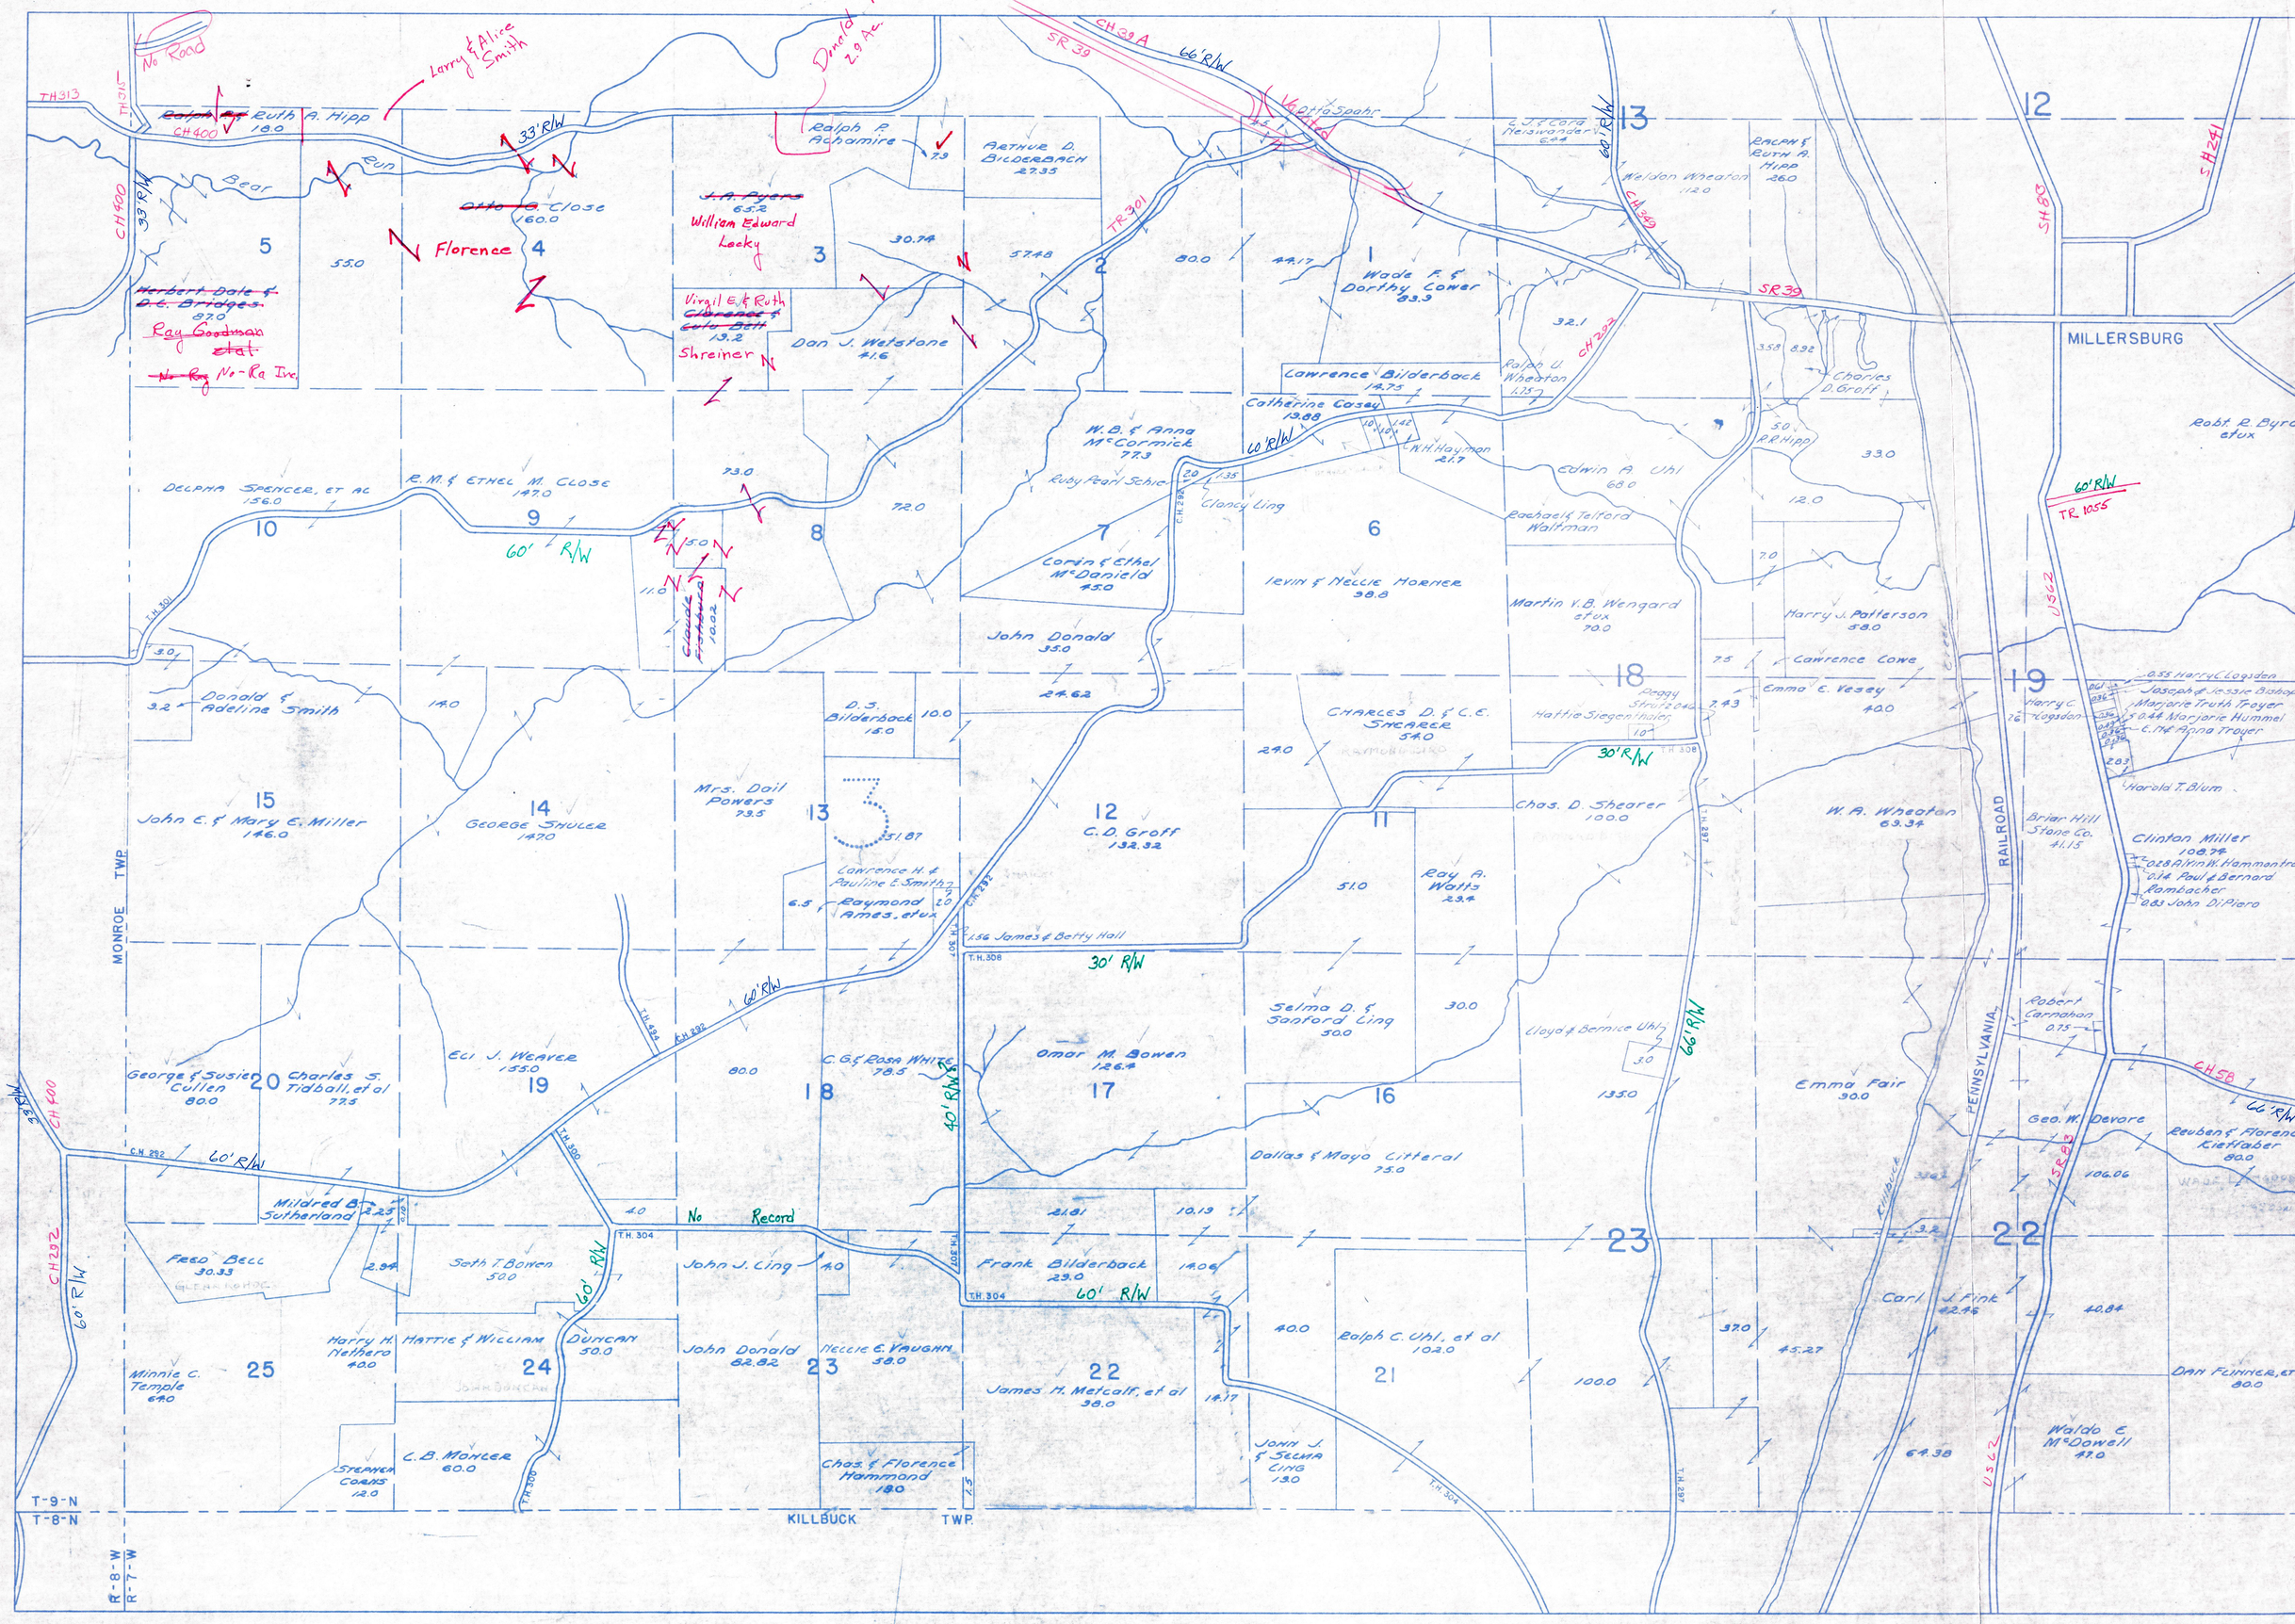
HOLMES COUNTY
HARDY TOWNSHIP
SOUTH PART
SCALE: 1" = 650'
Base map dated circa 1947
Date unknown for items marked in RED
MILLERSBURG
MONROE TWP.
KILLBUCK TWP.
PENNSYLVANIA RAILROAD
No Road
Larry & Alice Smith
Donald McCormick 2.9 Ac.
Ralph & Ruth A. Hipp 18.0
Ralph P. Achamire
Arthur D. Bilderbach 27.35
Otto A. Close 160.0
Florence
J.A. Byers 65.2
William Edward Lecky
Virgil E. & Ruth Shreiner 13.2
Dan J. Weatstone 41.6
Herbert Dale & D.E. Bridges 87.0
Ray Goodman et al.
No-Ra Inc.
Wade R. & Dorthy Cower 83.3
Otto Spahr
L.J. & Cora Reisvander 6.44
Weldon Wheaton 11.20
Ralph & Ruth A. Hipp 26.0
Lawrence Bilderback 14.75
Catherine Casey 13.88
Ralph U. Wheaton 1.75
Charles D. Groff
R.R. Hipp
Robt. R. Byrd etux
W.B. & Anna McCormick 71.3
Ruby Pearl Schic
Clancy Ling
N.H. Hayman 21.7
Edwin A. Uhl 68.0
Rachael & Telford Waltman
R.M. & Ethel M. Close 147.0
Delpha Spencer, et ac 156.0
Corbin & Ethel McDaniel 45.0
Levin & Nellie Horner 38.8
Martin V.B. Wengard etux 70.0
Harry J. Patterson 58.0
Lawrence Cowe
Emma E. Vesey 40.0
John Donald 35.0
Donald & Adeline Smith
D.S. Bilderback 18.0
Charles D. & C.E. Shearer 54.0
Hattie Siegenthaler
Chas. D. Shearer 100.0
W.A. Wheaton 69.34
Harold T. Blum
Clinton Miller 108.74
Briar Hill Stone Co. 41.15
John C. & Mary E. Miller 146.0
George Shuler 147.0
Mrs. Dail Powers 73.5
Lawrence H. & Pauline E. Smith
Raymond Ames, et ux
C.D. Groff 132.32
Ray A. Watts 23.4
James & Betty Hall
Selma D. & Sanford Ling 30.0
Lloyd & Bernice Uhl
Robert Carnahan 0.75
George & Susie Cullen 80.0
Charles S. Tidball, et al 72.5
Eli J. Weaver 135.0
C.G. & Rosa White 78.5
Omar M. Bowen 126.4
Emma Fair 30.0
Geo. W. Devore
Reuben & Florence Kiefaber 80.0
Dallas & Mayo Citteral 75.0
Mildred B. Sutherland
No Record
Feed Bell 30.33
Seth T. Bowen 50.0
John J. Ling
Frank Bilderback 23.0
Carl J. Fink 42.46
Harry H. Nethero 40.0
Hattie & William Duncan 50.0
John Donald 82.82
Neccie E. Vaughn 38.0
James H. Metcalf, et al 38.0
Ralph C. Uhl, et al 102.0
Minnie C. Temple 6.40
C.B. Mohler 60.0
Stephen Corns 12.0
Chas. & Florence Hammond 1.80
John J. & Selma Ling 1.30
Waldo E. McDowell 47.0
Dan Funner, et 80.0
Joseph & Jessie Bishop
Marjorie Truth Troyer
Marjorie Hummel
Anna Troyer
Harry C. Logsden
Paul & Bernard Rambacher
John Di Piero
Alvin W. Hammond
Harry Close
Glenn Horne
John Duncan
Raymond Ward
T-9-N
T-8-N
R-8-W
R-7-W
June 1947