


Prairie Township

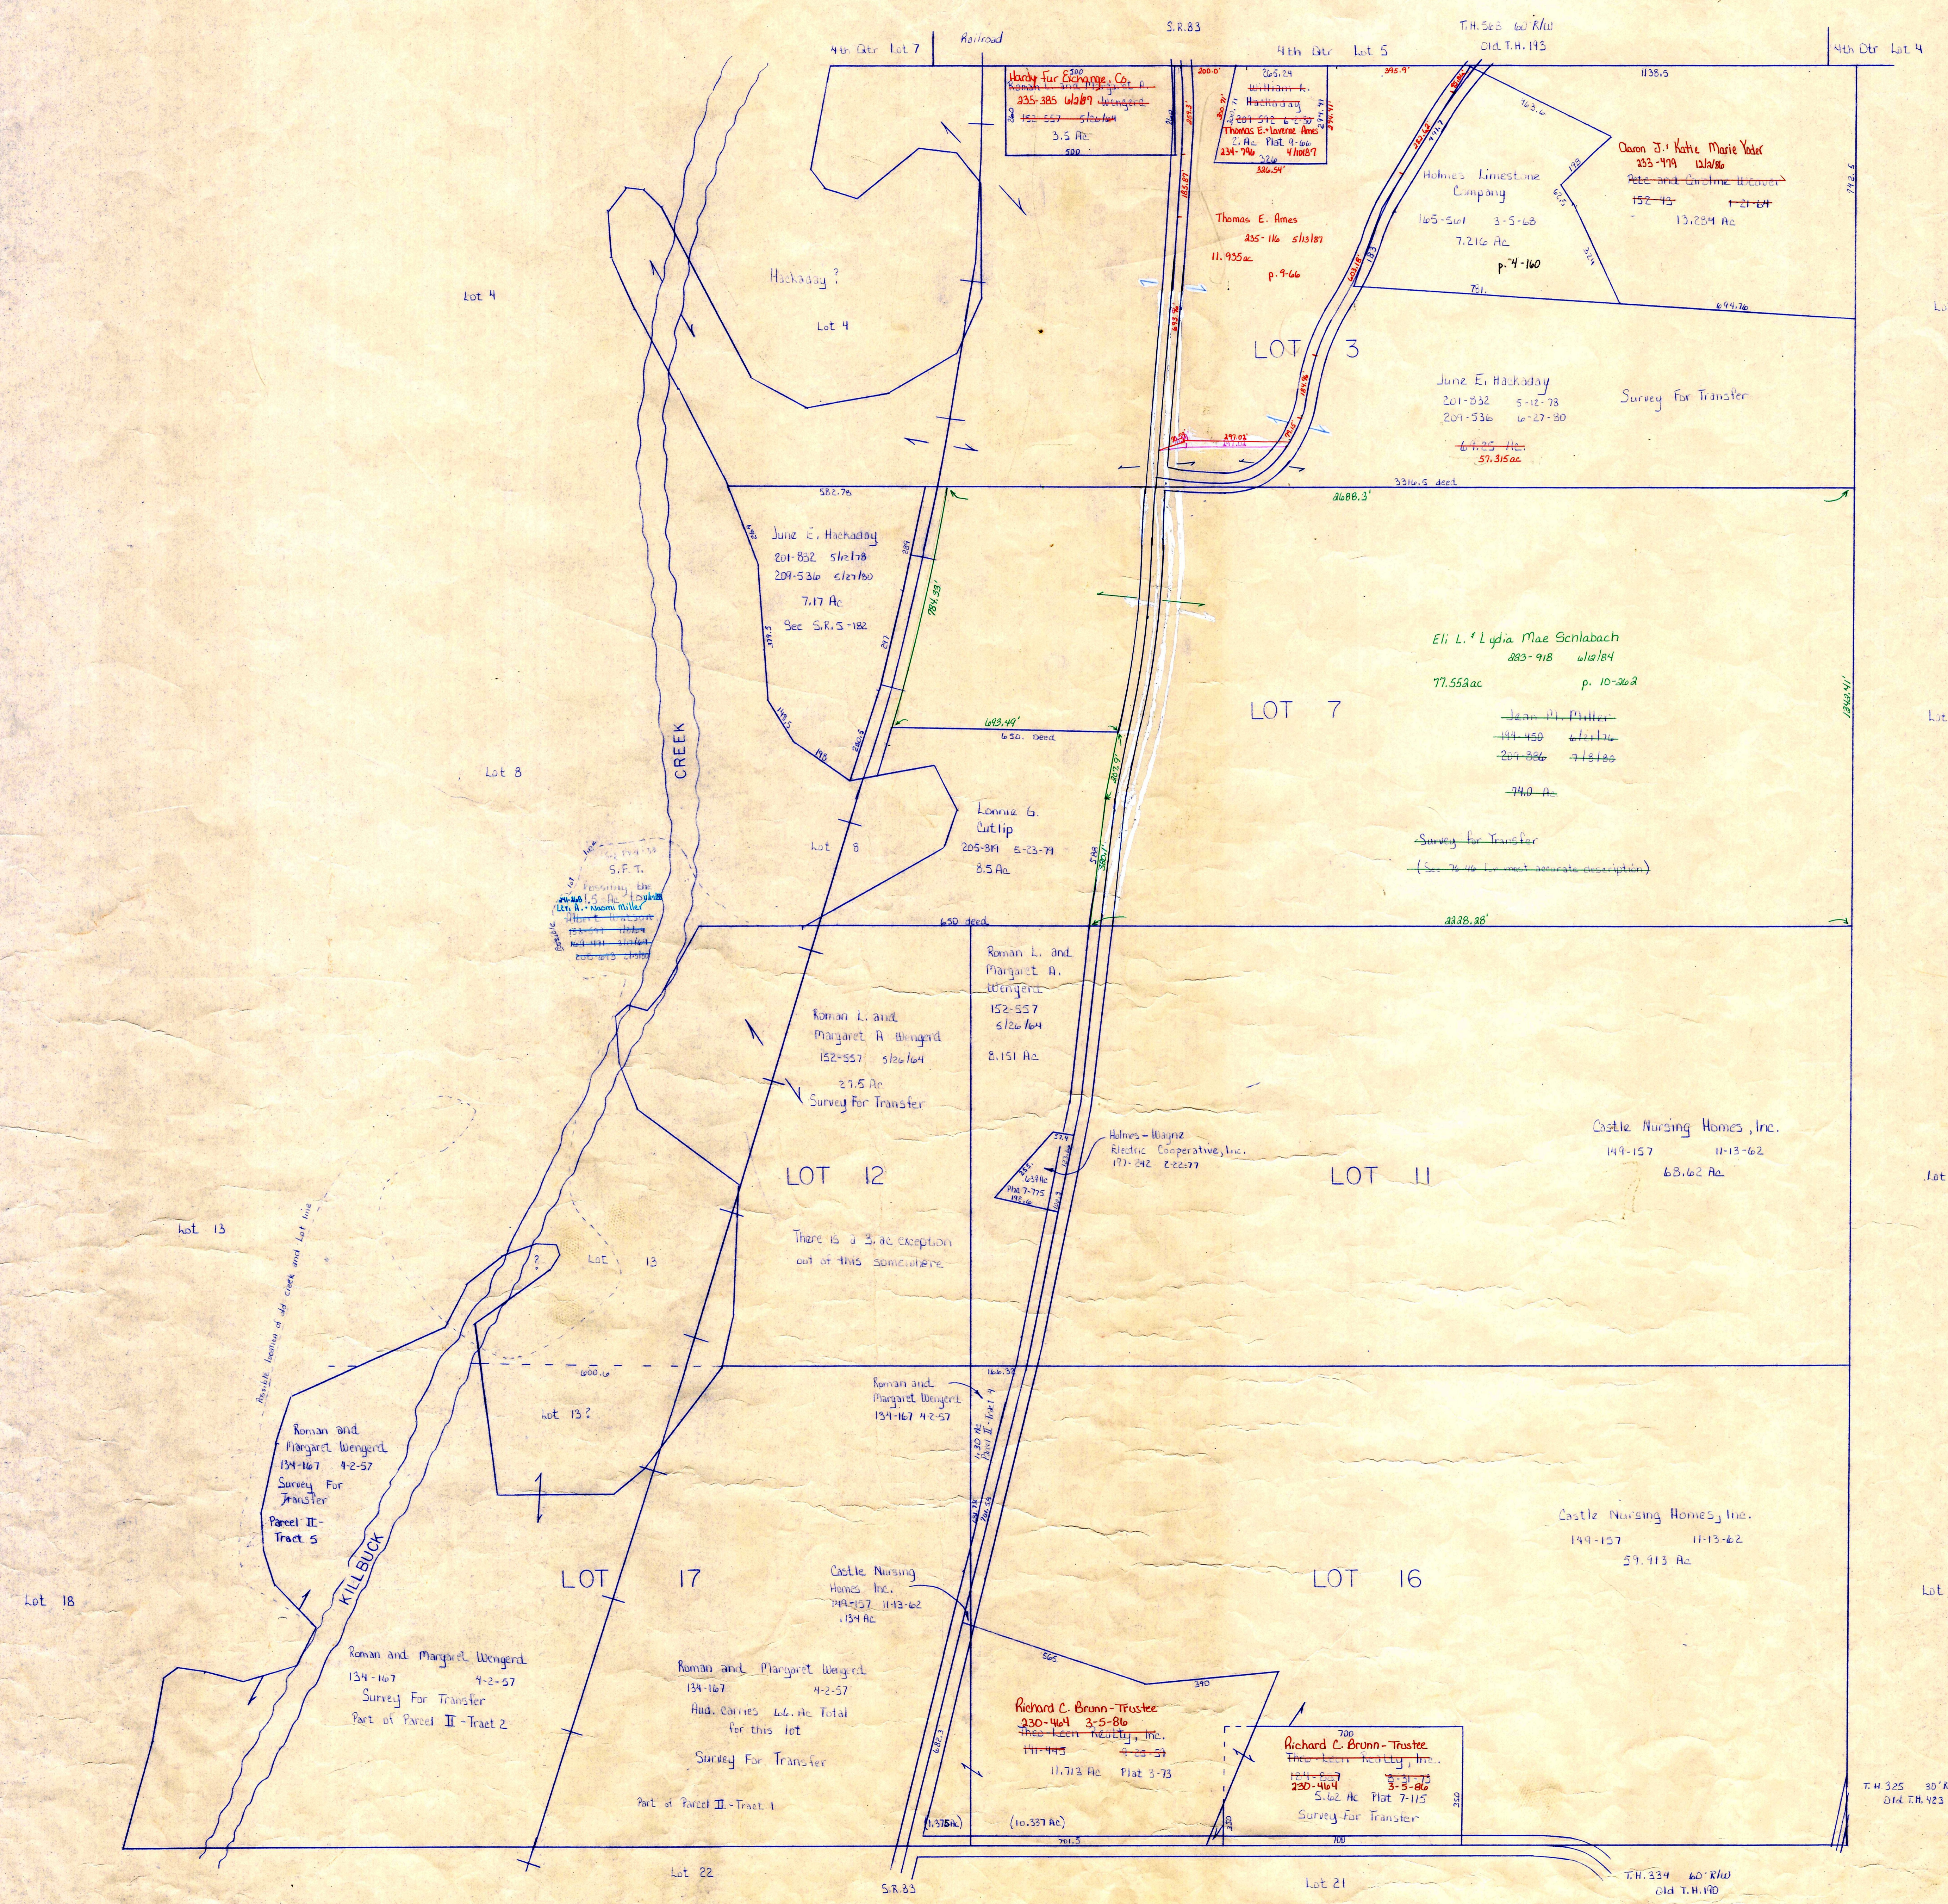

T-9, R-7, 1st Qtr.
 Lots 3, 7, 11, 12, 16, 17
 HARDY TWP.
 SCALE 1" = 200'

H-24