


PRairie TWP.

T.H. 326 40' R/W  
Old T.H. 144

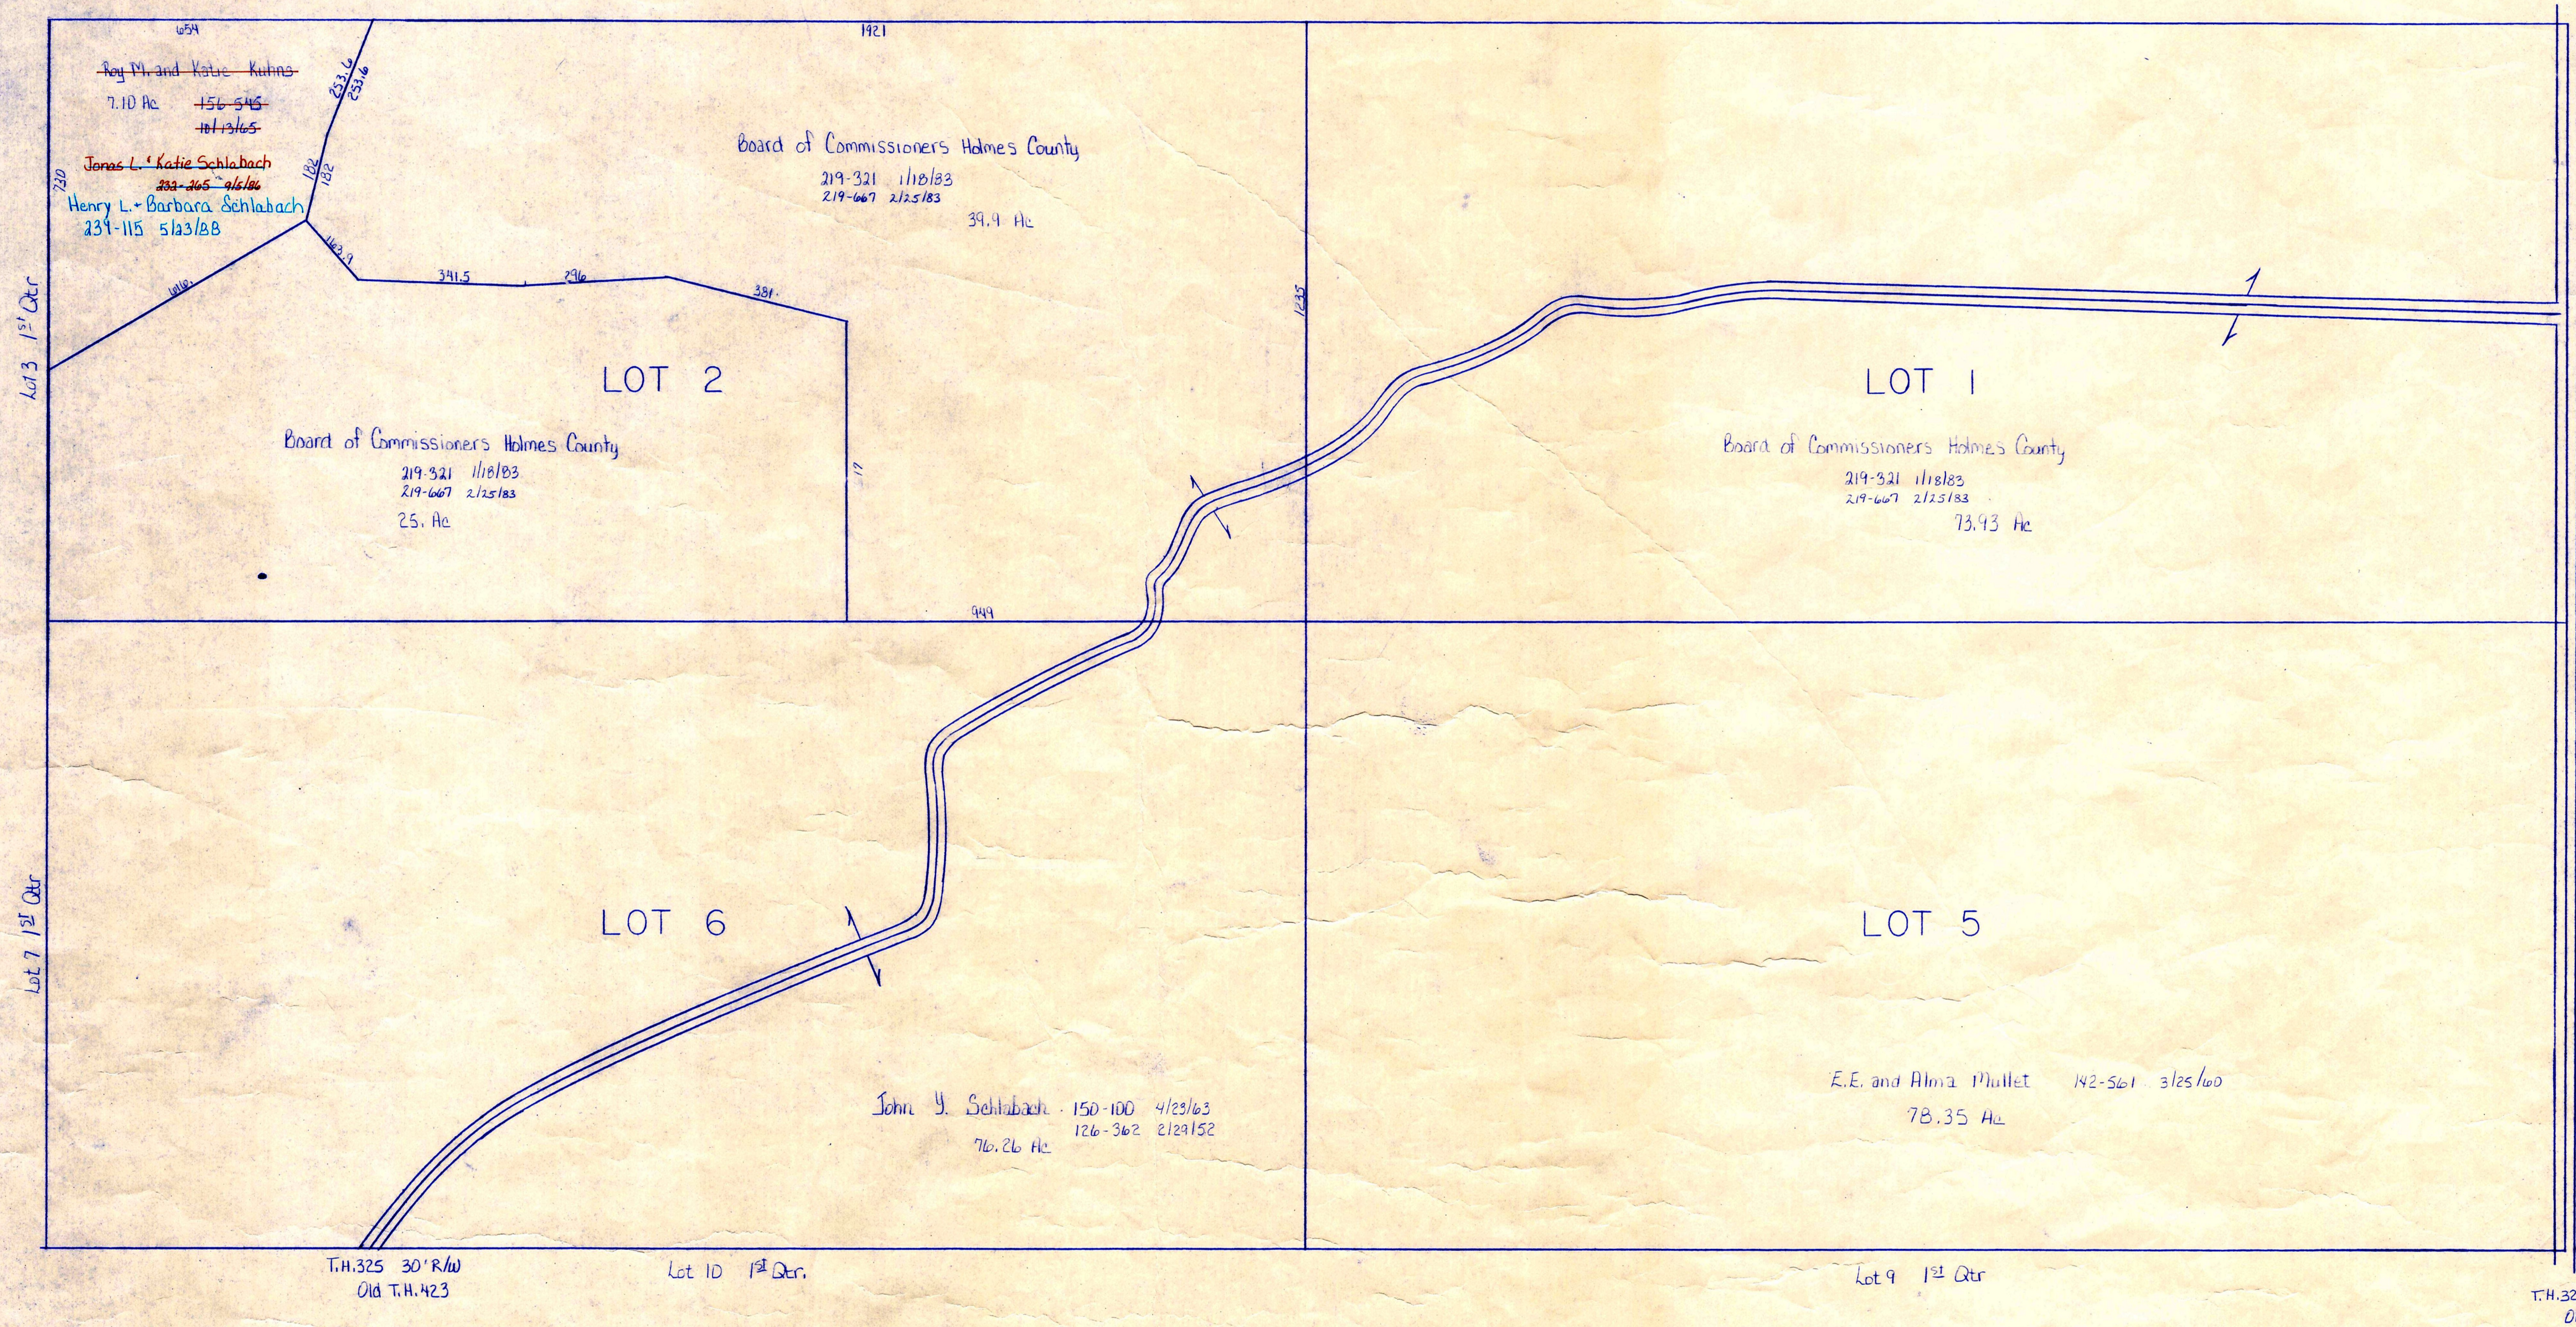

T-9, R-7, 1st Qtr.  
Lots 1, 2, 5, 6  
HARDY TWP.

