


- Ⓐ .24 ac Gerald L. and Waneta Carter P. 4-66 217-679 1/14/82
- Ⓑ .73 ac Gerald L. and Waneta Carter P. 4-44 217-679 7/19/82
- Ⓒ .23 ac Gary and Alice Snodgrass P. 8-89 200-210 10/28/77
- Ⓓ .23 ac Gary and Alice Snodgrass P. 8-89 200-210 10/28/77
- Ⓔ .23 ac Gary and Alice Snodgrass P. 8-89 200-210 10/28/77
- Ⓕ .43 ac Gary and Alice Snodgrass P. 8-89 200-210 10/28/77
- Ⓖ .50 ac Edward D. and Loraine F. Geisenheimer P. 7-65 184-344 10/19/73
- Ⓗ .10 ac Moses R. Yoder P. 7-508 191-666 8/21/75 and 216-674 4/5/82
- Ⓘ Abe L. Frances A. Mast 235-787 7/18/81 .878 ac p. 10-776
- Ⓢ Abe L. Frances A. Mast 235-787 7/18/81 .758 ac p. 10-776

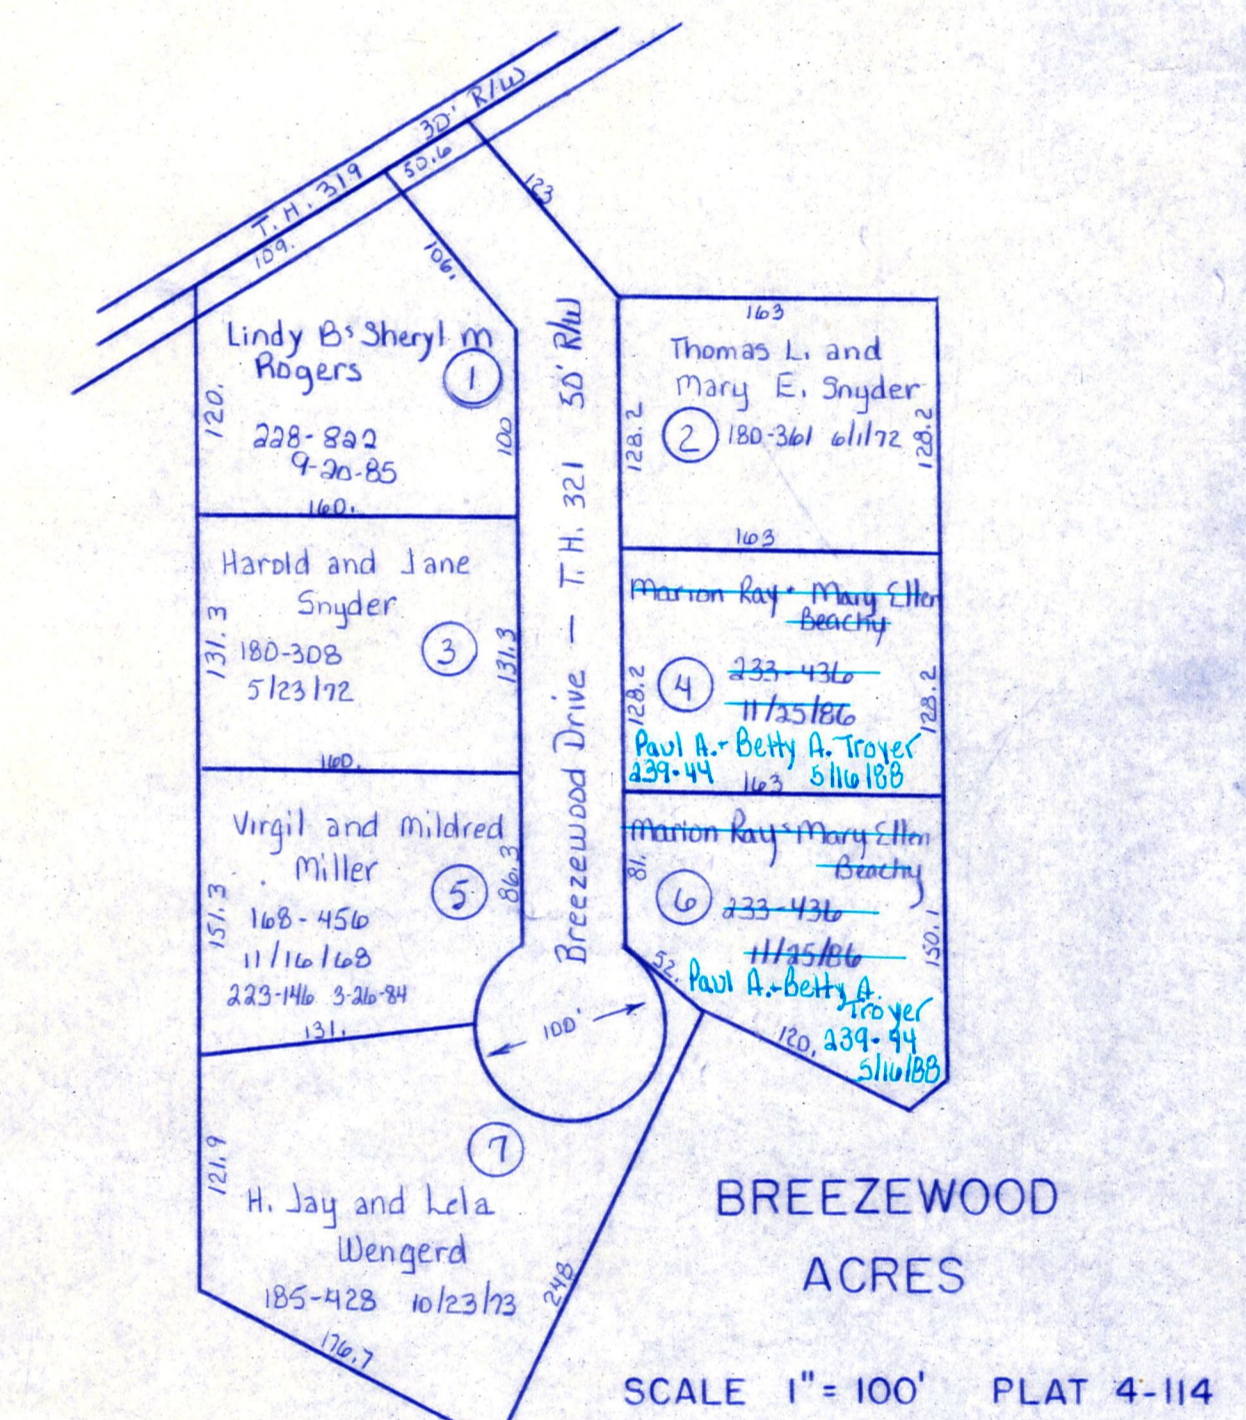

See H-27A  
For Detailed Map

LET IT BE KNOWN, THIS MAP HAS BEEN PREPARED AS A REFERENCE GUIDE TO PROPERTY OWNERSHIP. WE BELIEVE THIS INFORMATION TO BE CORRECT AND CURRENT, HOWEVER, IT IS NOT INTENDED FOR ANY LEGAL USE, WHETHER IT BE IN SALES, TRANSFERS, TRADES, LEASES OF ANY TYPE, ETC., AND DO NOT ACCEPT RESPONSIBILITY FOR ERRORS OF ANY NATURE OR OMISSIONS CONTAINED HEREIN.

T-9, R-6, Sec. 15  
HARDY TWP.  
SCALE 1"=200'

PRINTED 10-20-87

H-333