


- (A) .1824 ac (Calculated) Eastland Development Company, Inc. S.F.T. 15B-482 6/2/66
- (B) .070 ac P. 6-21 Patrick W. Roche 231-108 5/16/80 232-410 4/18/80
- (C) 2.0488 ac P. 2-153 Eastland Development Company, Inc. 15B-482 6/2/66 (all road R/W) S.F.T. See C.J. 24, Pg. 576
- (D) .4402 ac P. 2-153 Eastland Development Company, Inc. 15B-482 6/2/66 (all road R/W) S.F.T. See C.J. 24, Pg. 576
- (E) .5465 ac P. 2-153 Eastland Development Company, Inc. 15B-482 6/2/66 (all road R/W) S.F.T. See C.J. 24, Pg. 576
- (F) .1377 ac (Calculated) Eastland Development Company, Inc. (Private Dr. by Highland Overlook) 15B-482 6/2/66 S.F.T.
- (G) William E. Barbara E. Mast 238-962 5/5/88 .032 ac p. 10-952 237-11 5/10/88
- (H) William E. Barbara E. Mast 238-962 5/5/88 .028 ac p. 10-952 237-11 5/10/88
- (J) William E. Barbara E. Mast 238-962 5/5/88 .053 ac p. 10-952 237-11 5/10/88
- (K) Hilltop Acres Allotment P. 2-133 Lot 14 Re-Platted P. 5-5
- (L) Highland Overlook Allotment P. 2-174
- (M) North Star Enterprises, Inc. 231-306 5/30/86 2.368 ac p. 4-111 5-106 S.F.T.
- (N) North Star Enterprises, Inc. 231-306 5/30/86 .096 ac p. 4-111 S.F.T.
- (O) Roy E. Weaver 244-731 4/18/89 .089 ac p. 12-293

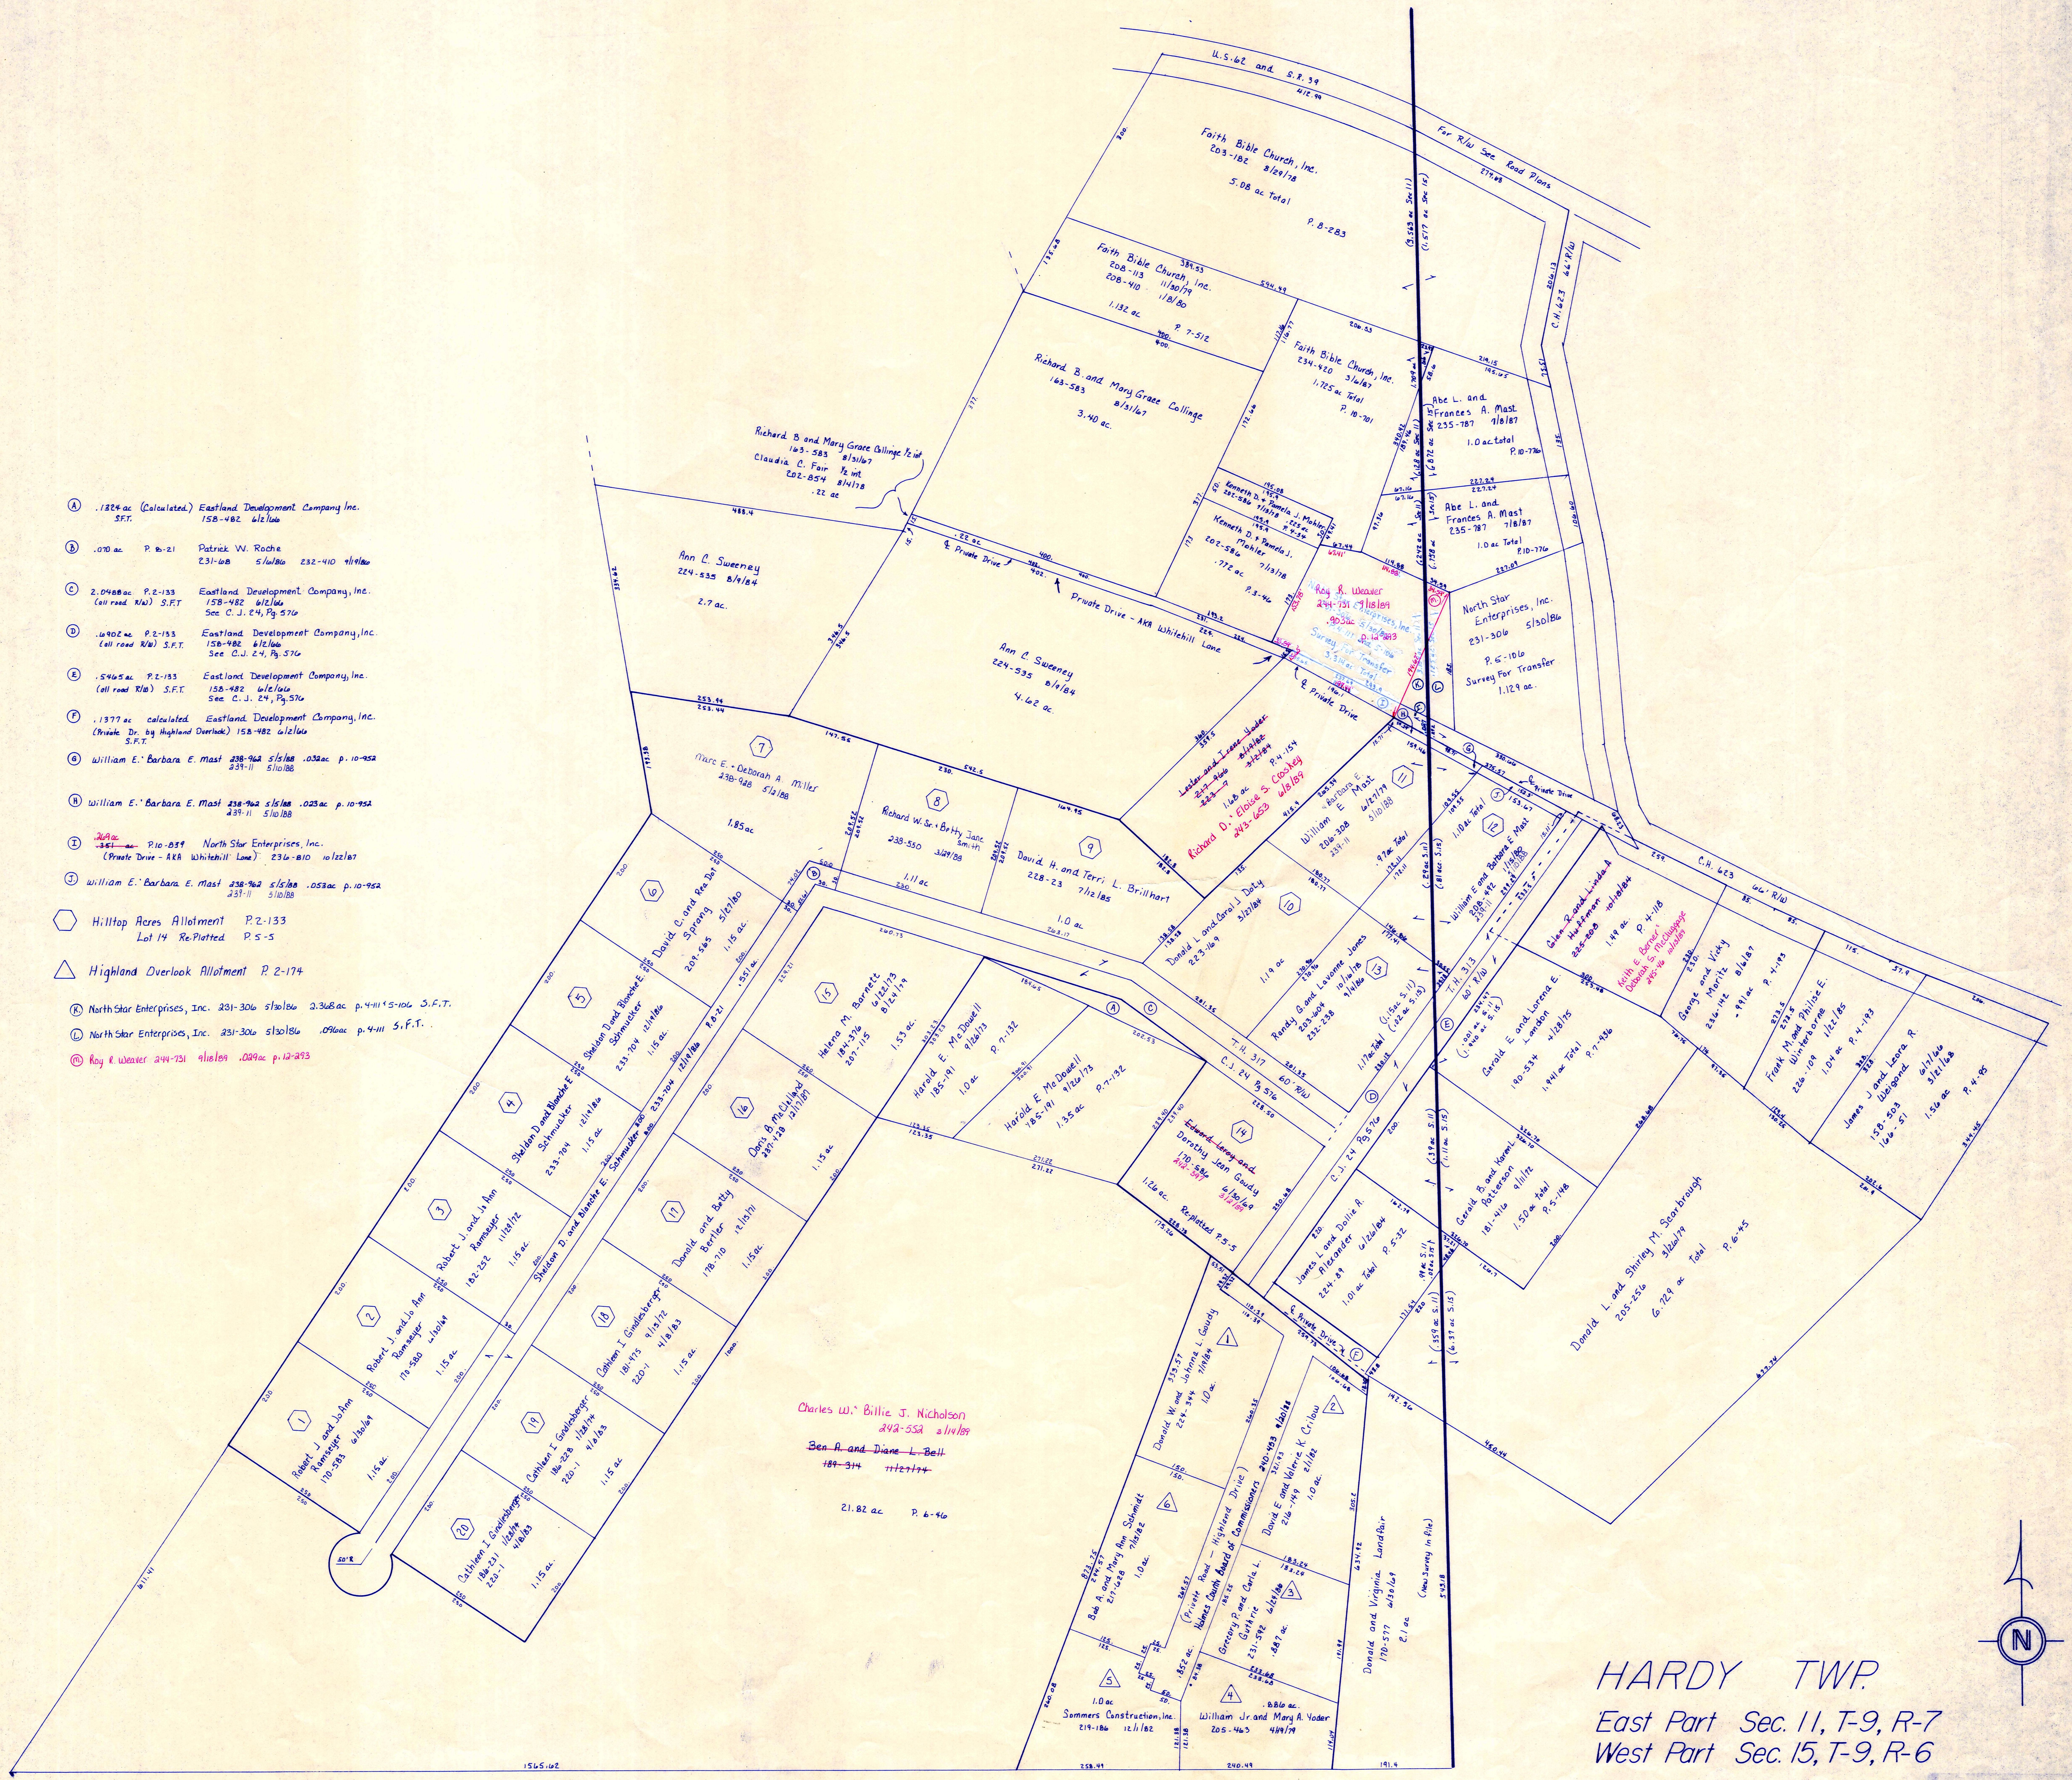

HARDY TWP.
 East Part Sec. 11, T-9, R-7
 West Part Sec. 15, T-9, R-6


H-27A