


- ① Timothy E. McDowell  
of 15-524 election 067ac p. 14-841
- ② P. B. 21 East T. 9, R. 6, S. 14  
- ⑦ Lee N. Alma R. Keyse 264-257 election 028ac p. 10-288
- ⑩ Hilltop Acres Allotment P. 2-133 platted 34.6 ac  
Lot 14 Re-platted P. 5-5 H-27B
- ⑪ Highland Overlook Allotment P. 2-174  
Platted 41.180 H-27B

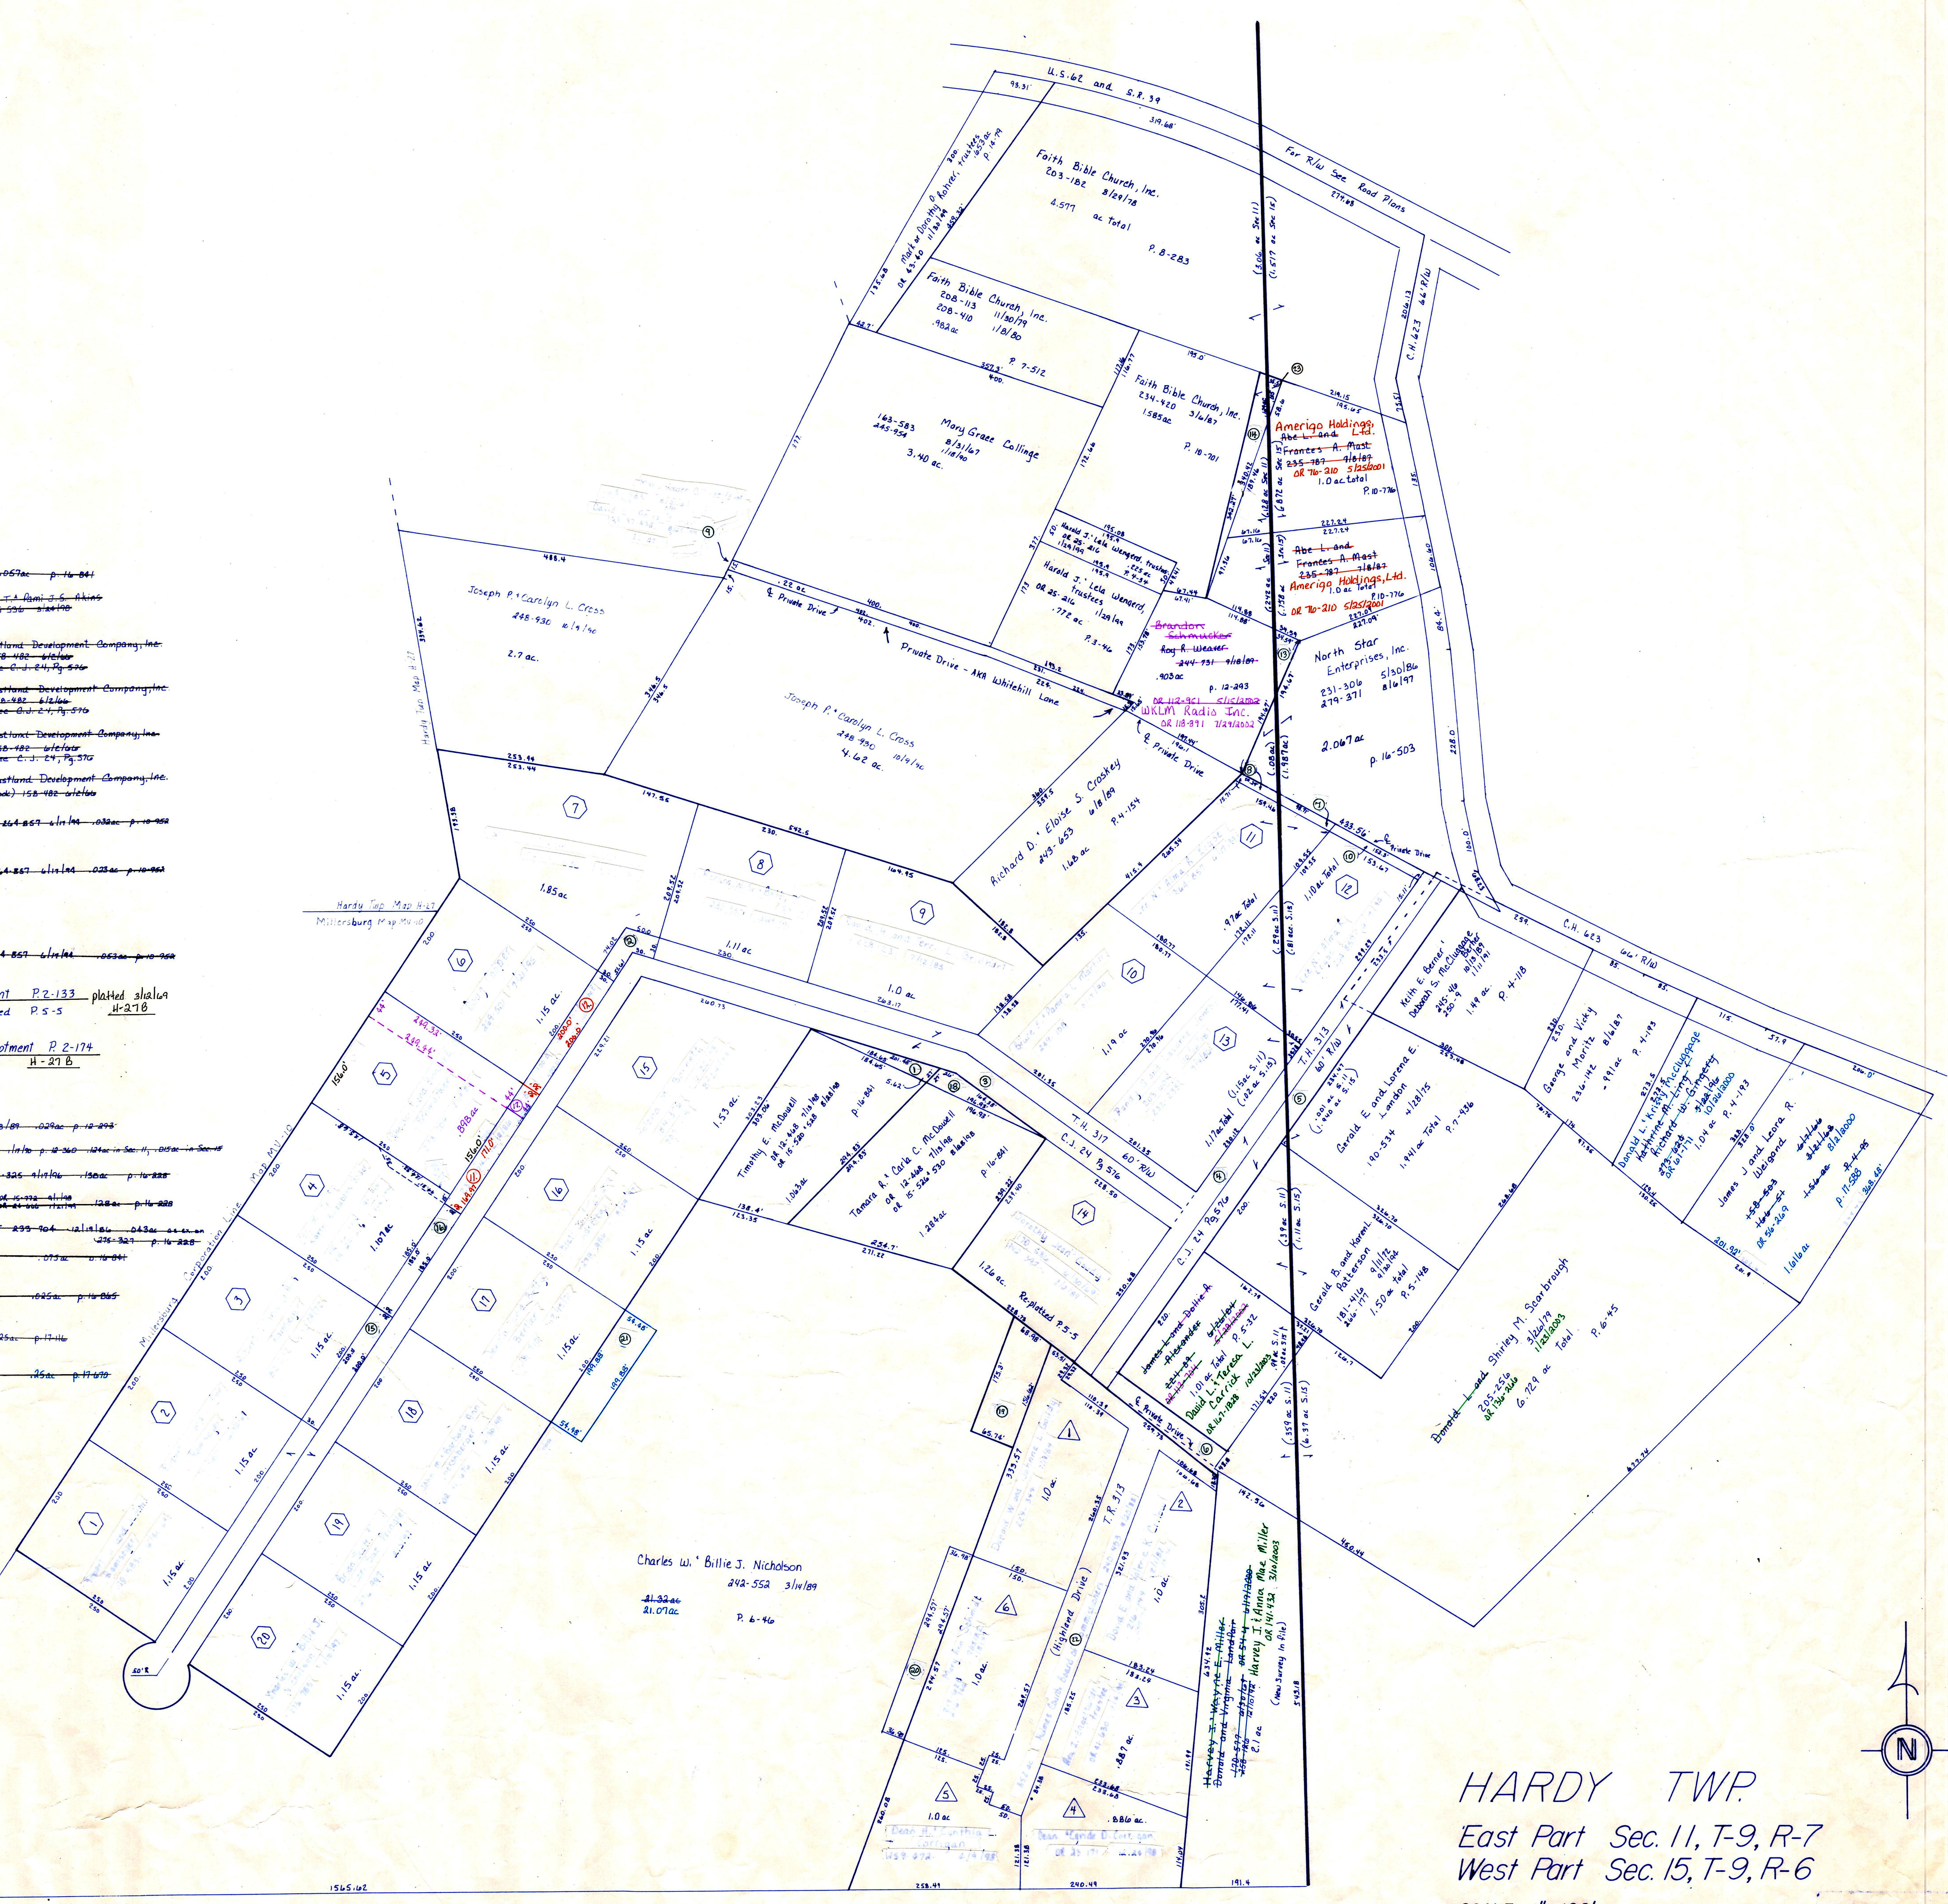

**HARDY TWP**  
 East Part Sec. 11, T-9, R-7  
 West Part Sec. 15, T-9, R-6  
 SCALE 1" = 100'

LET IT BE KNOWN, THIS MAP HAS BEEN PREPARED AS A REFERENCE GUIDE TO PROPERTY OWNERSHIP. WE BELIEVE THIS INFORMATION TO BE CORRECT AND CURRENT, HOWEVER, IT IS NOT INTENDED FOR ANY LEGAL USE, WHETHER IT BE IN SALES, TRANSFERS, TRADES, LEASES OF ANY TYPE, ETC., AND DO NOT ACCEPT RESPONSIBILITY FOR ERRORS OF ANY NATURE OR OMISSIONS CONTAINED HEREIN.

**H-27A**