



△ Duncan Allotment No. 1  
 Part 15-4 planted 6/14/15 H-32A  
 Leroy A. Duncan & Marie E. Semko  
 201-333-31474, 202-18-11188, 201-280-31483,  
 201-303-10113/13

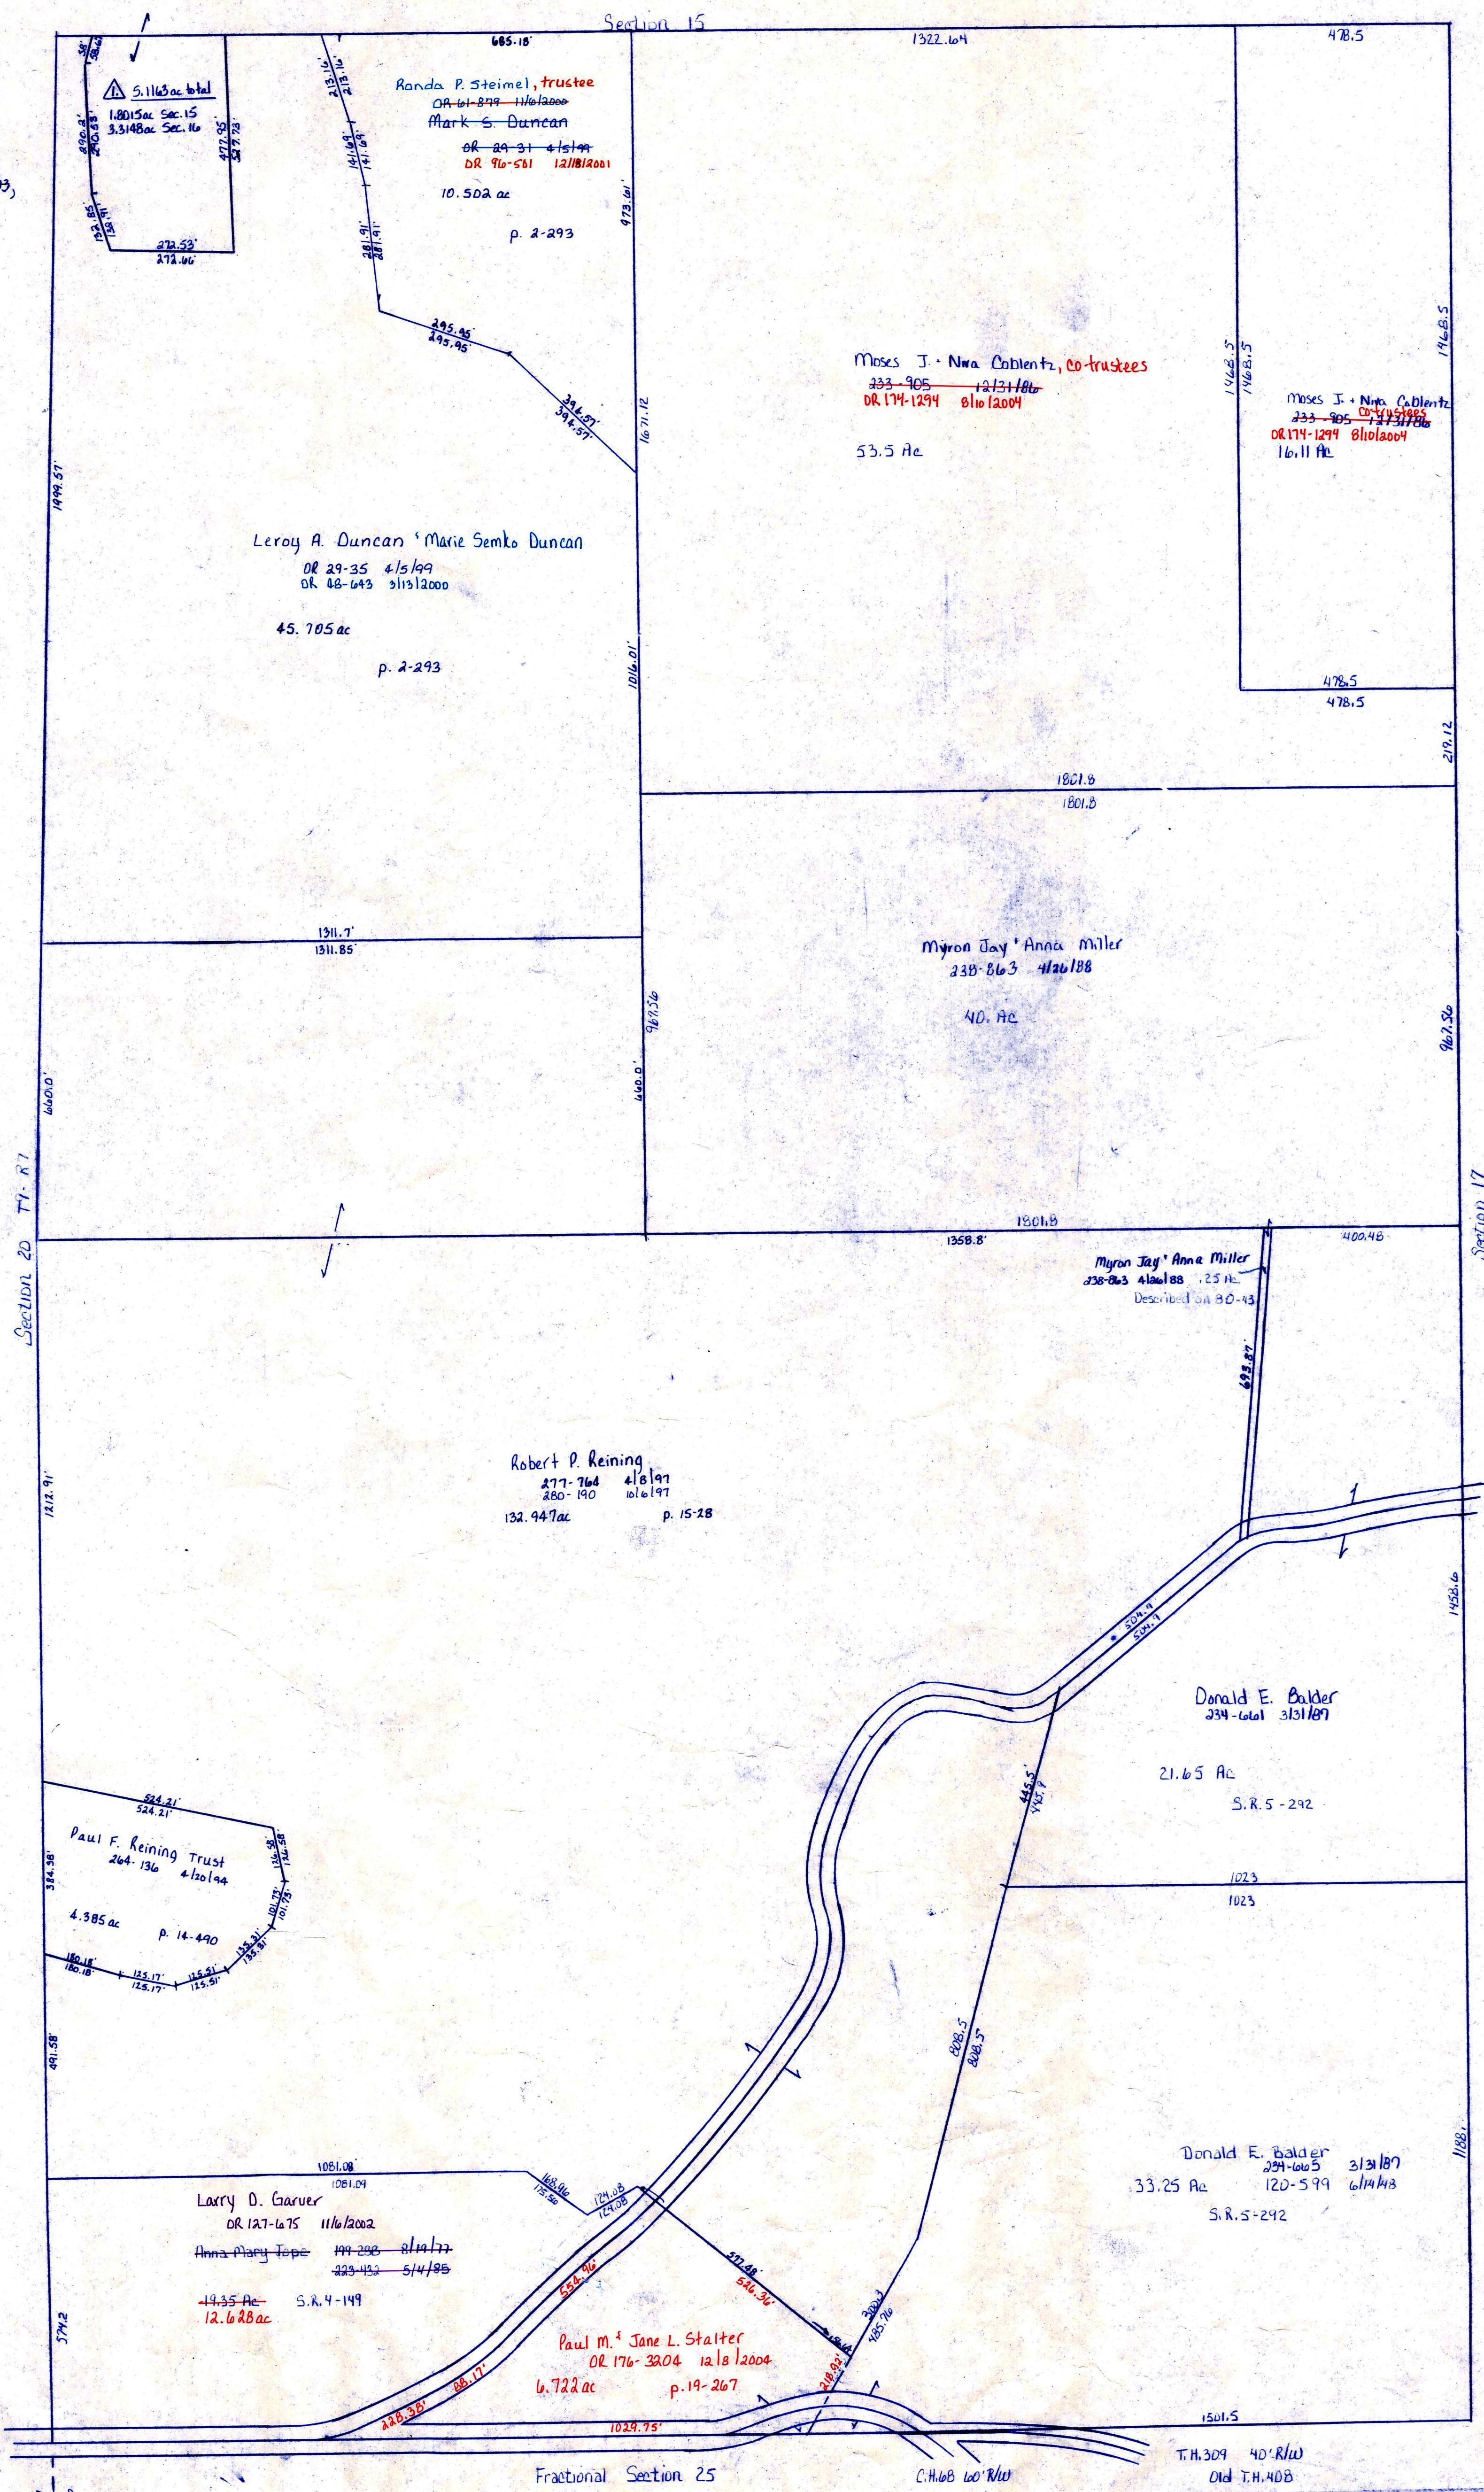

T.H. 310 40' R/W  
Old T.H. 199

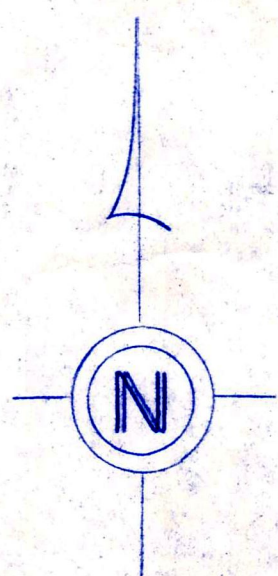

LET IT BE KNOWN, THIS MAP HAS BEEN PREPARED  
 AS A REFERENCE GUIDE TO PROPERTY OWNERSHIP.  
 WE BELIEVE THIS INFORMATION TO BE CORRECT  
 AND CURRENT, HOWEVER, IT IS NOT INTENDED  
 FOR ANY LEGAL USE, WHETHER IT BE IN SALES,  
 TRANSFERS, TRADES, LEASES OF ANY TYPE, ETC.,  
 AND DO NOT ACCEPT RESPONSIBILITY FOR ERRORS  
 OF ANY NATURE OR OMISSIONS CONTAINED HEREIN.

T-9, R-6, Sec. 16  
 HARDY TWP.  
 SCALE 1" = 200'