


T.H. 107  
T.H. 285 (old rd)  
No Rail

Sec. 10

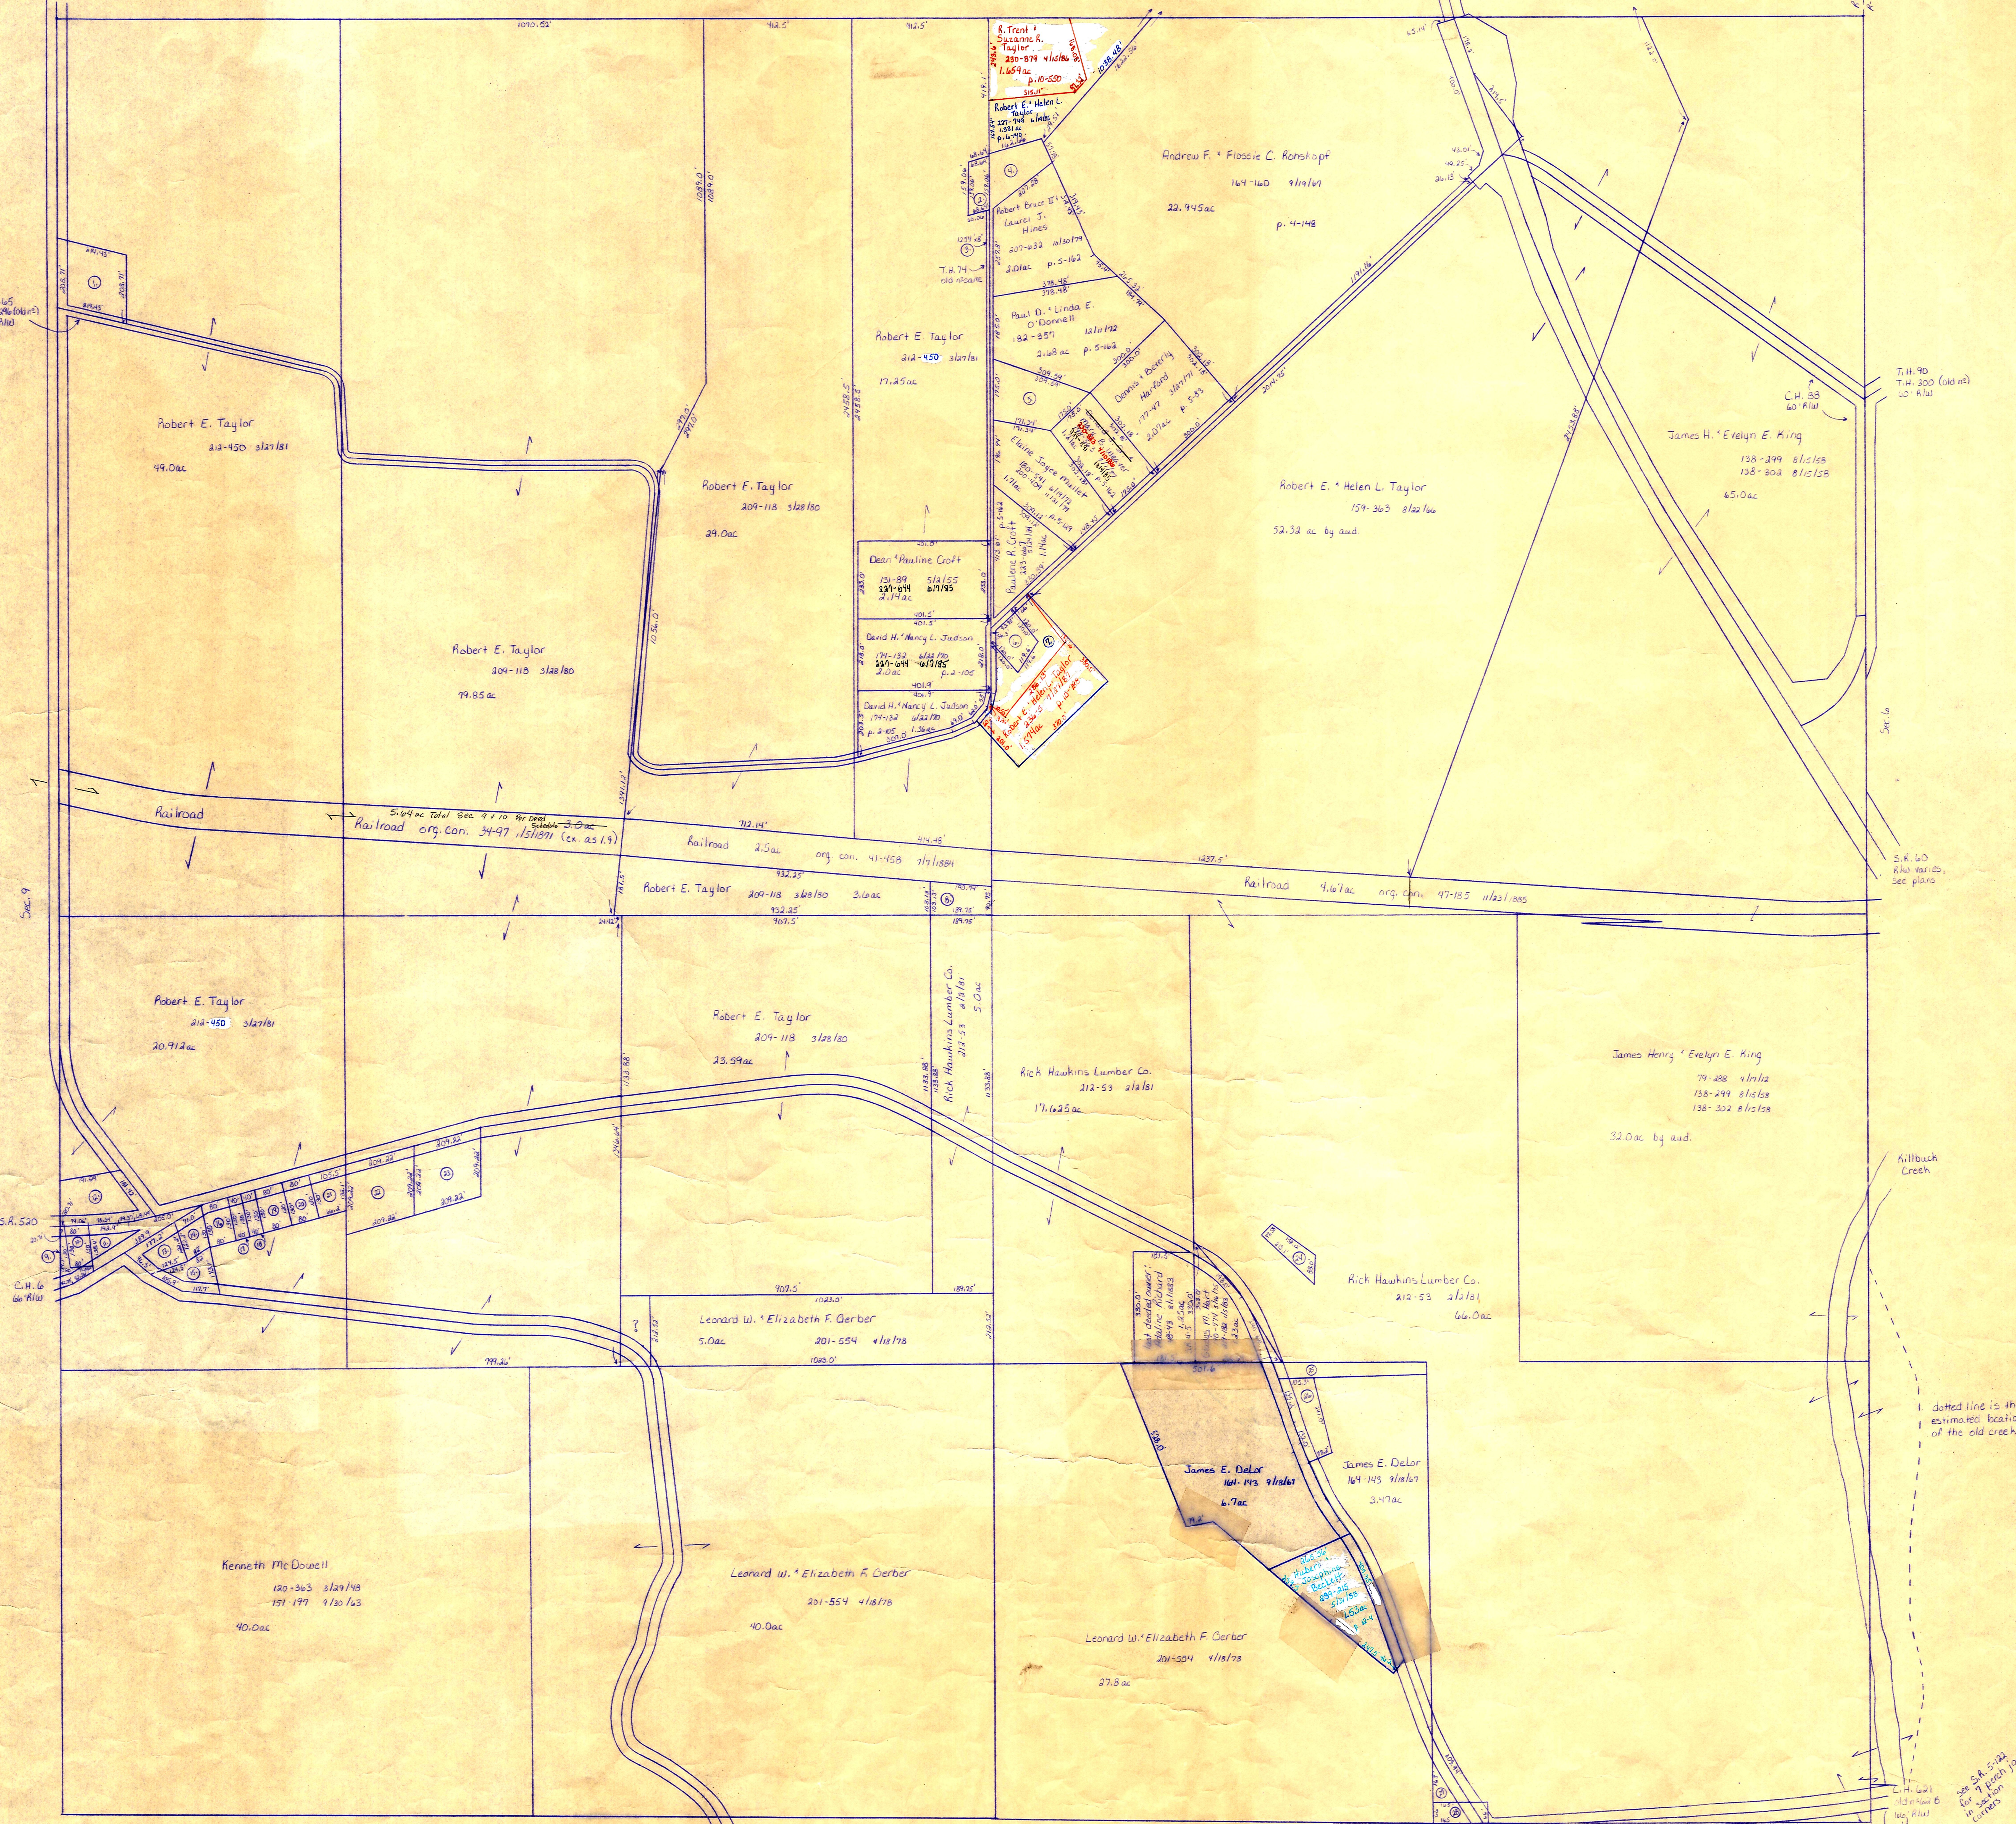




T-8, R-8, Sec. 10  
KILLBUCK TWP  
SCALE: 1" = 200'

