


Monroe Twp.

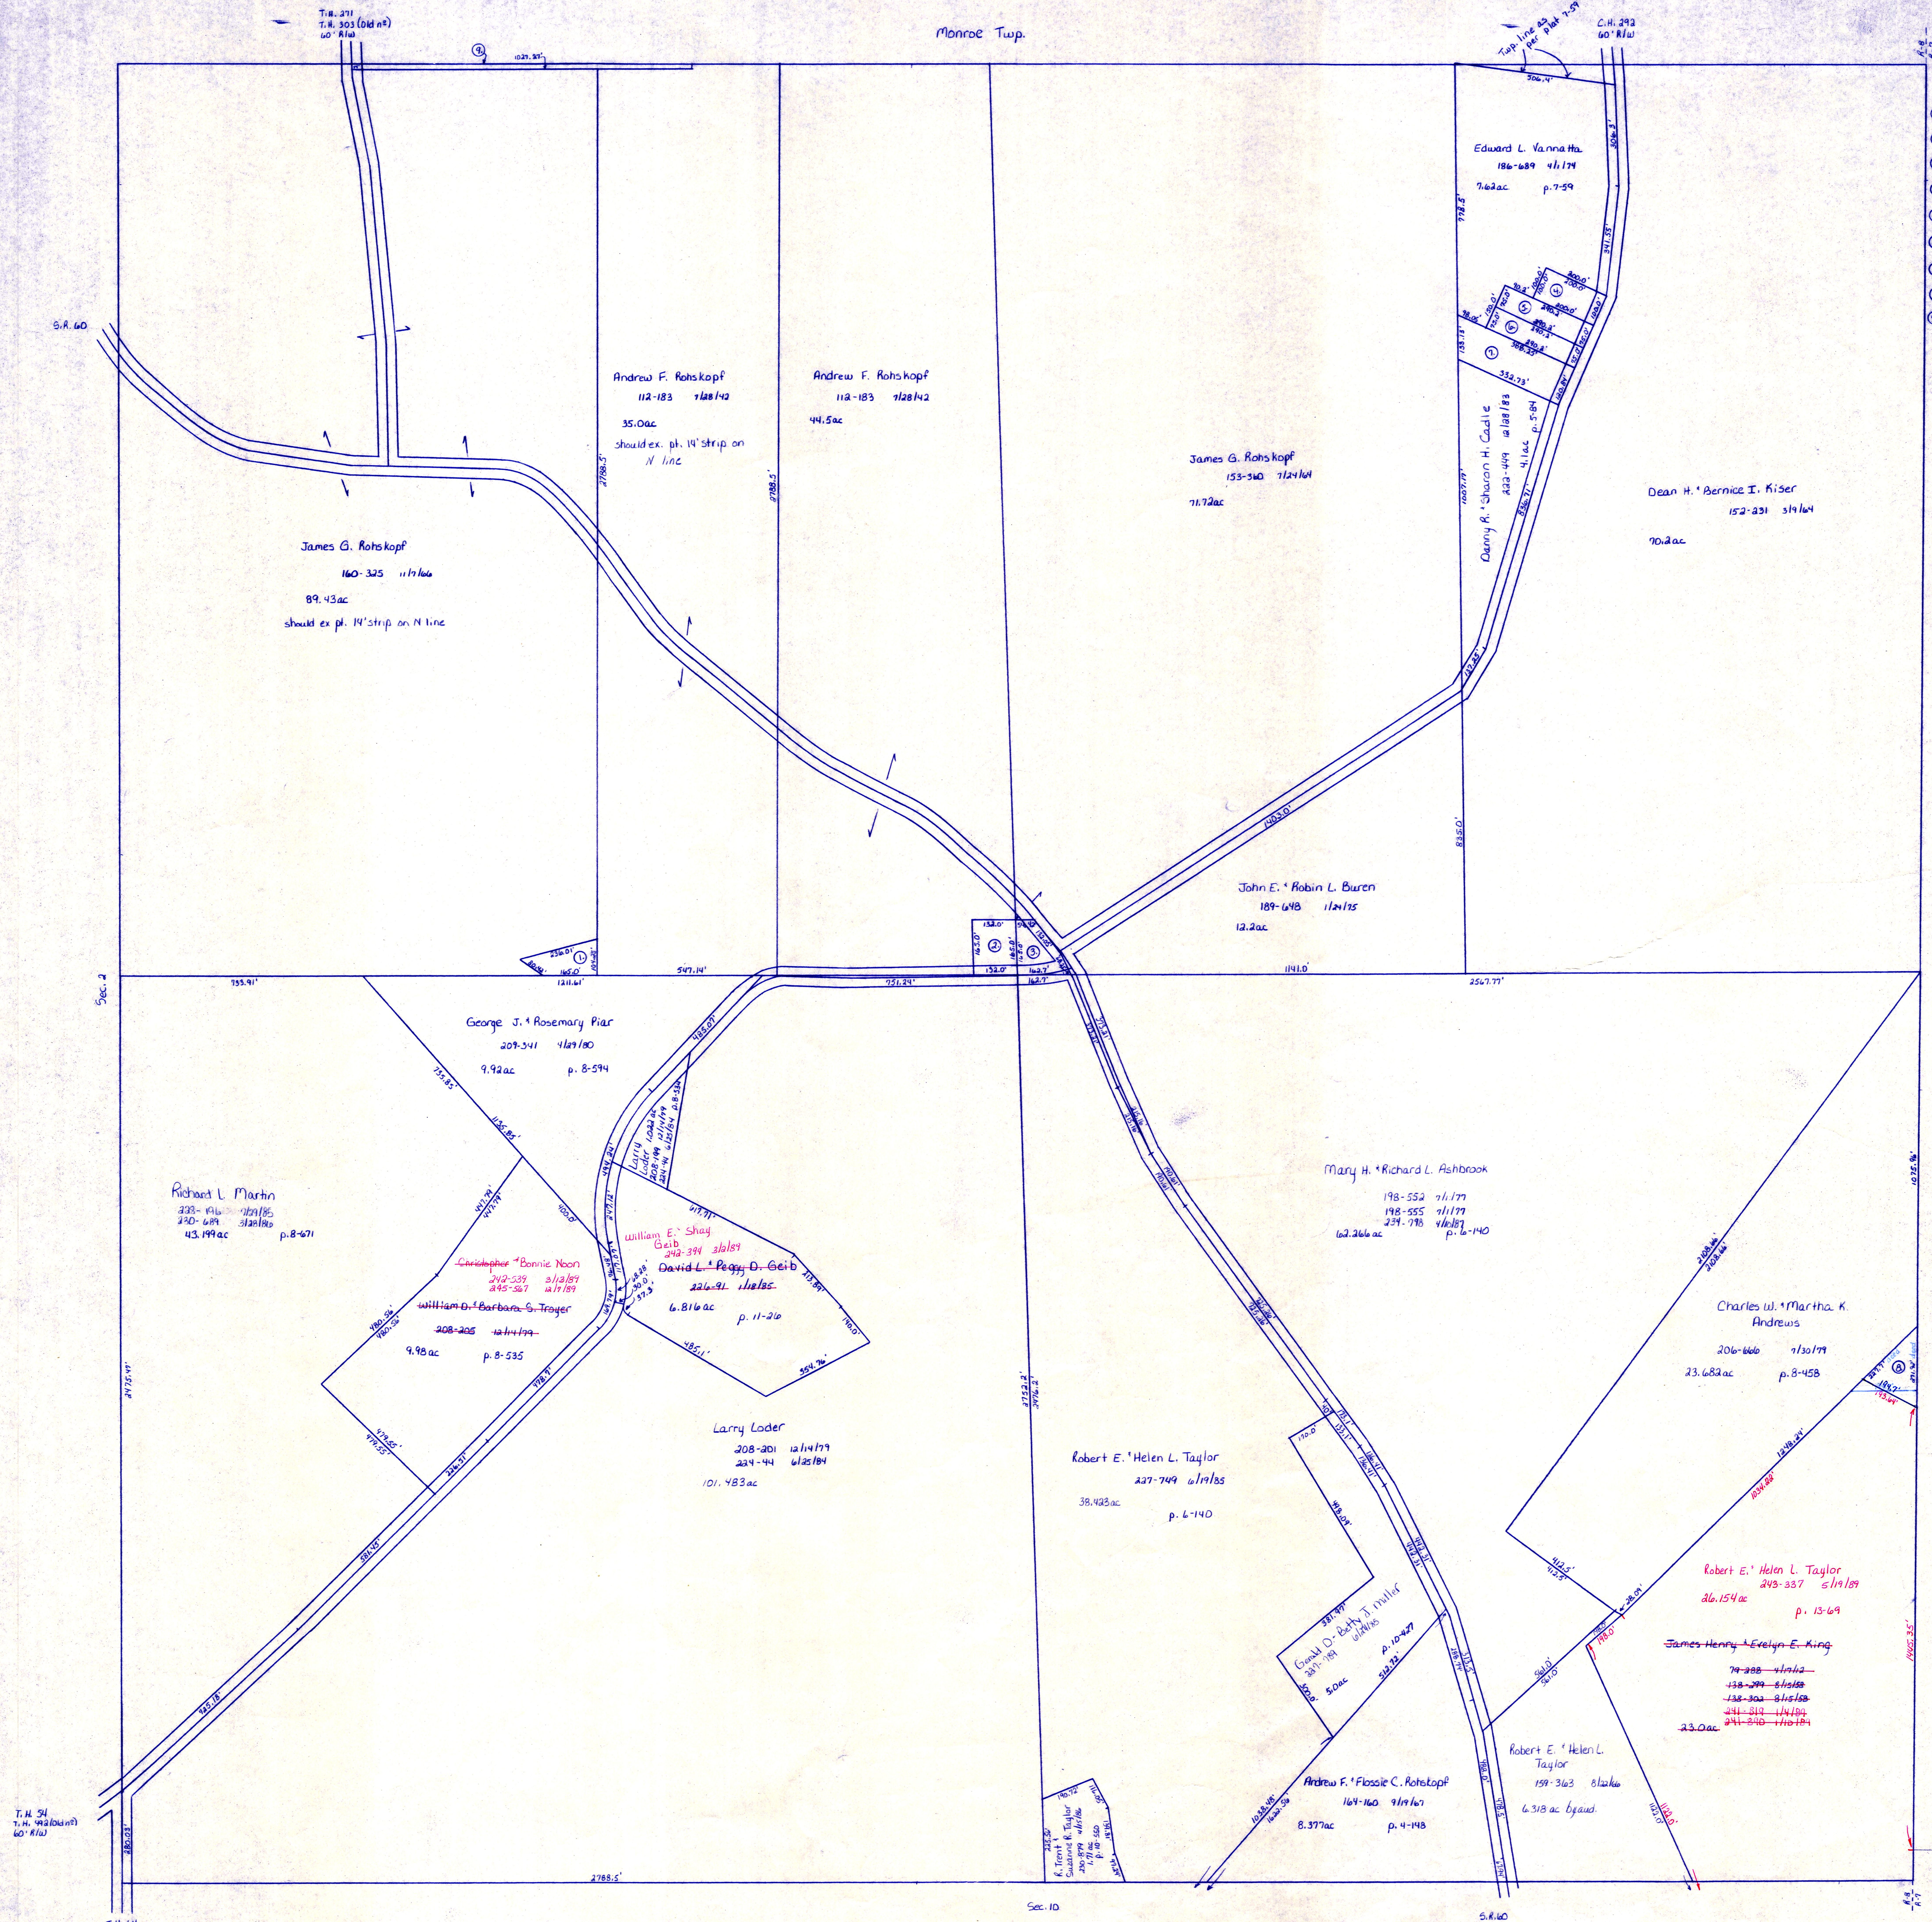

- ① Andrew F. Flossie Rotskopf 141-558 3/17/19 .36ac
- ② Bruce E. Juanita J. Chaney 176-110 2/6/19 .5ac
- ③ Bruce E. Juanita J. Chaney 176-110 2/6/19 .48ac
- ④ Jack Gladys Maxwell 171-175 2/6/19 .46ac p. 4-19
- ⑤ Jack Gladys Maxwell 198-521 2/6/19 .5ac p. 5-50
- ⑥ Carl E. Sheila R. Maxwell 235-140 5/16/87 .5ac p. 5-50
- ⑦ Albert B. Zella Maxwell 216-527 2/6/19 .10ac p. 7-10
- ⑧ Charles W. Martha K. Andrews 198-8387 5/6/79 .5ac
- ⑨ Christena M. Loder 258-777 2/1/18 .33ac p. 11-195

T-8, R-8, Sec. 1
 KILLBUCK TWP.
 SCALE: 1" = 200'

LET IT BE KNOWN, THIS MAP HAS BEEN PREPARED AS A REFERENCE GUIDE TO PROPERTY OWNERSHIP. WE BELIEVE THIS INFORMATION TO BE CORRECT AND CURRENT, HOWEVER, IT IS NOT INTENDED FOR ANY LEGAL USE, WHETHER IT BE IN SALES, TRANSFERS, TRADES, LEASES OF ANY TYPE, ETC. AND DO NOT ACCEPT RESPONSIBILITY FOR ERRORS OF ANY NATURE OR OMISSIONS CONTAINED HEREIN.

K-15