


Monroe Twp.

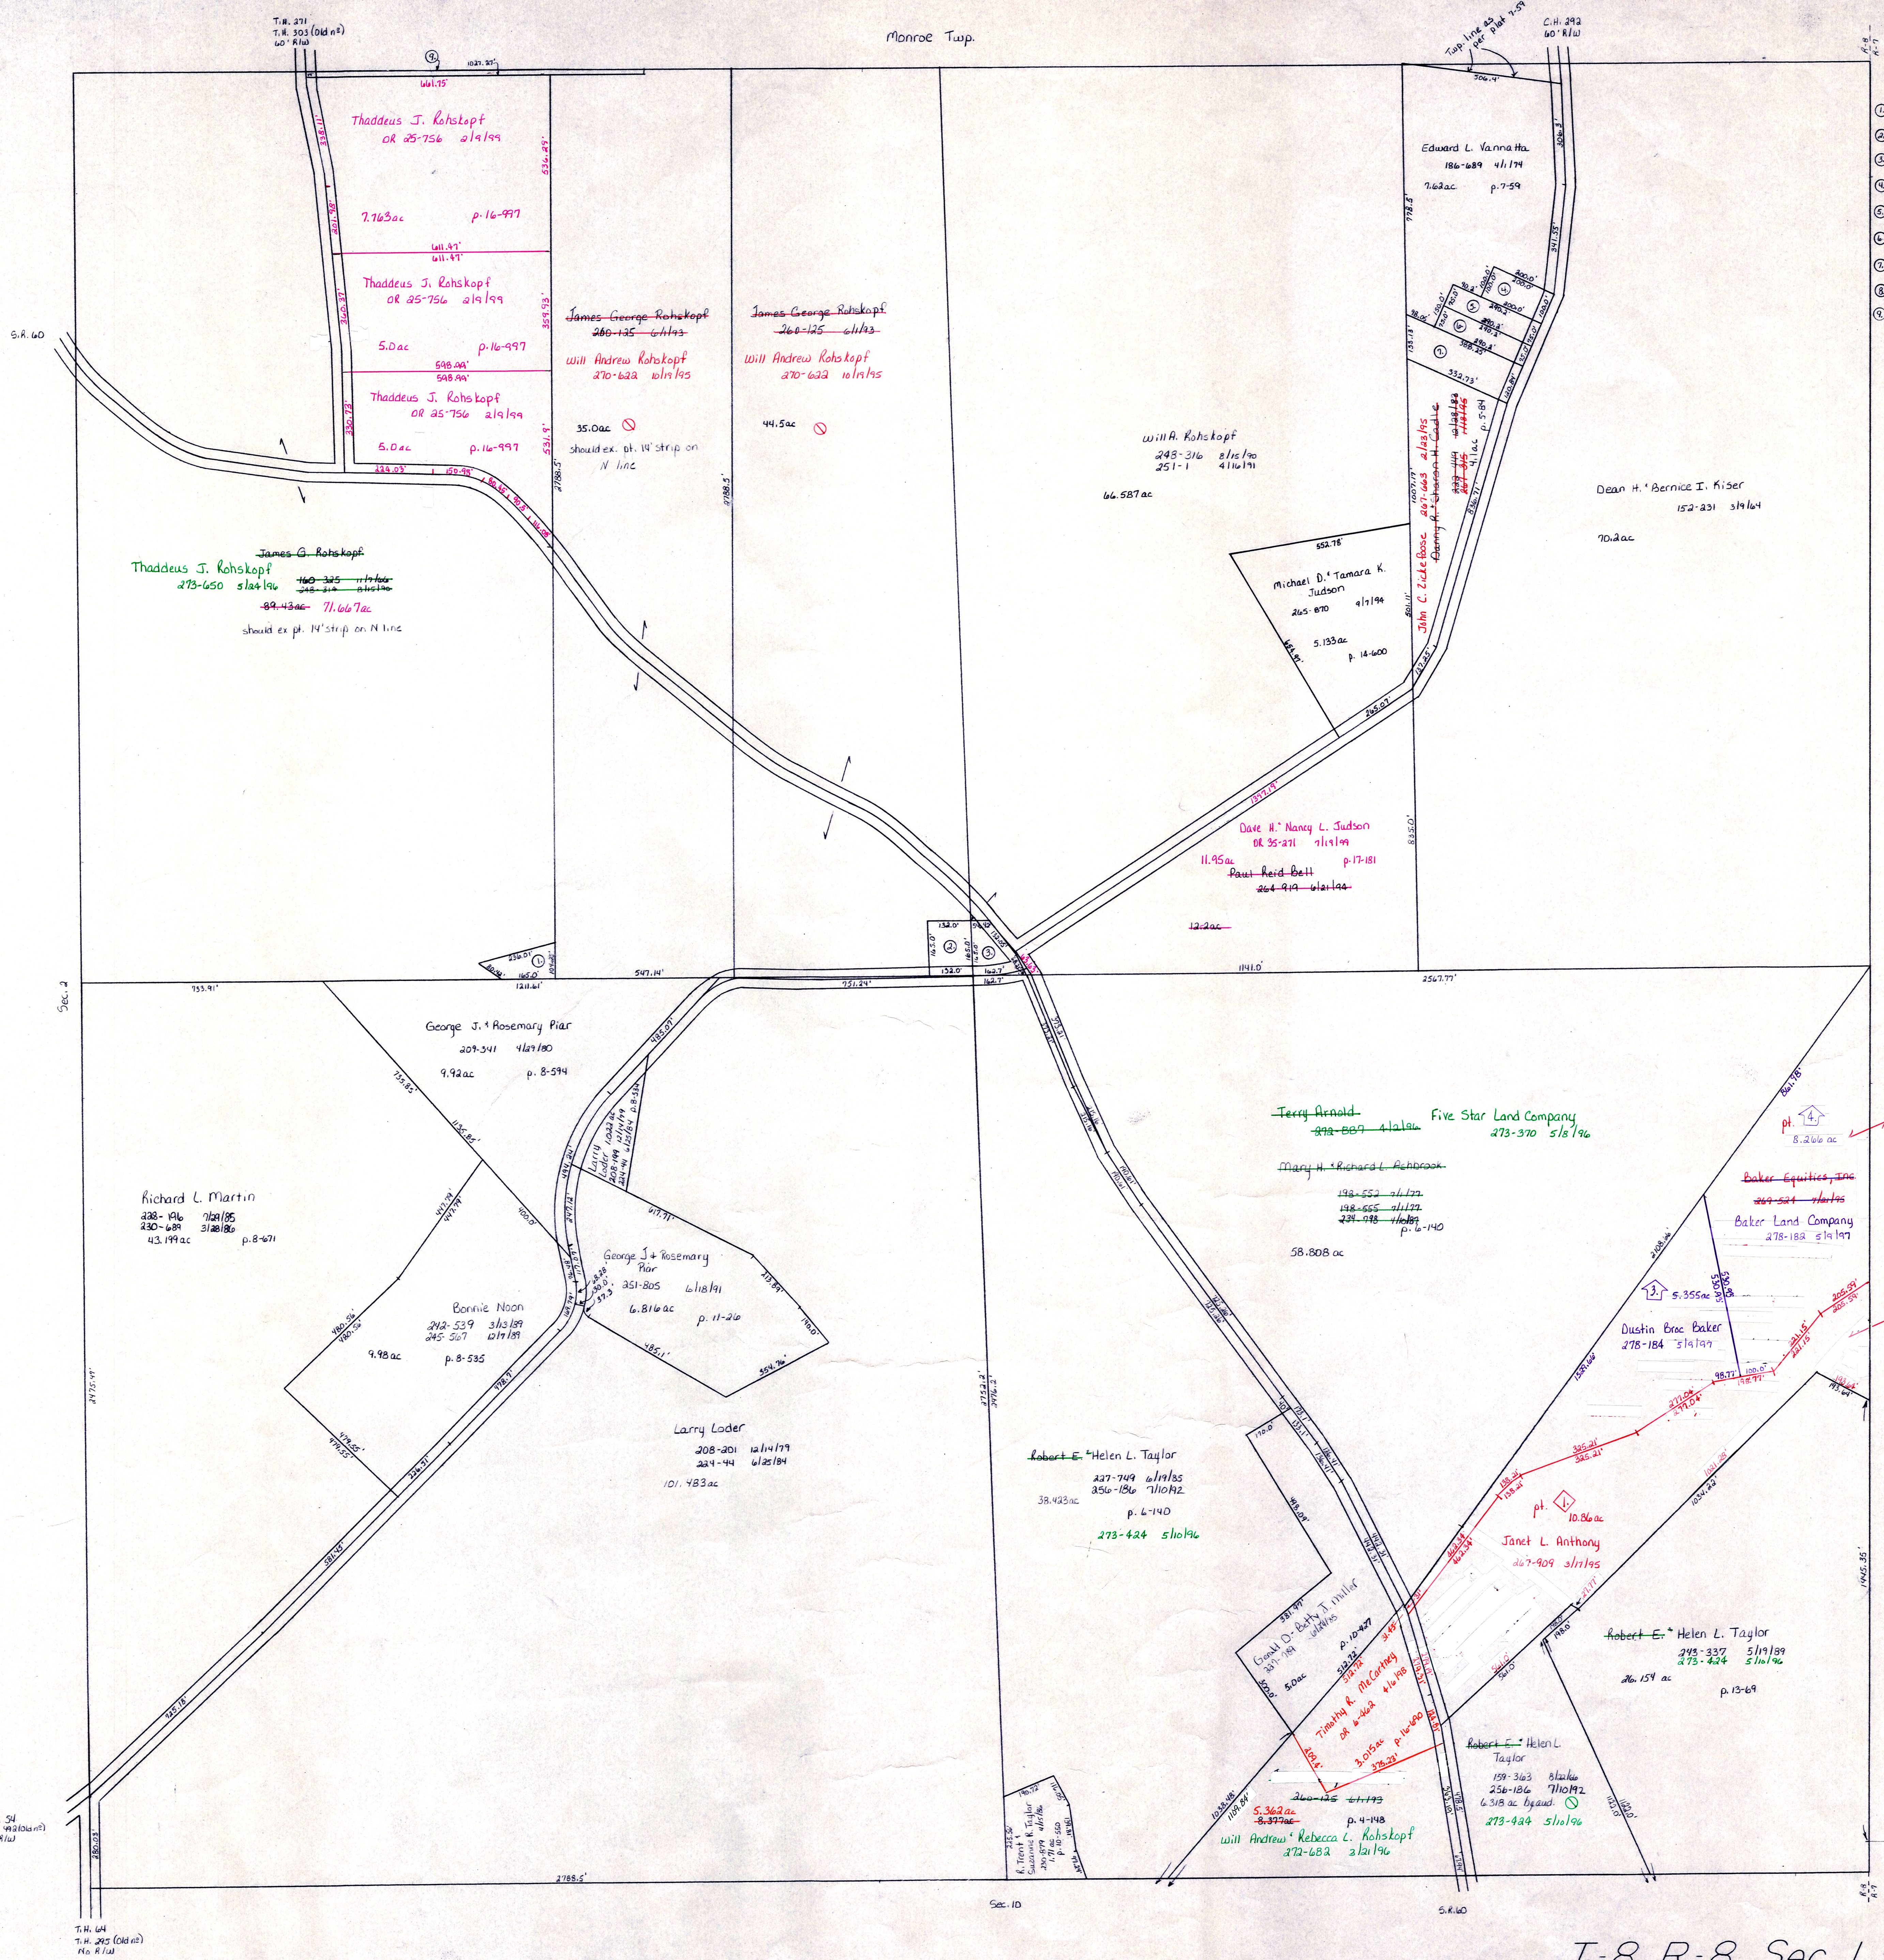


- ◇ Northridge Development
PLAT 2-244 PLATTED 7/19/15
Lot 1 = 13.232 ac total
Lot 2 = 20.229 ac total
- ⬆ Replat of Lot No. 2 of Northridge Development
PLAT 2-269 PLATTED 5/15/19
Lot 3 = 5.265 ac total
Lot 4 = 75.074 ac total

T-8, R-8, Sec. 1
KILLBUCK TWP.
SCALE: 1" = 200'

LET IT BE KNOWN, THIS MAP HAS BEEN PREPARED AS A REFERENCE GUIDE TO PROPERTY OWNERSHIP. WE BELIEVE THIS INFORMATION TO BE CORRECT AND CURRENT, HOWEVER, IT IS NOT INTENDED FOR ANY LEGAL USE, WHETHER IT BE IN SALES, TRANSFERS, TRADES, LEASES OF ANY TYPE, ETC., AND DO NOT ACCEPT RESPONSIBILITY FOR ERRORS OF ANY NATURE OR OMISSIONS CONTAINED HEREIN.