


Monroe Twp.

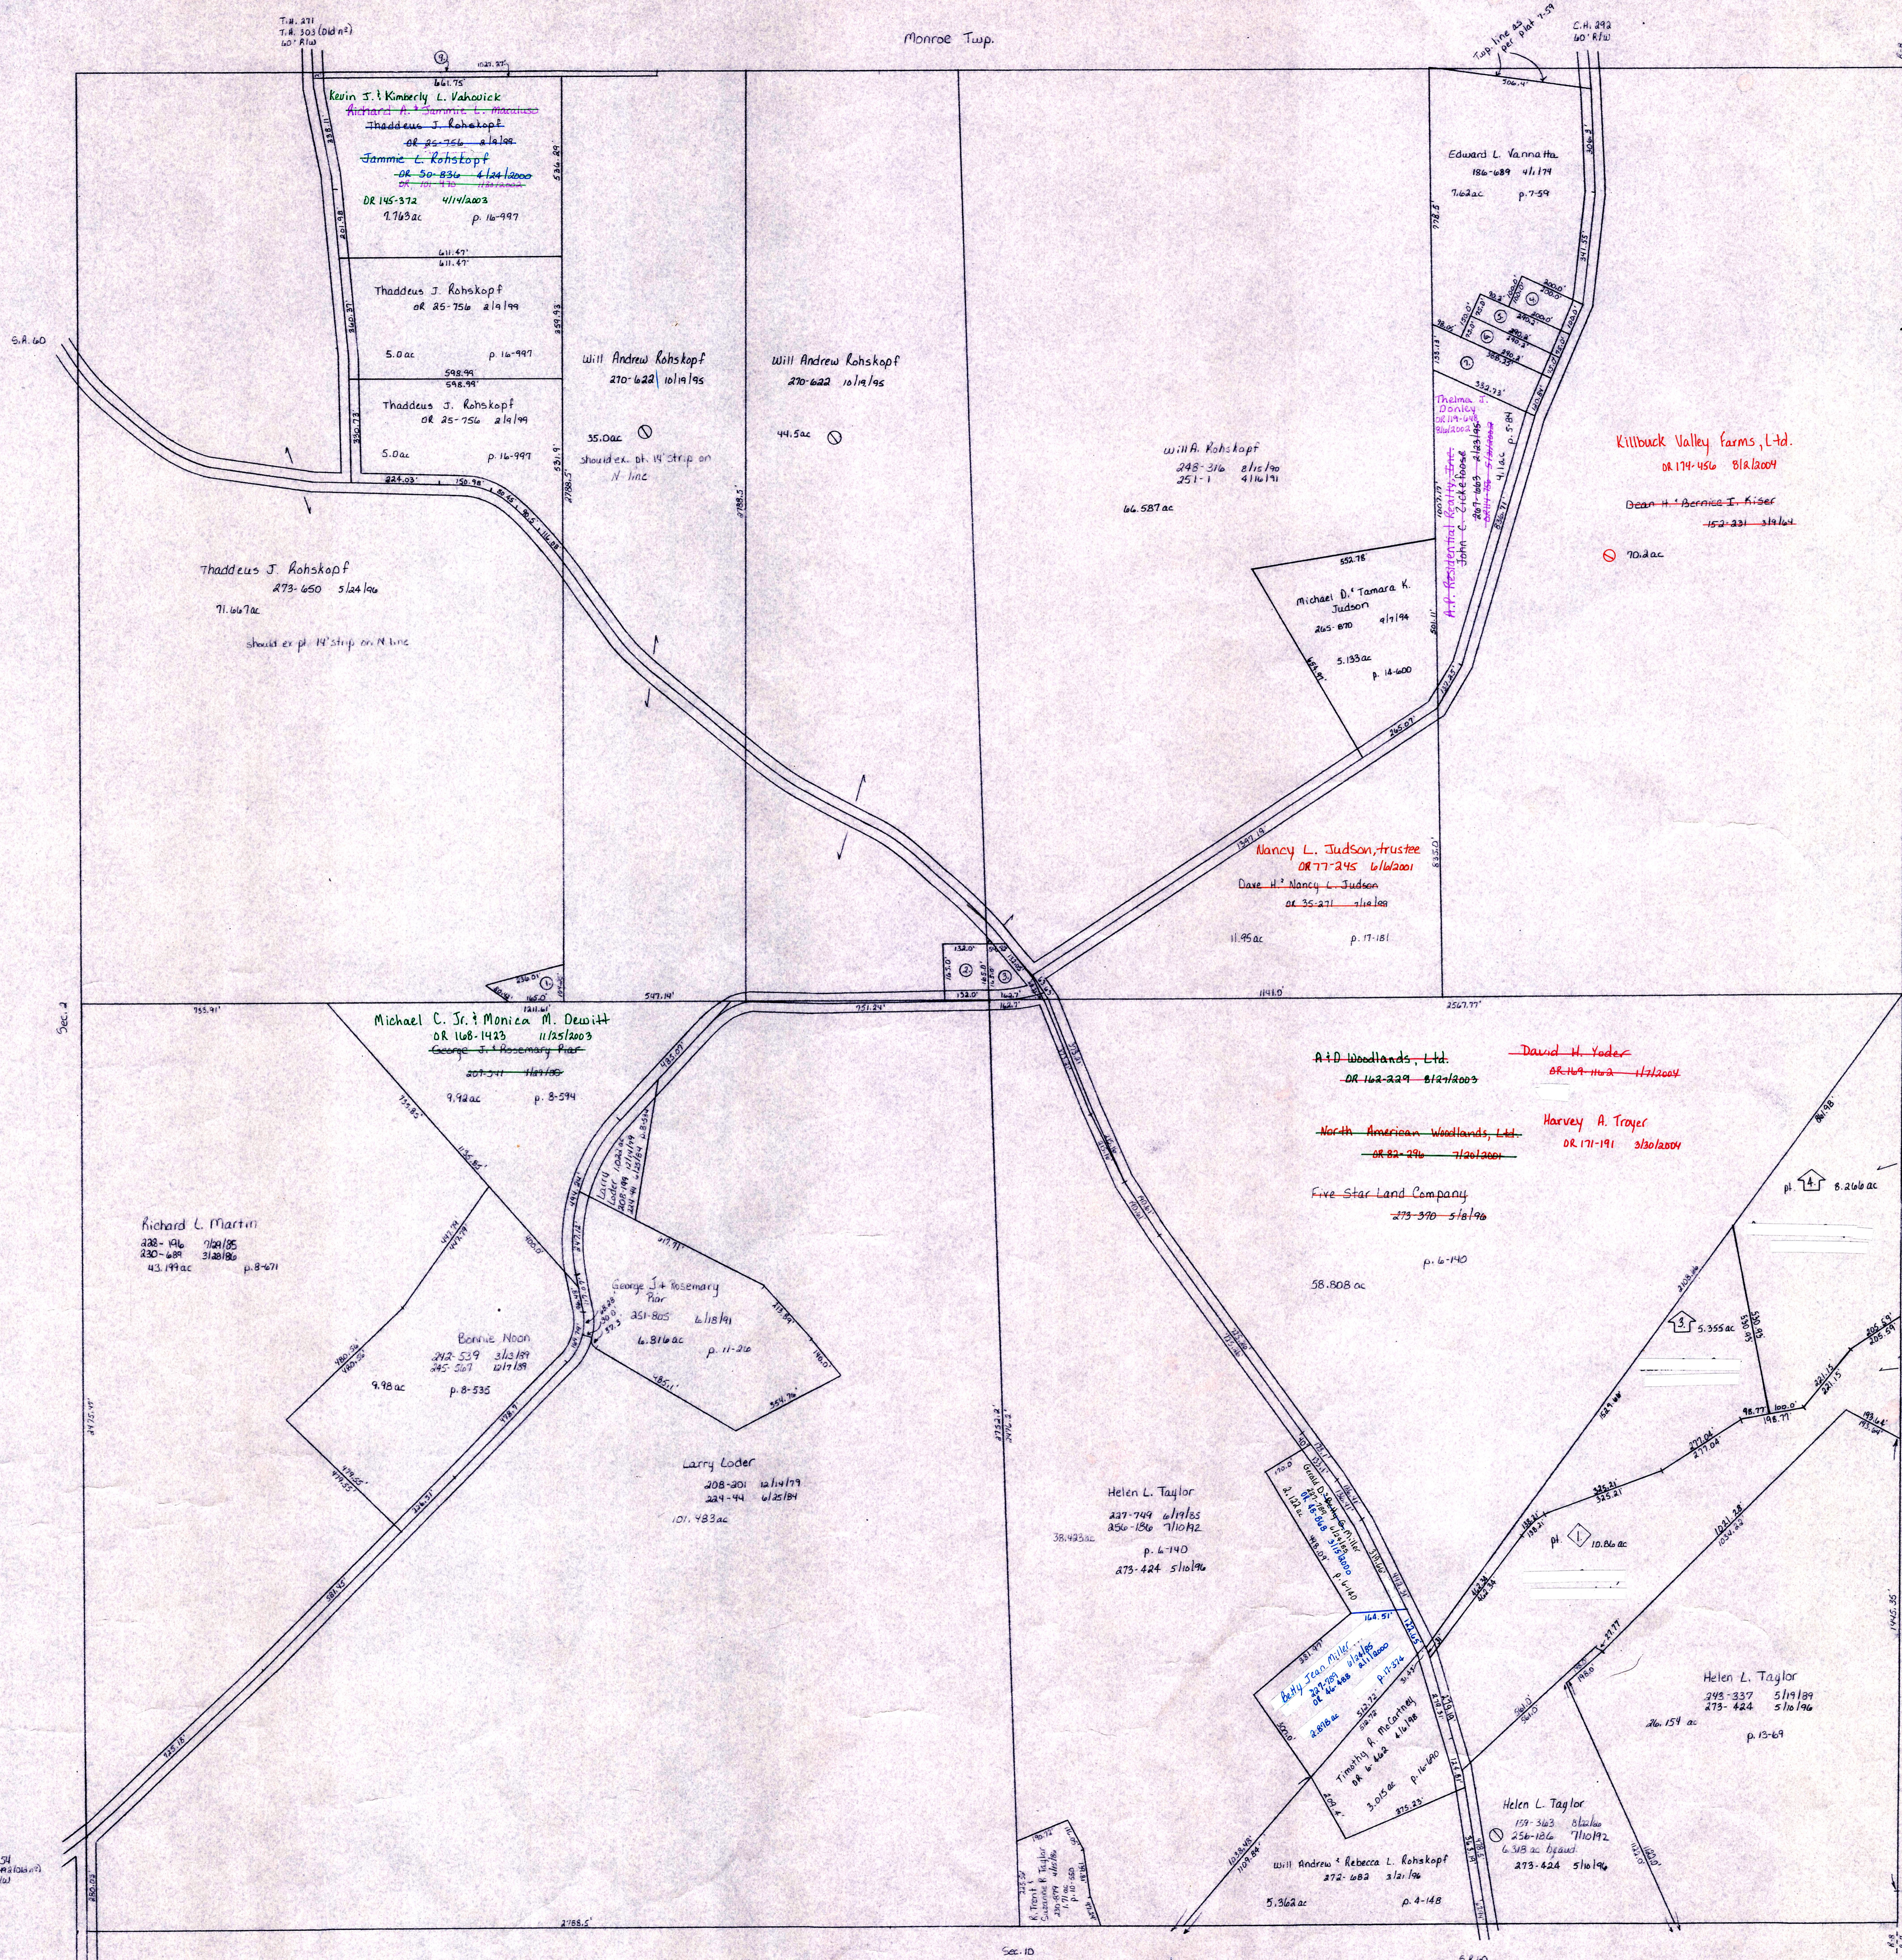


**Killbuck Valley Farms, Ltd.**  
 OR 174-456 8/12/04  
 70.2 ac

**Nancy L. Judson, Trustee**  
 OR 77-245 6/16/01  
 Dave H. & Nancy L. Judson  
 11.95 ac p. 17-181

**A+D Woodlands, Ltd.**  
 OR 162-229 8/27/00  
**North American Woodlands, Ltd.**  
**Five Star Land Company**  
 273-320 5/16/96  
 58.808 ac p. 6-140

**David H. Yoder**  
**Harvey A. Troyer**  
 OR 171-191 3/30/04

Northridge Development  
 PLAT 2-249 PLATTED 7/19/95 K-15A  
 Replat of Lot No. 2 of Northridge Development  
 PLAT 2-269 PLATTED 5/15/97 K-15A

T-8, R-8, Sec. 1  
 KILLBUCK TWP.  
 SCALE: 1" = 200'

LET IT BE KNOWN, THIS MAP HAS BEEN PREPARED AS A REFERENCE GUIDE TO PROPERTY OWNERSHIP. WE BELIEVE THIS INFORMATION TO BE CORRECT AND CURRENT. HOWEVER, IT IS NOT INTENDED FOR ANY LEGAL USE, WHETHER IT BE IN SALES, TRANSFERS, TRADES, LEASES OF ANY TYPE, ETC., AND DO NOT ACCEPT RESPONSIBILITY FOR ERRORS OF ANY NATURE OR OMISSIONS CONTAINED HEREIN.

K-15