


Washington Twp.

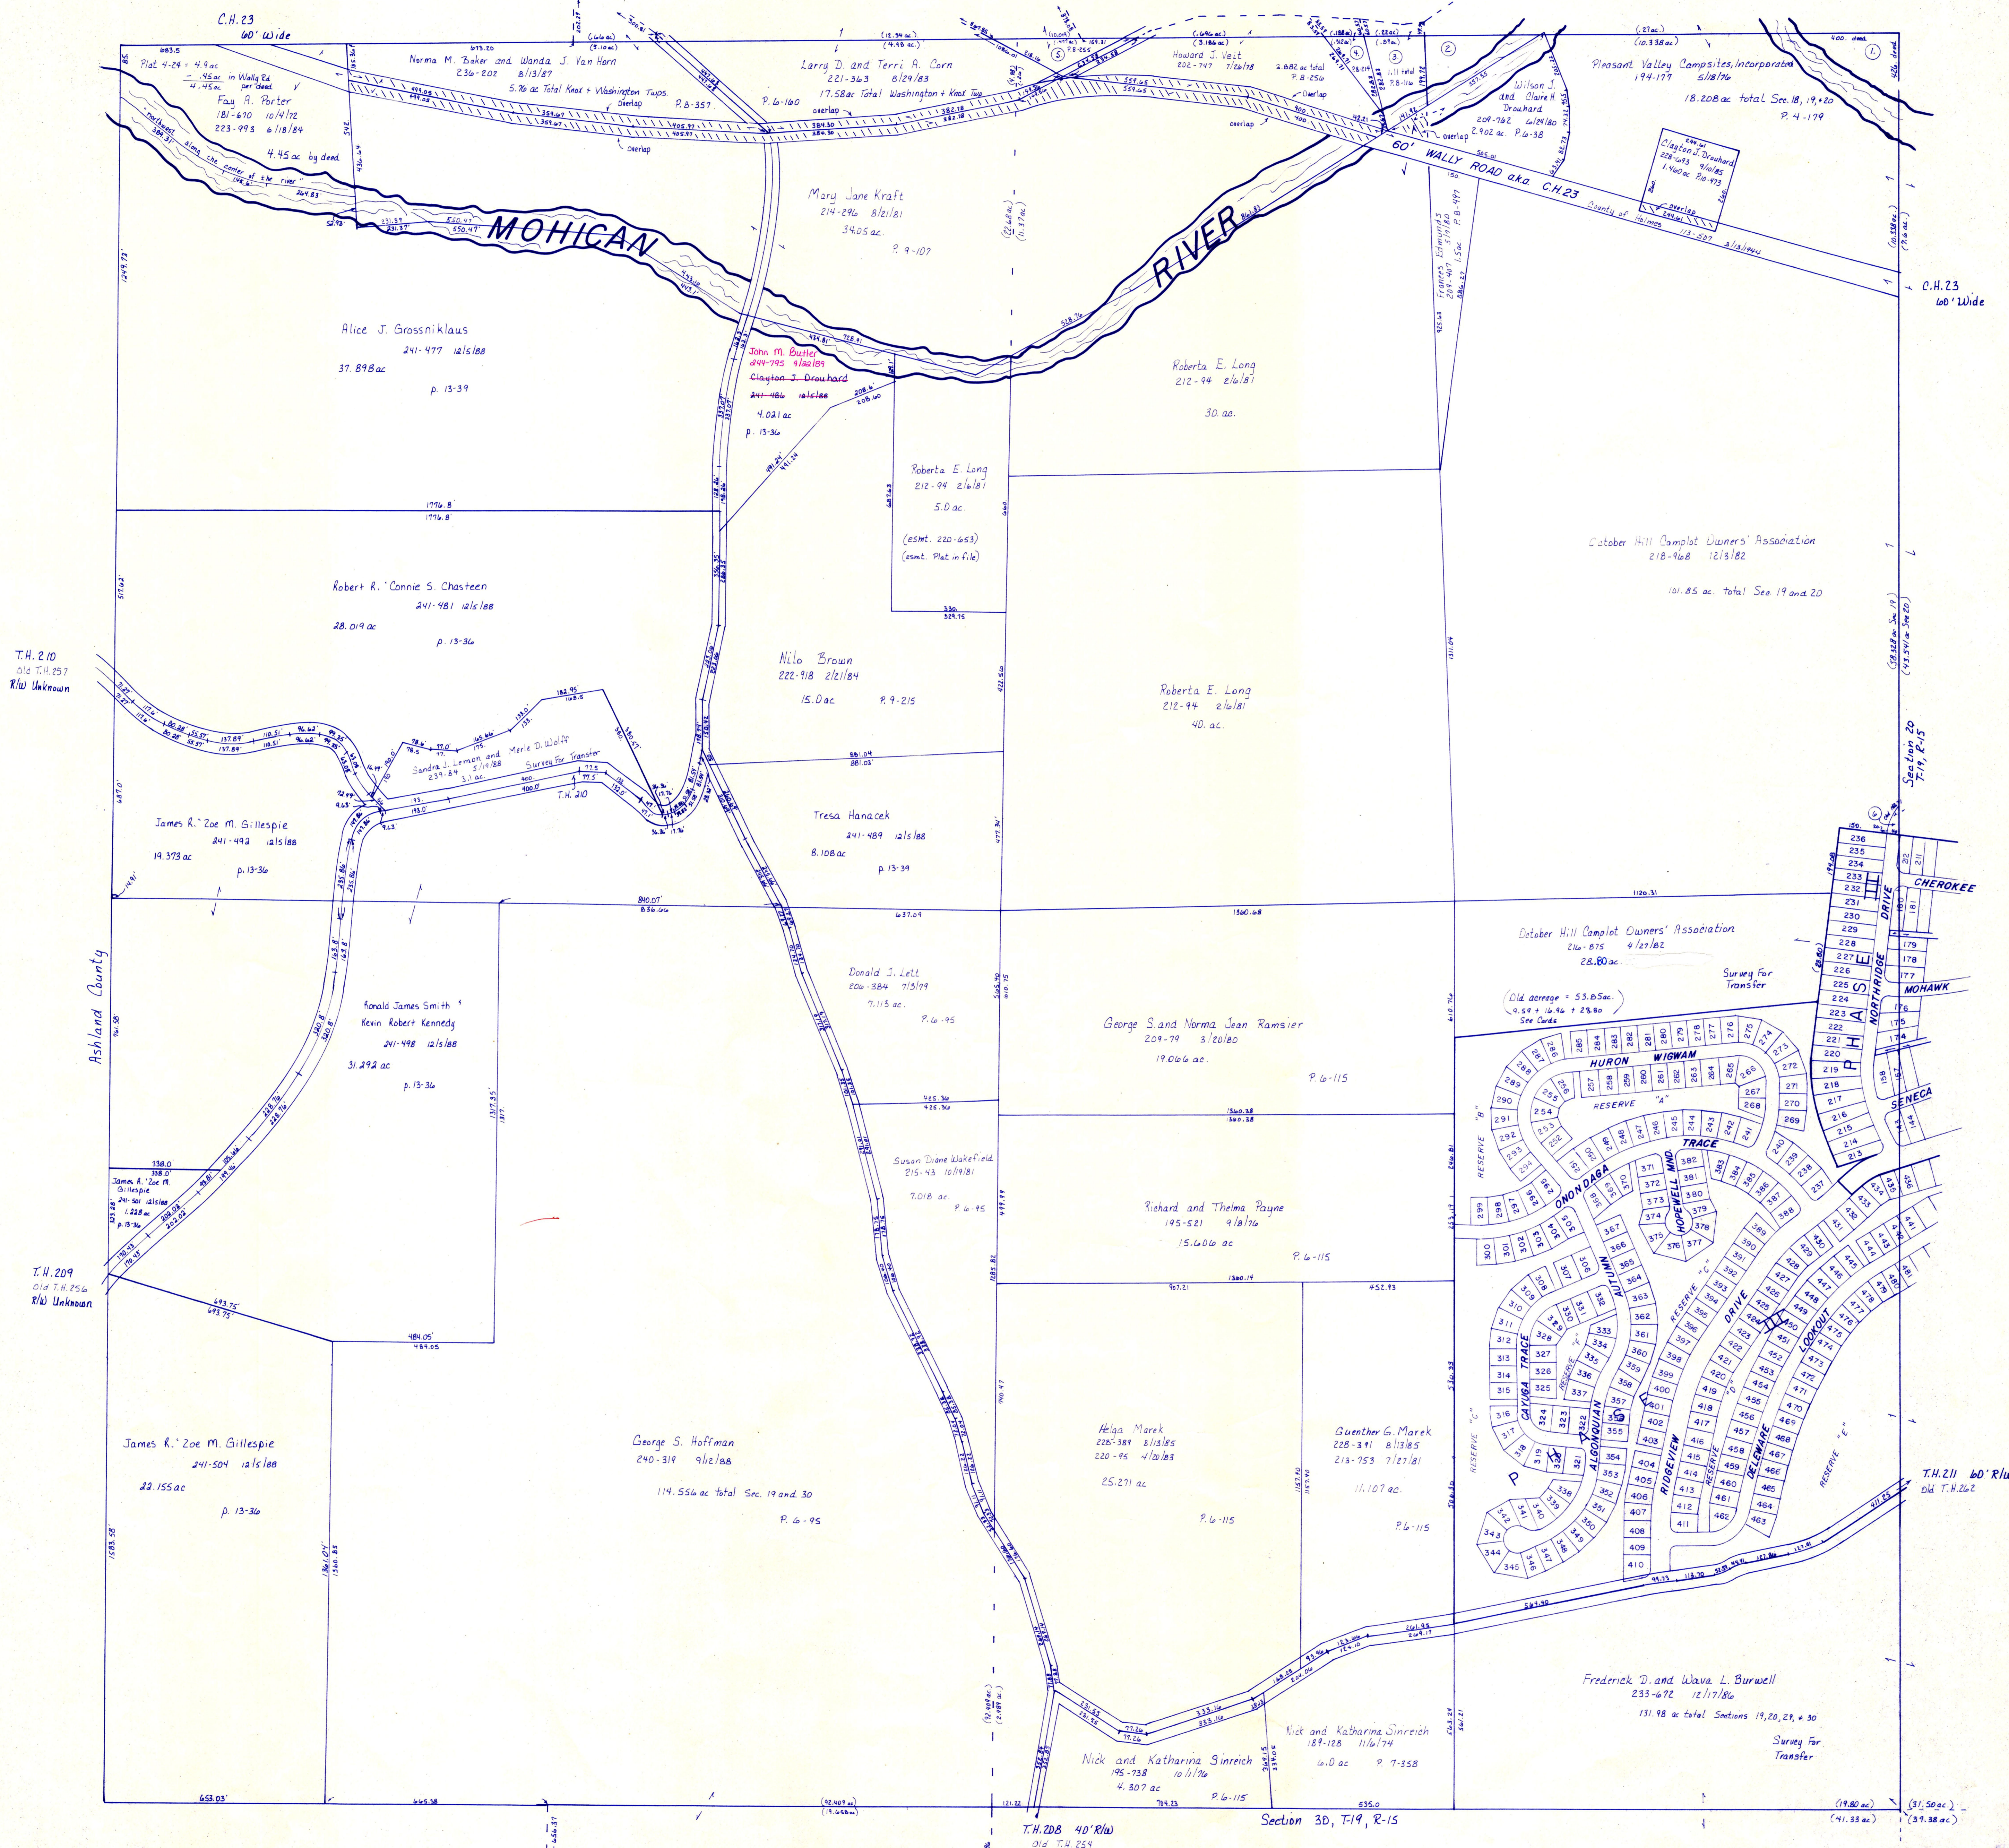

- ① 1.90 ac Carl and Billie B. Balder 108-385 11/1/68 S.F.T.
- ② 1.52 ac Carl and Billie B. Balder 168-385 11/1/68 S.F.T.
- ③ .89 ac Robert Casper - Richard P. Schmitt 202-277 2/13/68 S.F.T.
- ④ .512 ac Robert Casper - Richard P. Schmitt 202-277 2/13/68 S.F.T.
- ⑤ .477 ac Howard J. Veit 202-747 7/26/78 P.B. 255
- ⑥ .052 ac October Hill Campsite Owners' Association 216-875 4/21/82

KNOX TWP.  
T-19, R-15  
Section 19  
SCALE 1" = 200'

LET IT BE KNOWN, THIS MAP HAS BEEN PREPARED AS A REFERENCE GUIDE TO PROPERTY OWNERSHIP. WE BELIEVE THIS INFORMATION TO BE CORRECT AND CURRENT. HOWEVER, IT IS NOT INTENDED FOR ANY LEGAL USE, WHETHER IT BE IN SALES, TRANSFERS, TRADING, LEASES OR OF ANY TYPE, ETC., AND DO NOT ACCEPT RESPONSIBILITY FOR ERRORS OF ANY NATURE OR OMISSIONS CONTAINED HEREIN.