


Washington Twp.

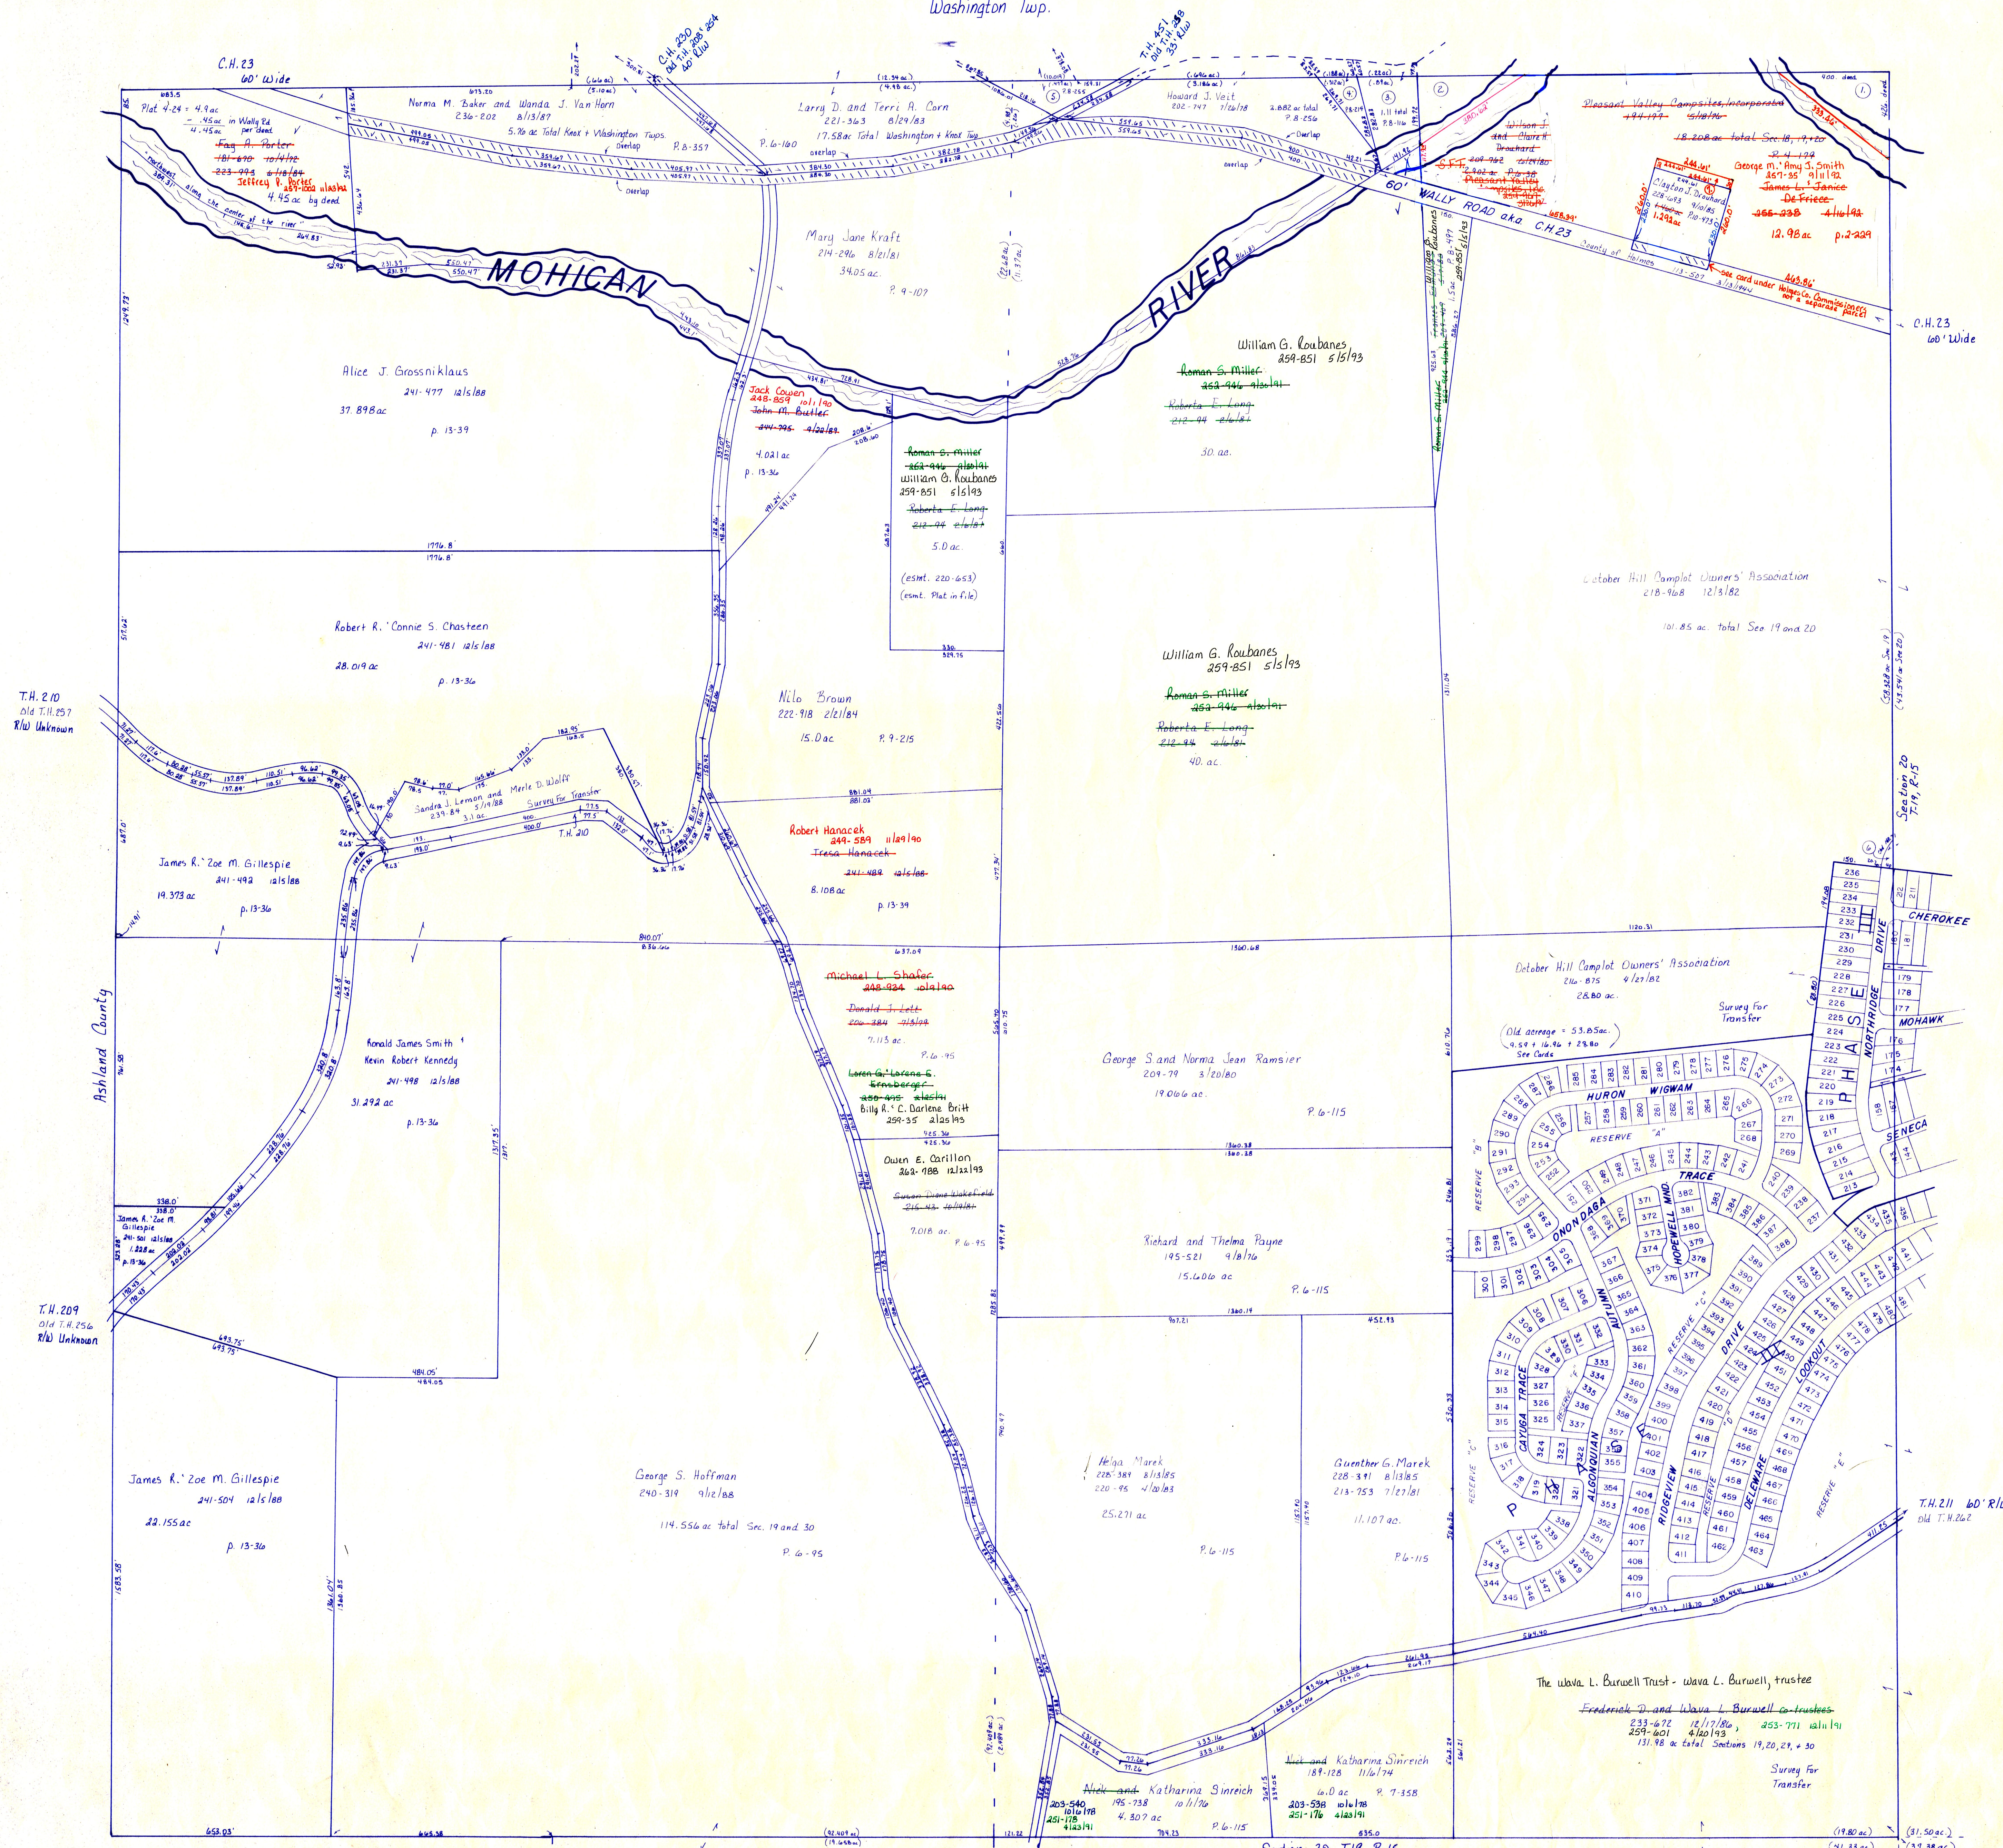

T.H. 210  
Old T.H. 257  
R/W Unknown

T.H. 209  
Old T.H. 256  
R/W Unknown

T.H. 208 40' R/W  
Old T.H. 254

Section 30, T19, R-15

T.H. 211 60' R/W  
Old T.H. 262

KNOX TWP.  
T-19, R-15  
Section 19  
SCALE 1" = 200'

- ① 1.00 ac Carl and Billie B. Baldner S.F.T. 168-385 11/7/68
- ② 1.50 ac Carl and Billie B. Baldner S.F.T. 168-385 11/7/68
- ③ .89 ac Robert Gusinger - Richard P. Schafnir P.B. 214-804 1/6/89
- ④ .512 ac Robert Gusinger - Richard P. Schafnir P.B. 214-804 1/6/89
- ⑤ .477 ac Kenneth L. Carl, L. Wilson Kenneth L. Carl, L. Wilson P.B. 255-248 7/8-255 200-247 7/8-255 1/11/11
- ⑥ .052 ac October Hill Campout Owners' Association 216-875 4/27/82
- ⑦ Clayton J. Drouhard 255-236 4/16/92 168 ac p. 12-911

LET IT BE KNOWN THIS MAP HAS BEEN PREPARED AS A REFERENCE GUIDE TO PROPERTY OWNERSHIP. WE BELIEVE THIS INFORMATION TO BE CORRECT AND CURRENT. HOWEVER, IT IS NOT INTENDED FOR ANY LEGAL USE, WHETHER IT BE IN SALES, TRANSFERS, TRADES, LEASES OF ANY TYPE, ETC. AND DO NOT ACCEPT RESPONSIBILITY FOR ERRORS OF ANY NATURE OR OMISSIONS CONTAINED HEREIN.