


Knox County

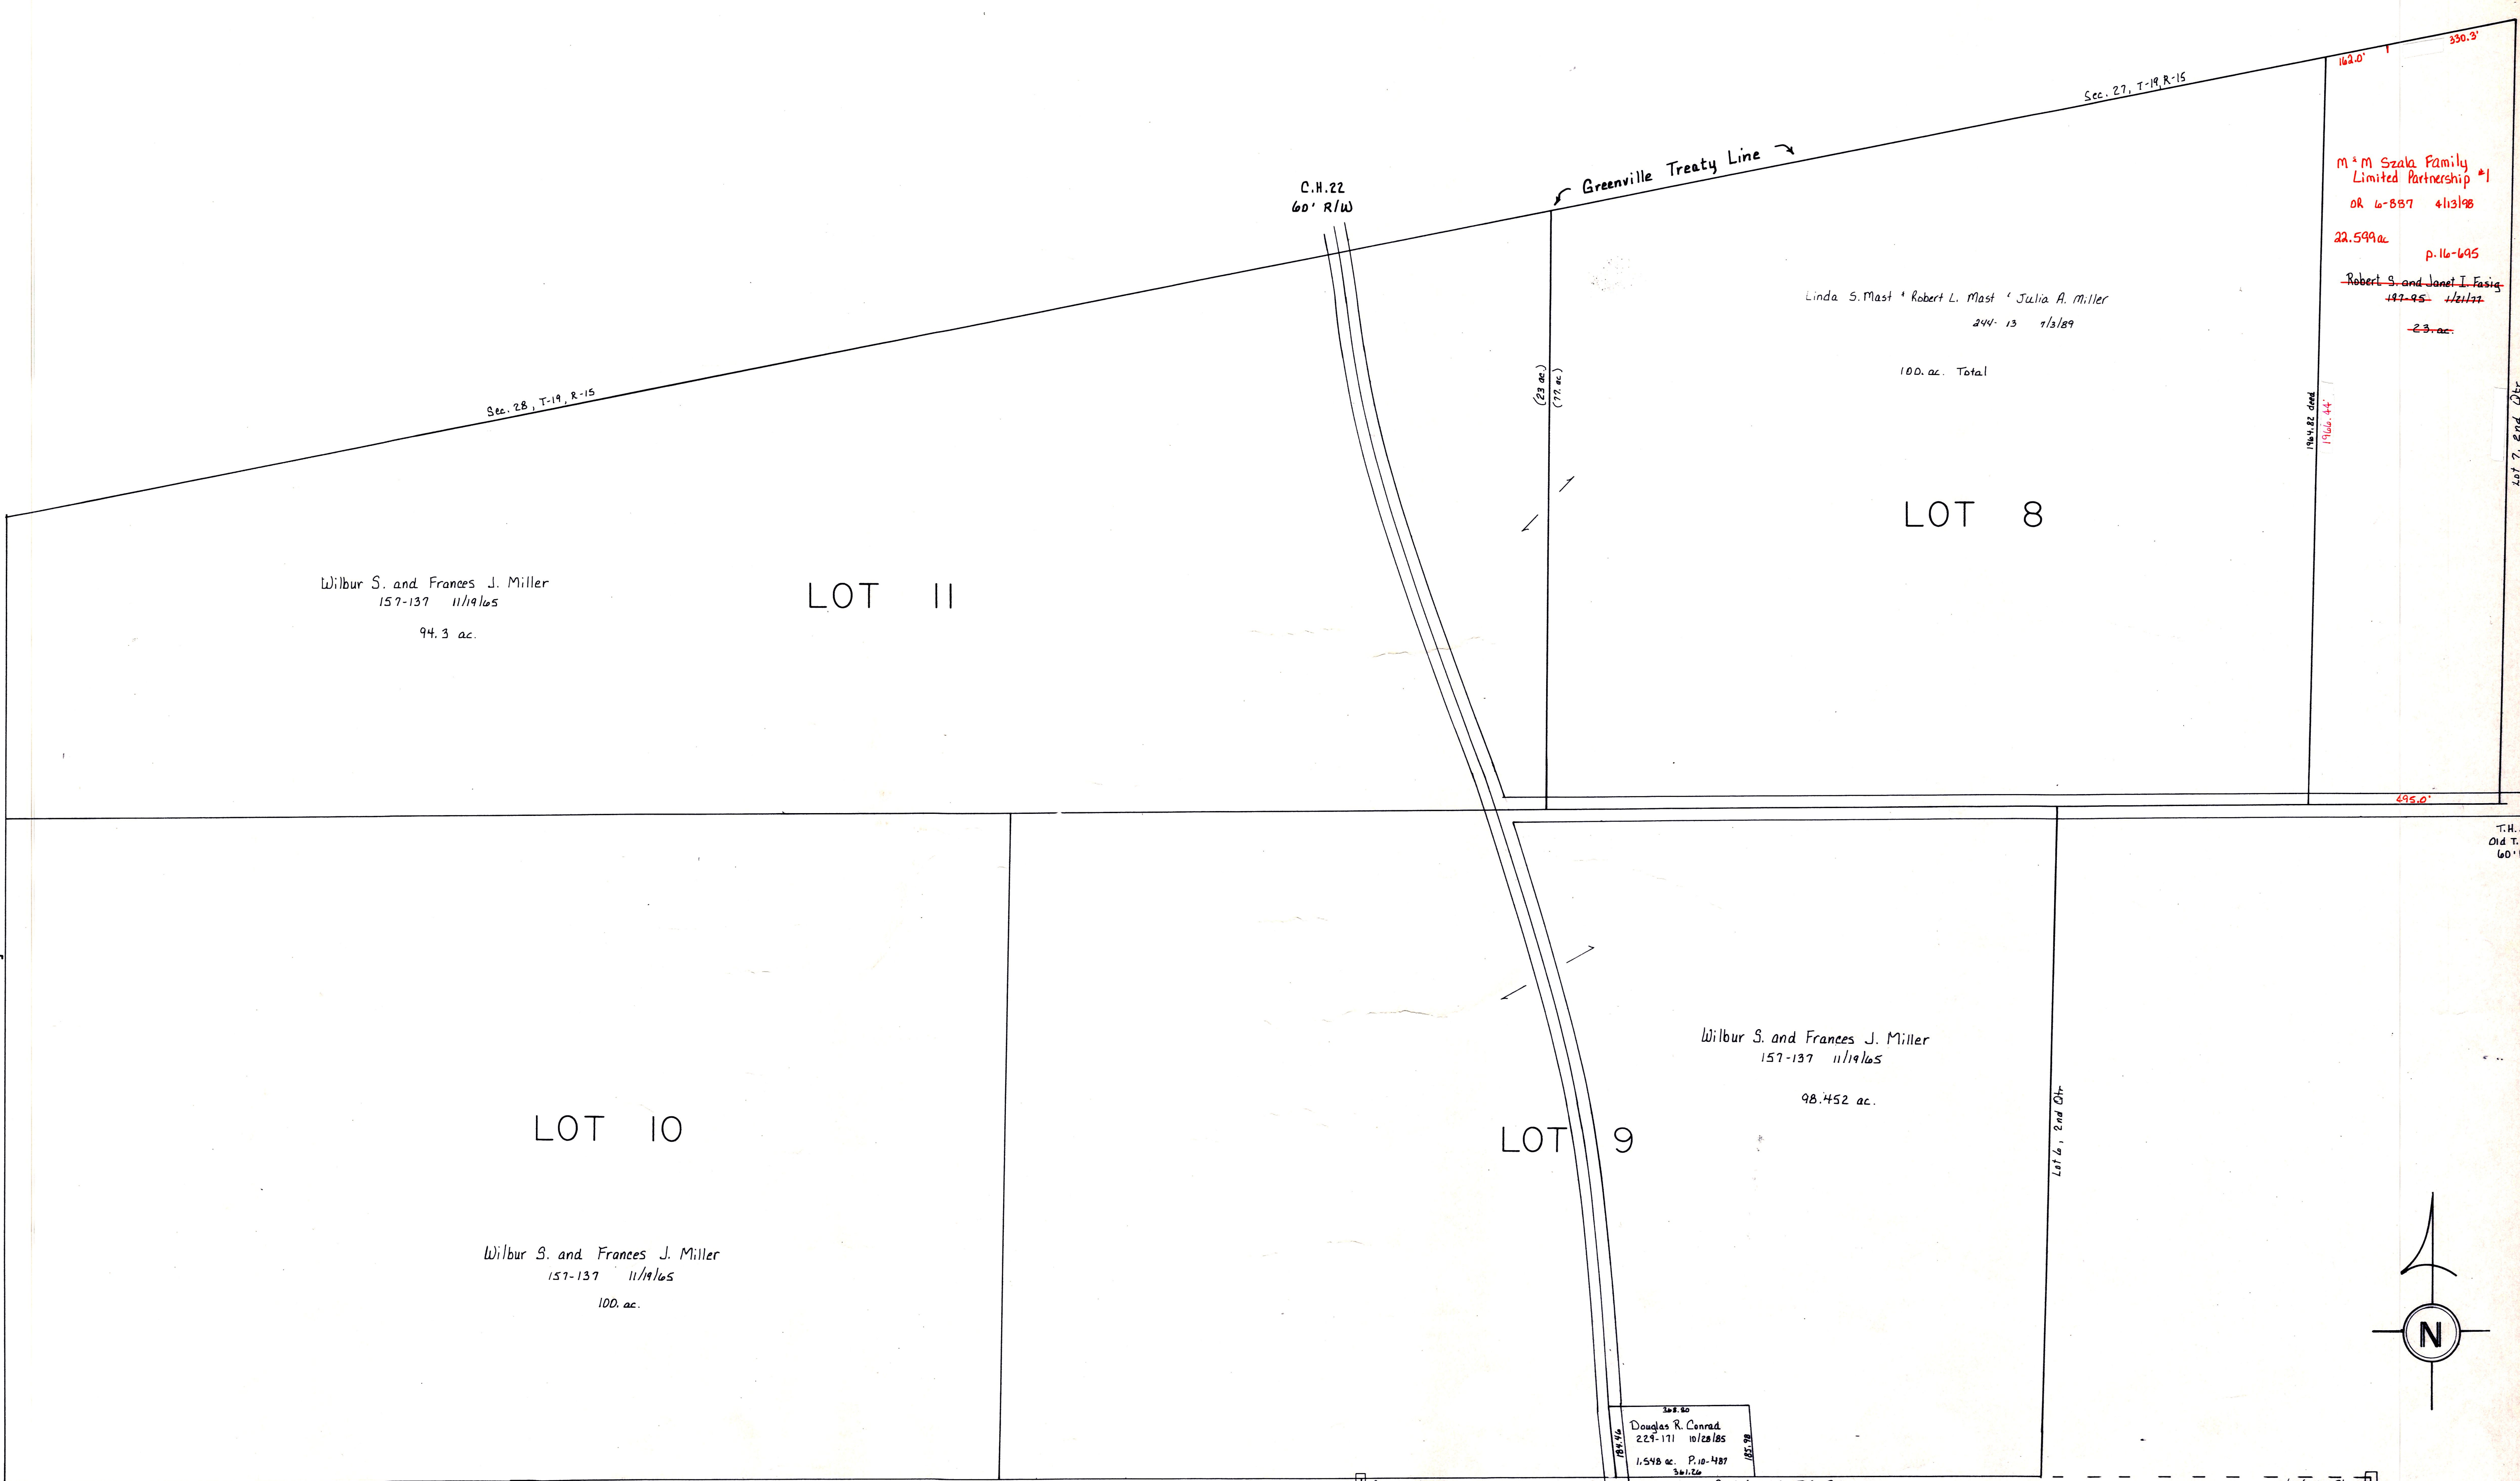

Wilbur S. and Frances J. Miller
94.3 ac.

LOT II

Linda S. Mast + Robert L. Mast + Julia A. Miller
244-13 7/13/89
100 ac. Total

LOT 8

M + M Szala Family
Limited Partnership #1
OK 6-587 4/13/98
22.599 ac. p. 16-645
Robert S. and Janet I. Fasig
23 ac.

LOT 10

Wilbur S. and Frances J. Miller
100 ac.

LOT 9

Wilbur S. and Frances J. Miller
157-137 11/19/15
98.452 ac.

Douglas R. Conrad
1.548 ac. P. 10-487

KNOX TWP.
T-9, R-9
2nd Qtr.
Lots 8, 9, 10, 11
SCALE 1" = 200'

LET IT BE KNOWN, THIS MAP HAS BEEN PREPARED AS A REFERENCE GUIDE TO PROPERTY OWNERSHIP. WE BELIEVE THIS INFORMATION TO BE CORRECT AND CURRENT, HOWEVER, IT IS NOT INTENDED FOR ANY LEGAL USE, WHETHER IT BE IN SALES, TRANSFERS, TRADES, LEASES OF ANY TYPE, ETC., AND DO NOT ACCEPT RESPONSIBILITY FOR ERRORS OF ANY NATURE OR OMISSIONS CONTAINED HEREIN.

KX-4