


Washington Twp.

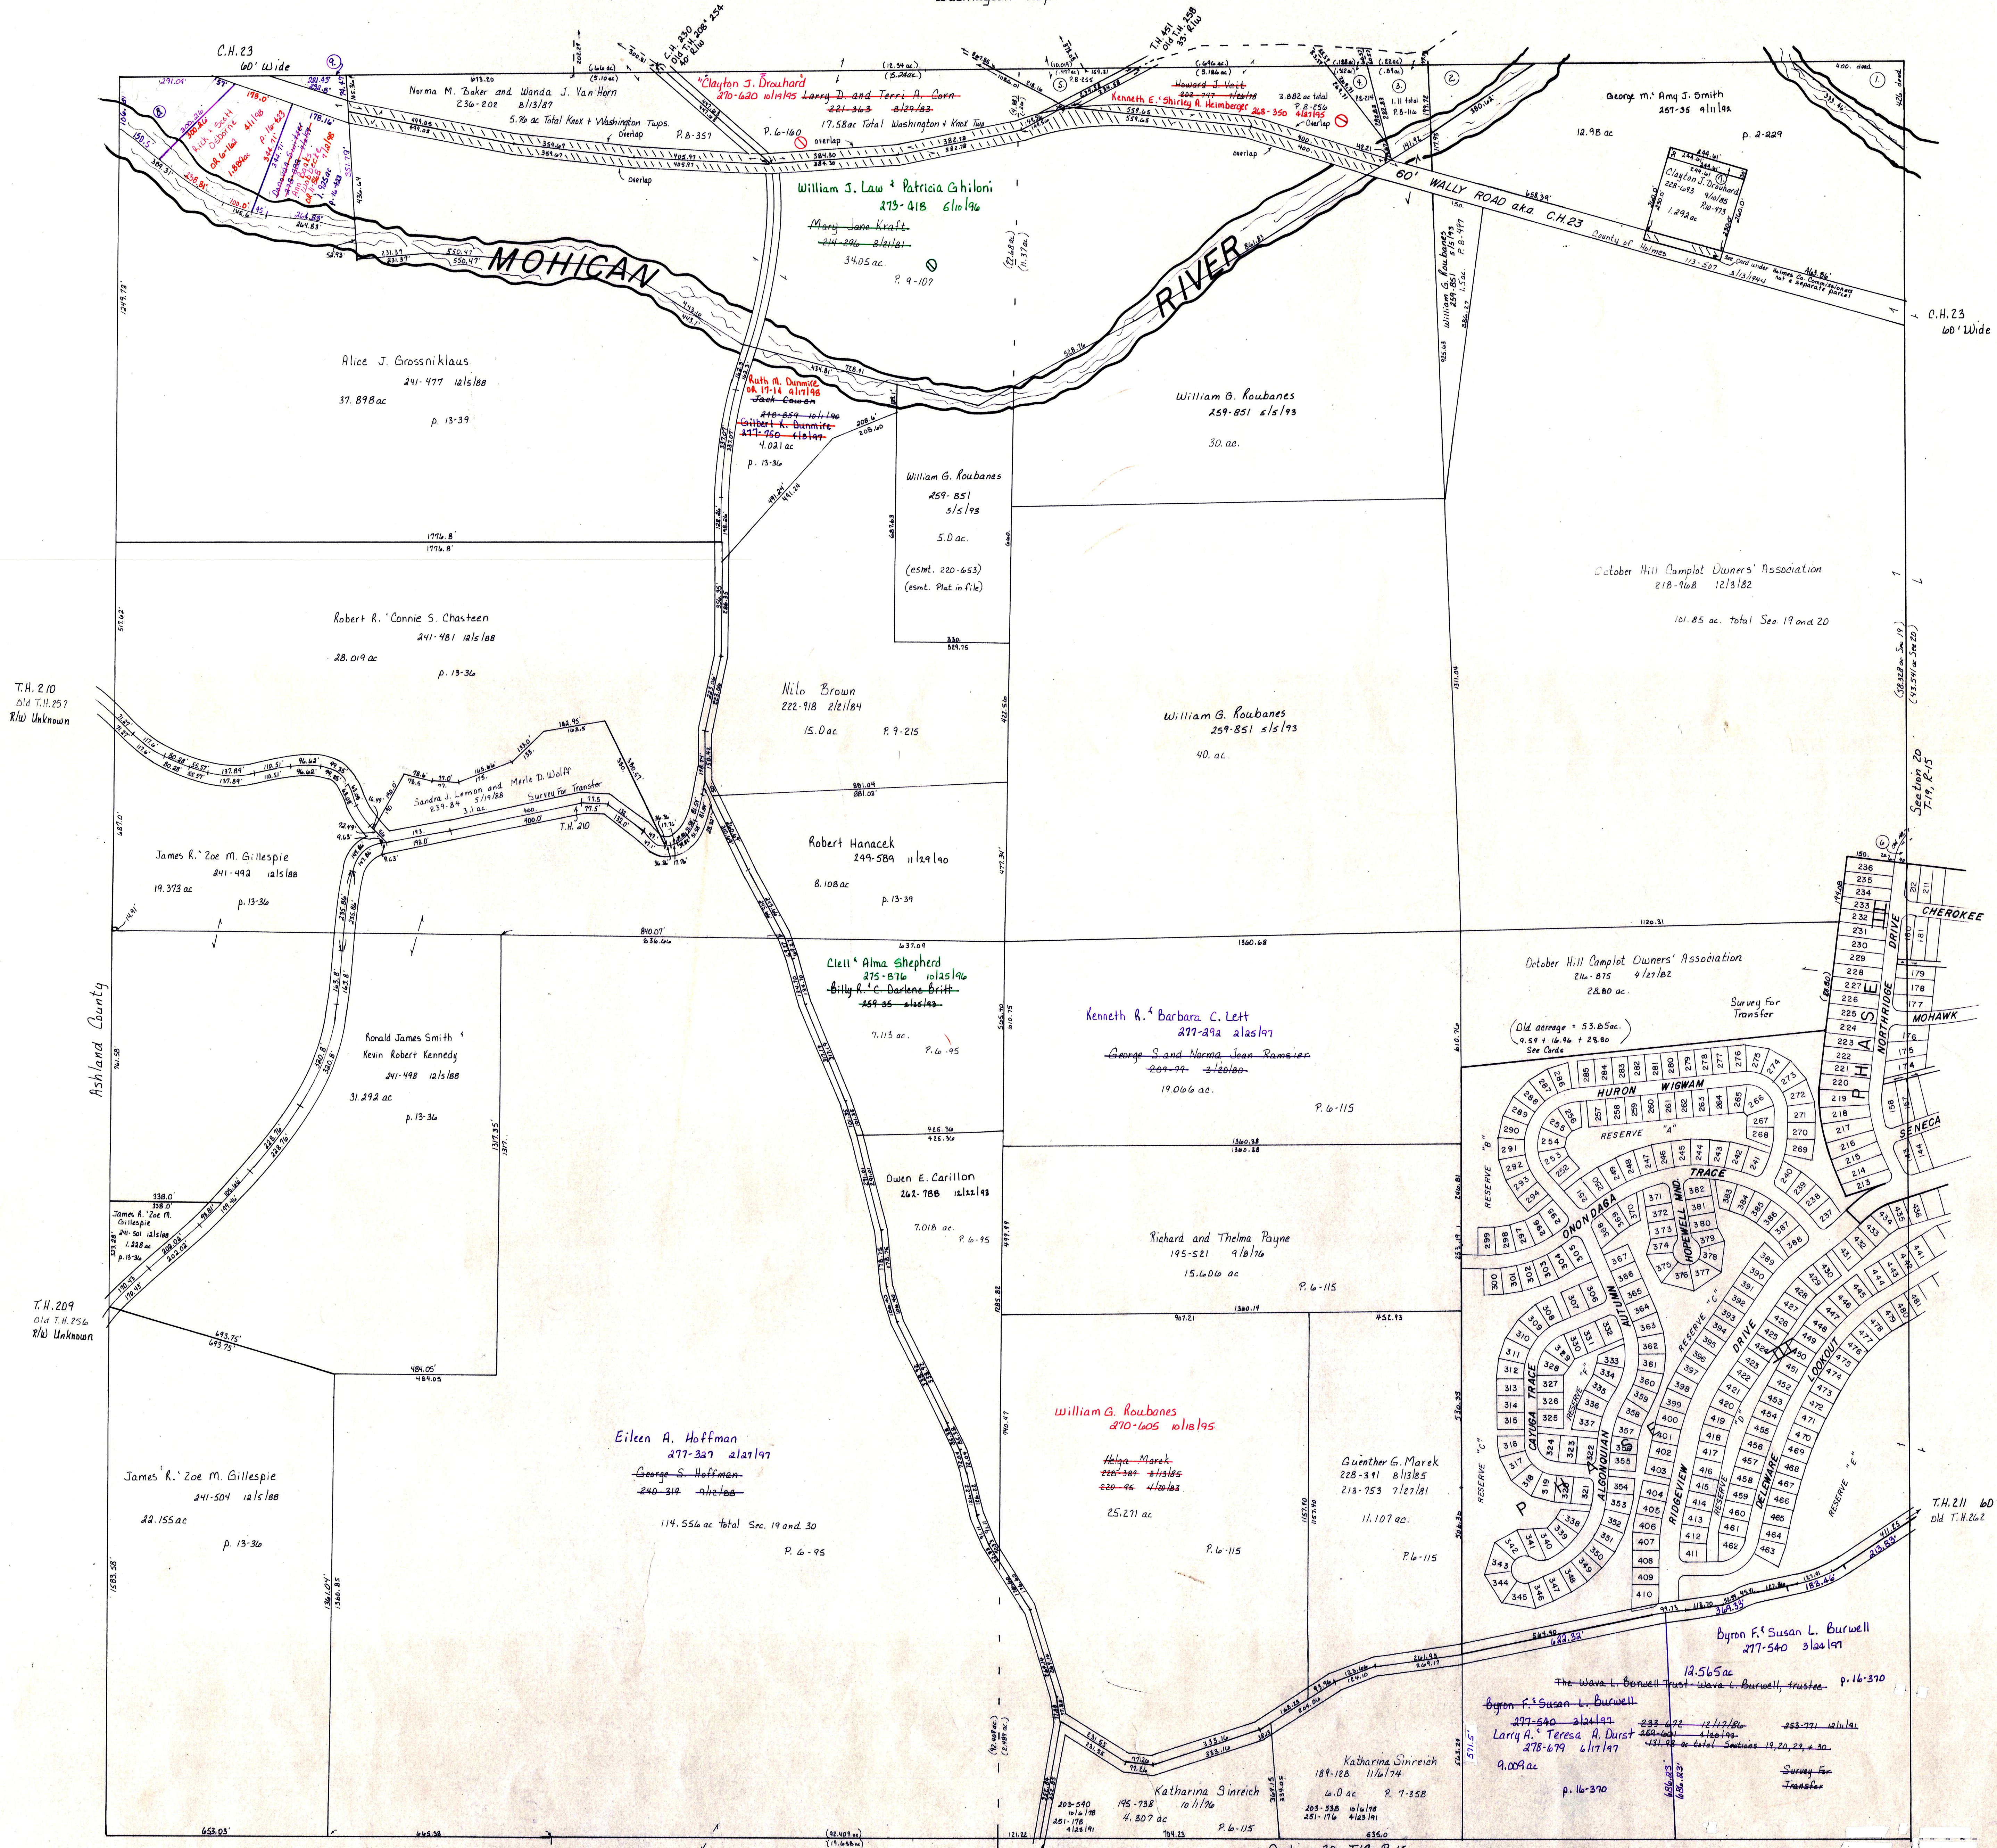

- 1. 1.00 ac Carl and Billie B. Baldner S.F.T. 108-305 11/7/68
- 2. 1.50 ac Carl and Billie B. Baldner S.F.T. 168-385 11/7/68
- 3. .89 ac Robert Goussier - Richard F. Goussier P.B. 116 11/19/88 278-119 2/16/87 Loudonville Canoe Rentals, Inc.
- 4. .312 ac Robert Goussier - Richard F. Goussier P.B. 214 11/19/88 278-119 2/16/87 Loudonville Canoe Rentals, Inc.
- 5. .477 ac Kenneth L. Carol L. Wilson P.B. 255 253-288 11/11/81
- 6. .052 ac October Hill Campsite Owners' Association 216-875 4/21/82
- 7. Clayton J. Draushard 255-236 4/11/82 1/8 ac p. 12-911
- 8. Clement E. Theresa Satigan 278-245 5/15/97 1.02 ac p. 16-223
- 9. Dominick A. Swift 278-119 2/16/87 1.14 ac p. 16-403

KNOX TWP
T-19, R-15
Section 19
SCALE: 1" = 200'

LET IT BE KNOWN, THIS MAP HAS BEEN PREPARED AS A REFERENCE GUIDE TO PROPERTY OWNERSHIP. WE BELIEVE THIS INFORMATION TO BE CORRECT AND CURRENT, HOWEVER, IT IS NOT INTENDED FOR ANY LEGAL USE, WHETHER IT BE IN SALES, TRANSFERS, TRADES, LEASES OF ANY TYPE, ETC., AND DO NOT ACCEPT RESPONSIBILITY FOR ERRORS OF ANY NATURE OR OMISSIONS CONTAINED HEREIN.