


T.H. 466 60'R/W
Old T.H. 271

Washington Twp.

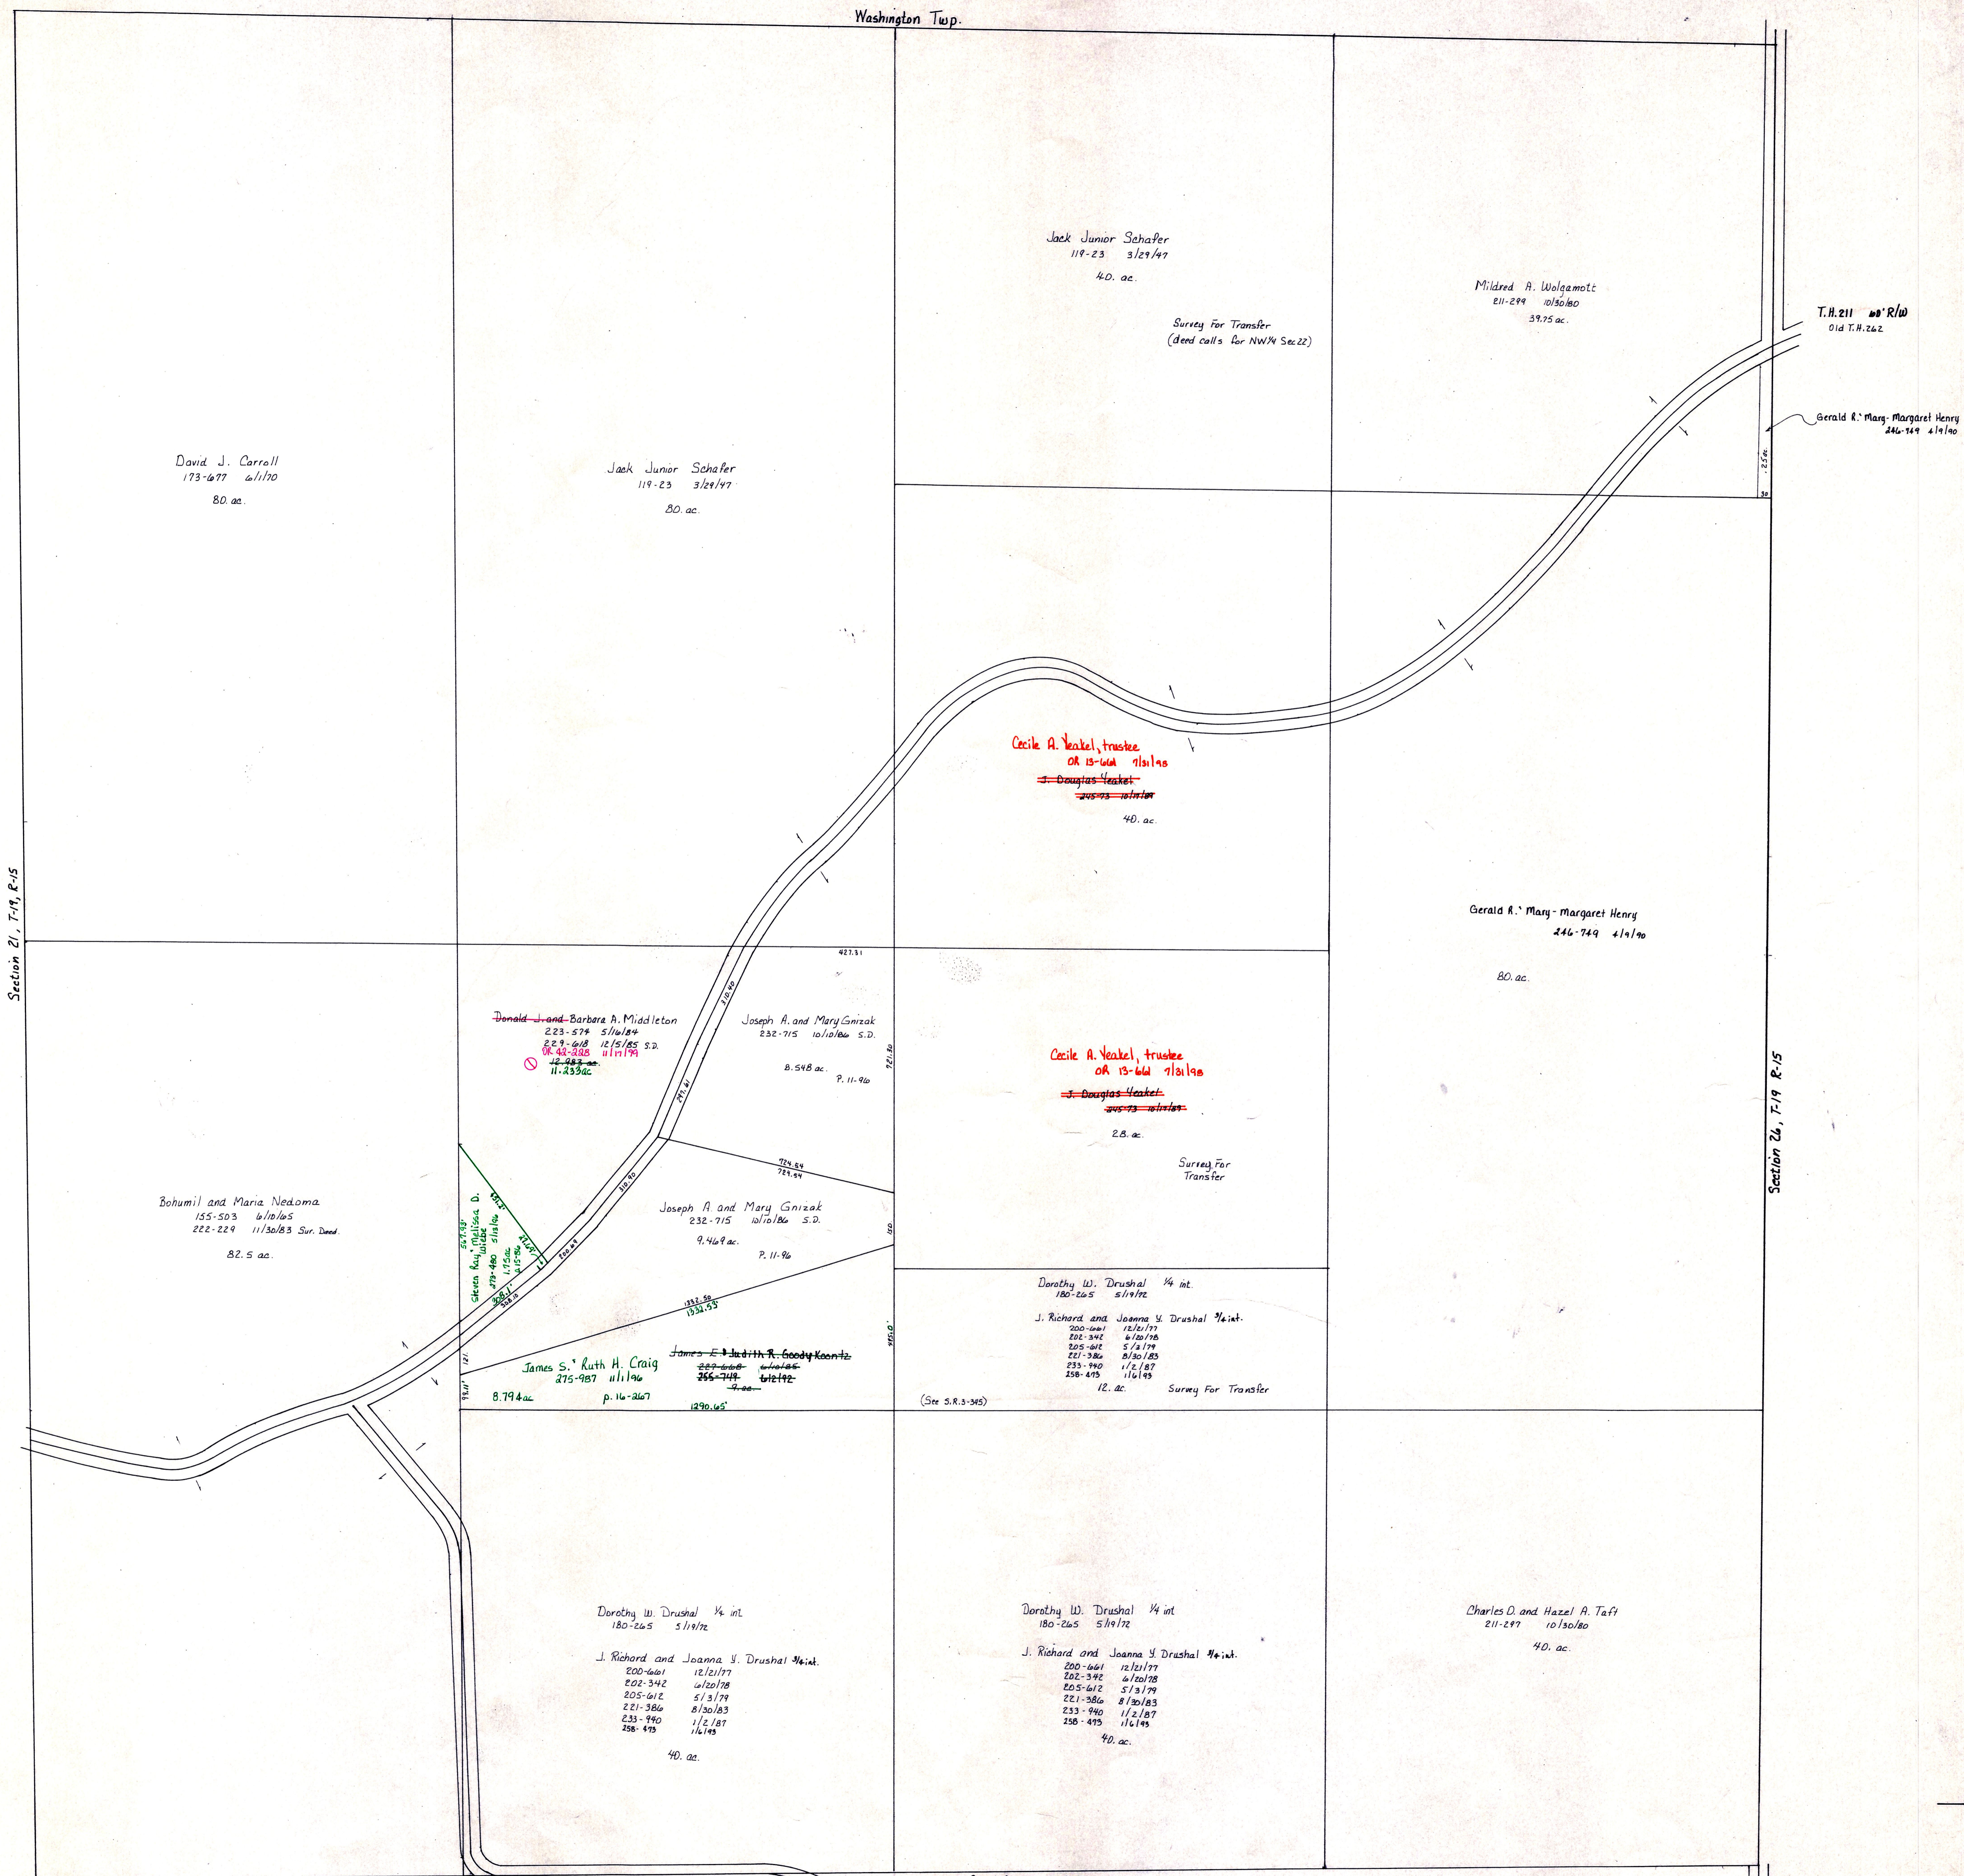

Section 21, T-19, R-15

Section 20, T-19, R-15

Section 27, T-19, R-15

T.H. 211 60'R/W
Old T.H. 262

T.H. 212 60'R/W
Old T.H. 272

T.H. 466 60'R/W
Old T.H. 271

KNOX TWP.
T-19, R-15
Section 22
SCALE 1" = 200'

LET IT BE KNOWN, THIS MAP HAS BEEN PREPARED AS A REFERENCE GUIDE TO PROPERTY OWNERSHIP. WE BELIEVE THIS INFORMATION TO BE CORRECT AND CURRENT, HOWEVER, IT IS NOT INTENDED FOR ANY LEGAL USE, WHETHER IT BE IN SALES, TRANSFERS, TRADES, LEASES OF ANY TYPE, ETC., AND DO NOT ACCEPT RESPONSIBILITY FOR ERRORS OF ANY NATURE OR OMISSIONS CONTAINED HEREIN.

KX-32