


Sec. 9

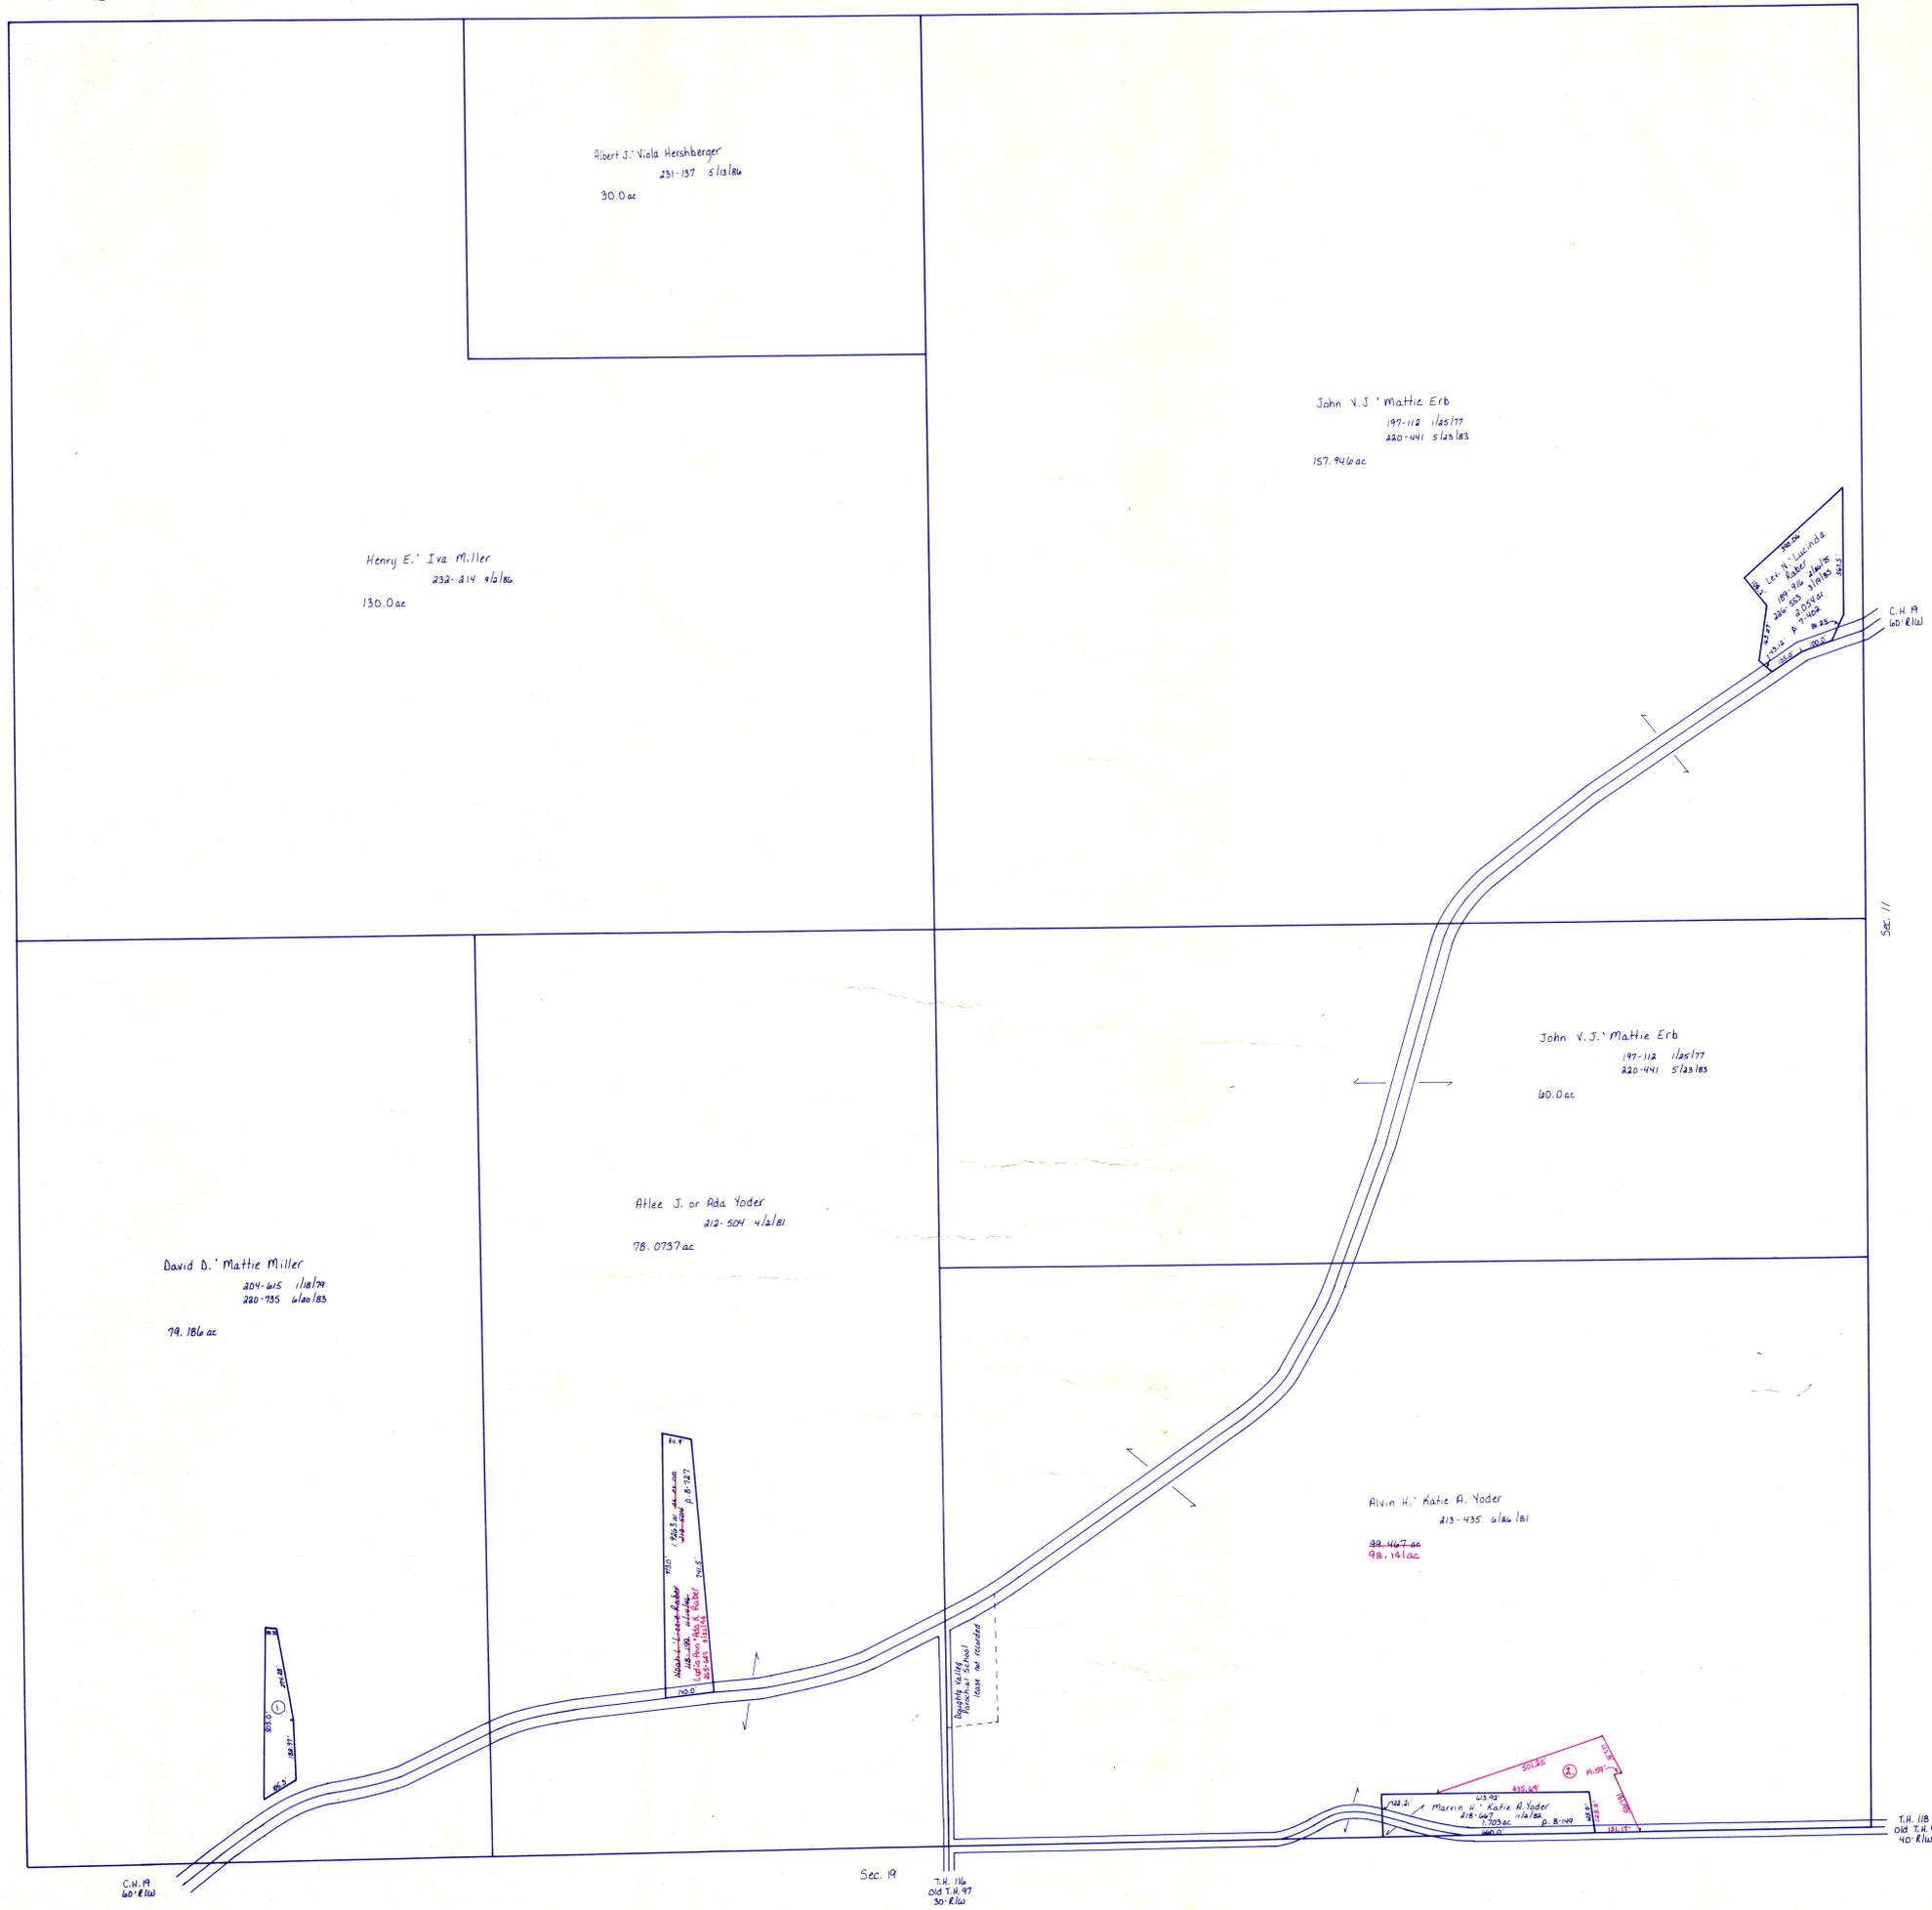

① Atlee D. Amanda N. Schlabach 218-20 s1s17s2 s1s18ac p. 8-334  
205-342 s1s17s2

② Marvin H. Katie A. Yoder 205-421 s1s184 1.323 ac p. 14-569

T-8, R-6, Sec. 12  
MECHANIC TWP.  
SCALE: 1" = 200'

LET IT BE KNOWN, THIS MAP HAS BEEN PREPARED AS A REFERENCE GUIDE TO PROPERTY OWNERSHIP. WE BELIEVE THIS INFORMATION TO BE CORRECT AND CURRENT, HOWEVER, IT IS NOT INTENDED FOR ANY LEGAL USE, WHETHER IT BE IN SALES, TRANSFERS, TRADES, LEASES OF ANY TYPE, ETC. AND DO NOT ACCEPT RESPONSIBILITY FOR ERRORS OF ANY NATURE OR OMISSIONS CONTAINED HEREIN.

MC-300