


T.H. 118
Old T.H. 99
40 E.L.W.

T.H. 118
Old T.H. 99
40 E.L.W.

T.H. 152
Old T.H. 442
66 E.L.W.


T.H. 152
Old T.H. 442
66 E.L.W.

T.H. 117
Old T.H. 410
No E.L.W. record

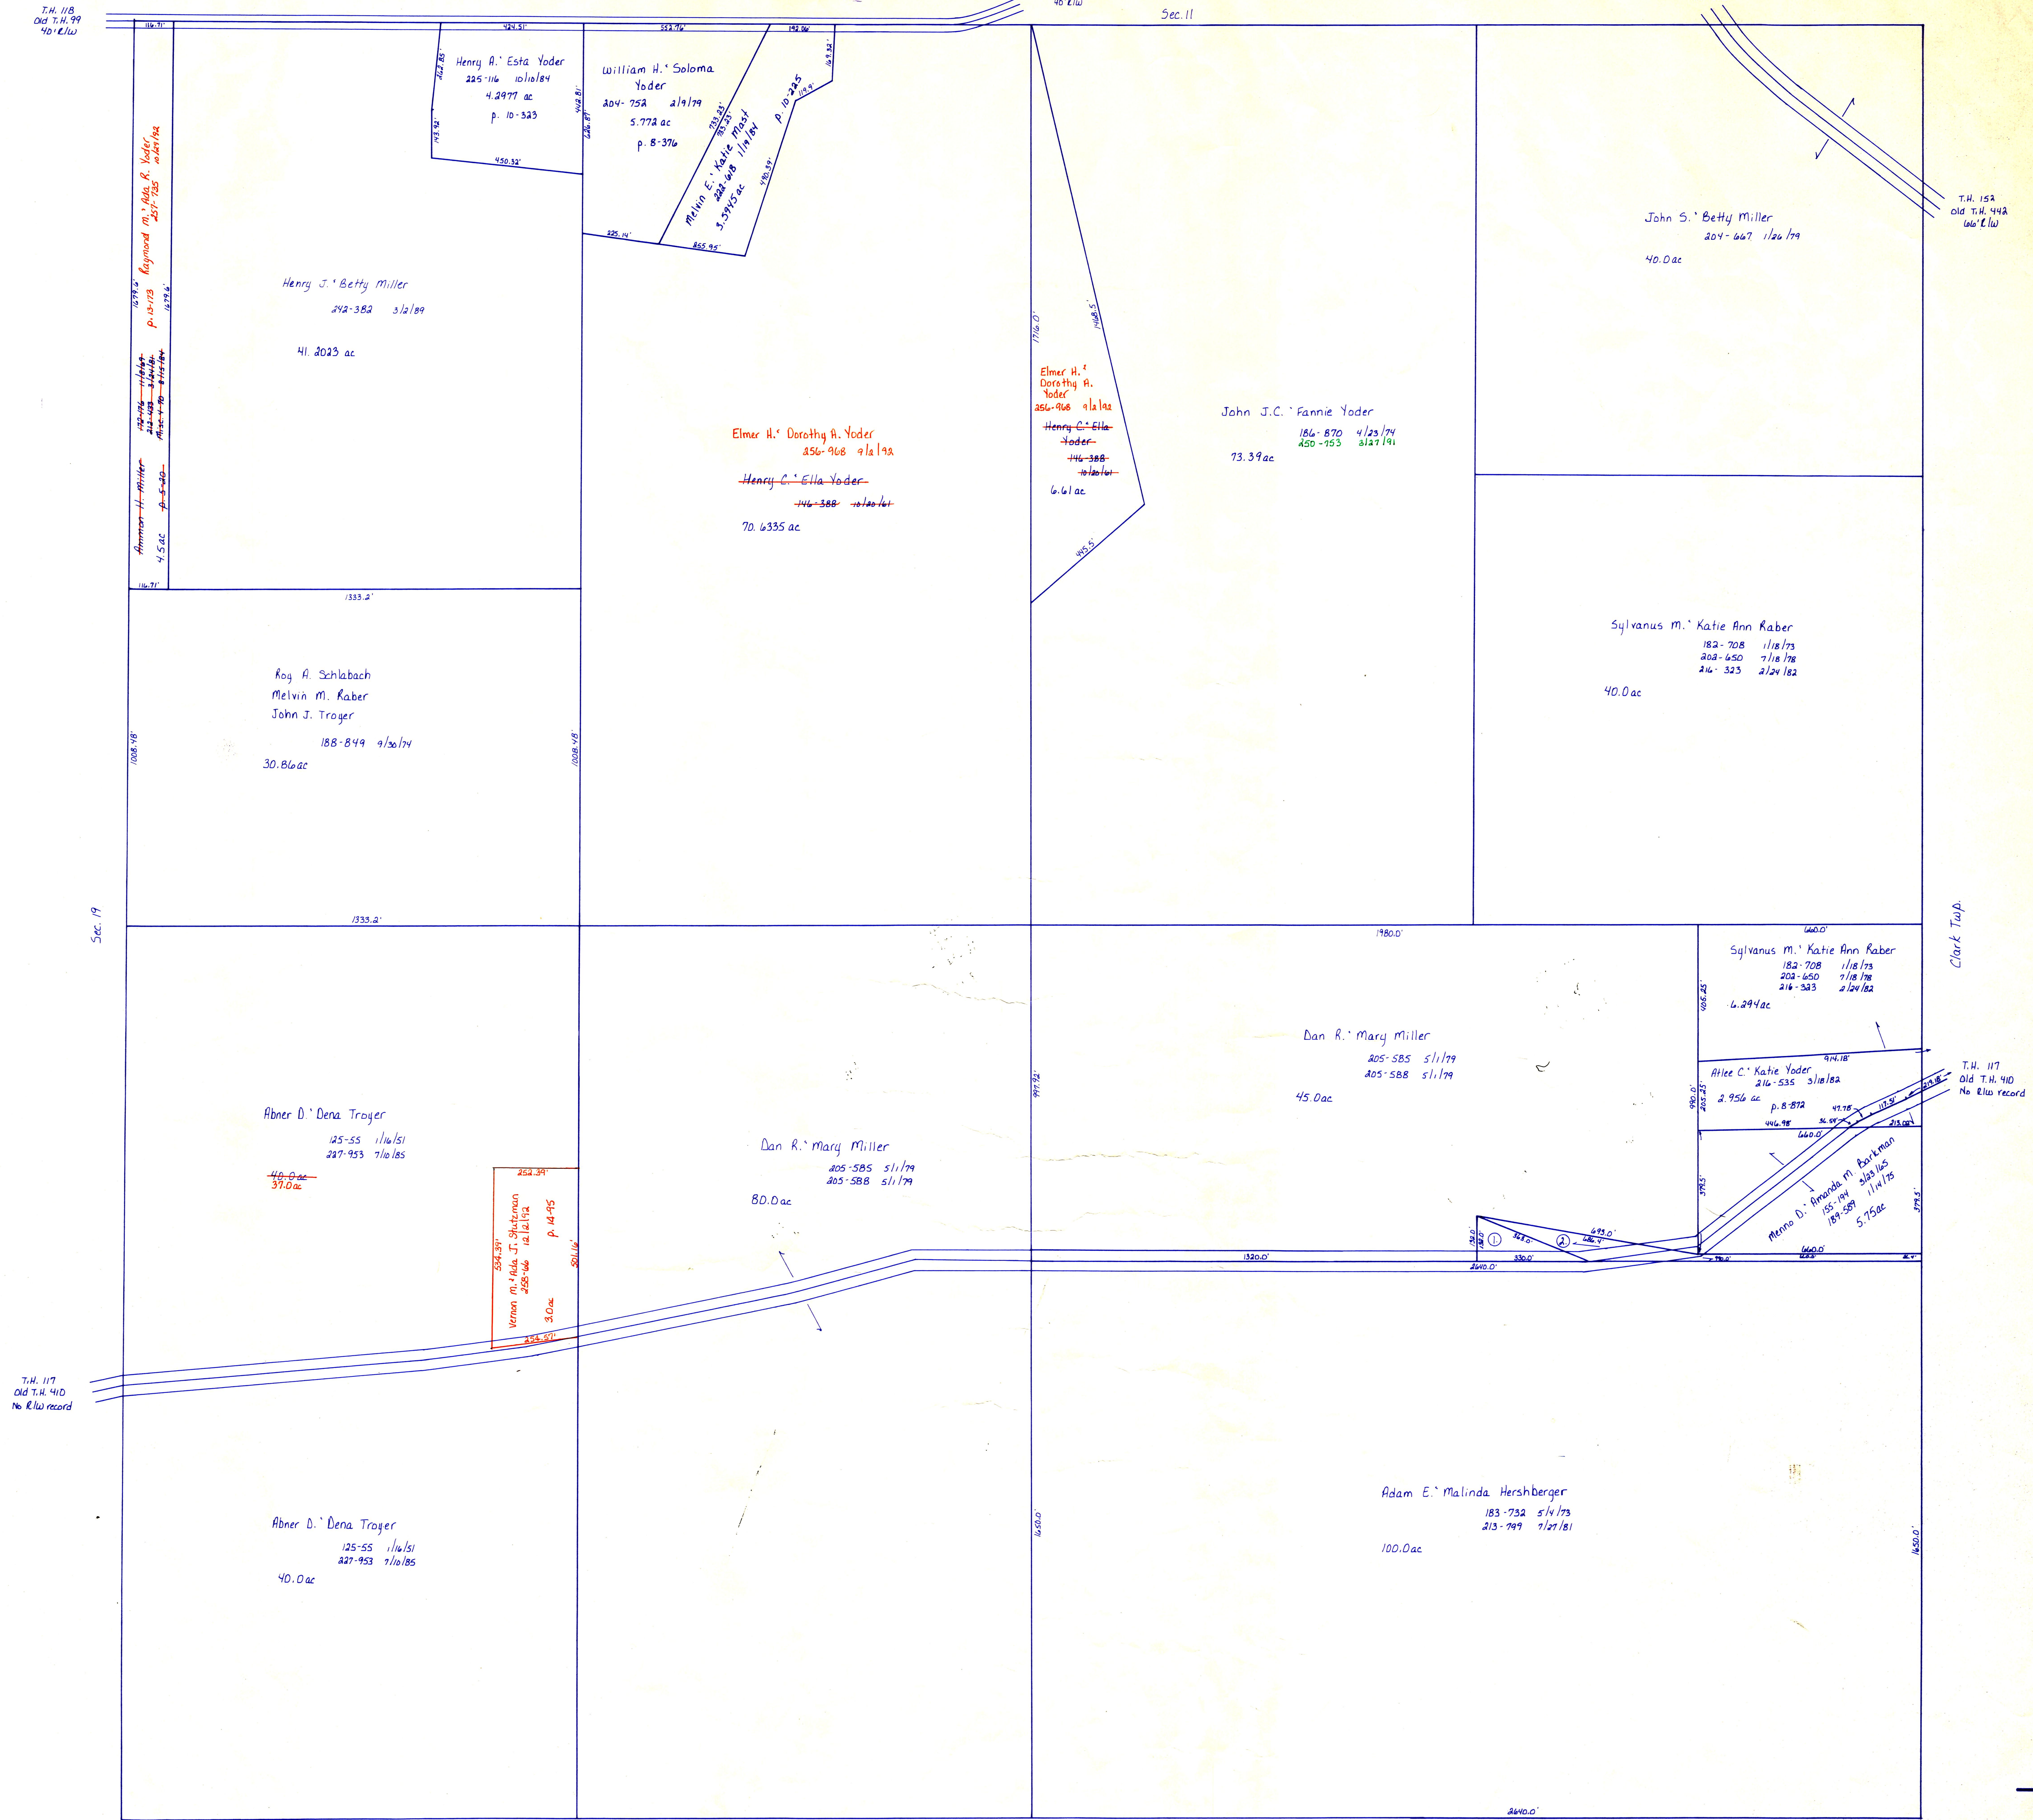

- ① Dan R. & Mary Miller 205-585 588 5/1/79 .5ac
- ② Adam E. & Malinda Hershberger 183-732 5/4/73, 213-799 7/27/81 1.1ac

Sec. 21

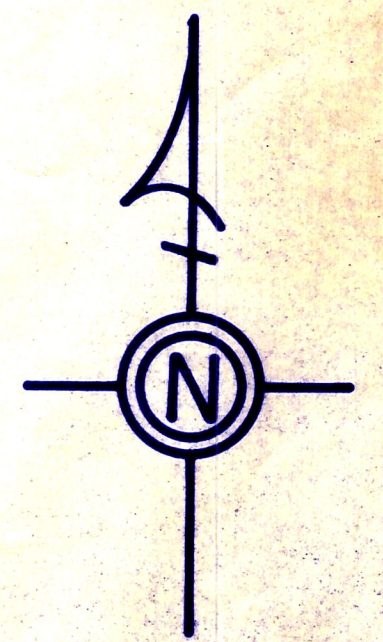

T-8, R-6, Sec. 20
MECHANIC TWP.
SCALE: 1" = 200'

LET IT BE KNOWN, THIS MAP HAS BEEN PREPARED AS A REFERENCE GUIDE TO PROPERTY OWNERSHIP. WE BELIEVE THIS INFORMATION TO BE CORRECT AND CURRENT, HOWEVER, IT IS NOT INTENDED FOR ANY LEGAL USE, WHETHER IT BE IN SALES, TRANSFERS, TRADES, LEASES OF ANY TYPE, ETC., AND DO NOT ACCEPT RESPONSIBILITY FOR ERRORS OF ANY NATURE OR OMISSIONS CONTAINED HEREIN.

MC-341