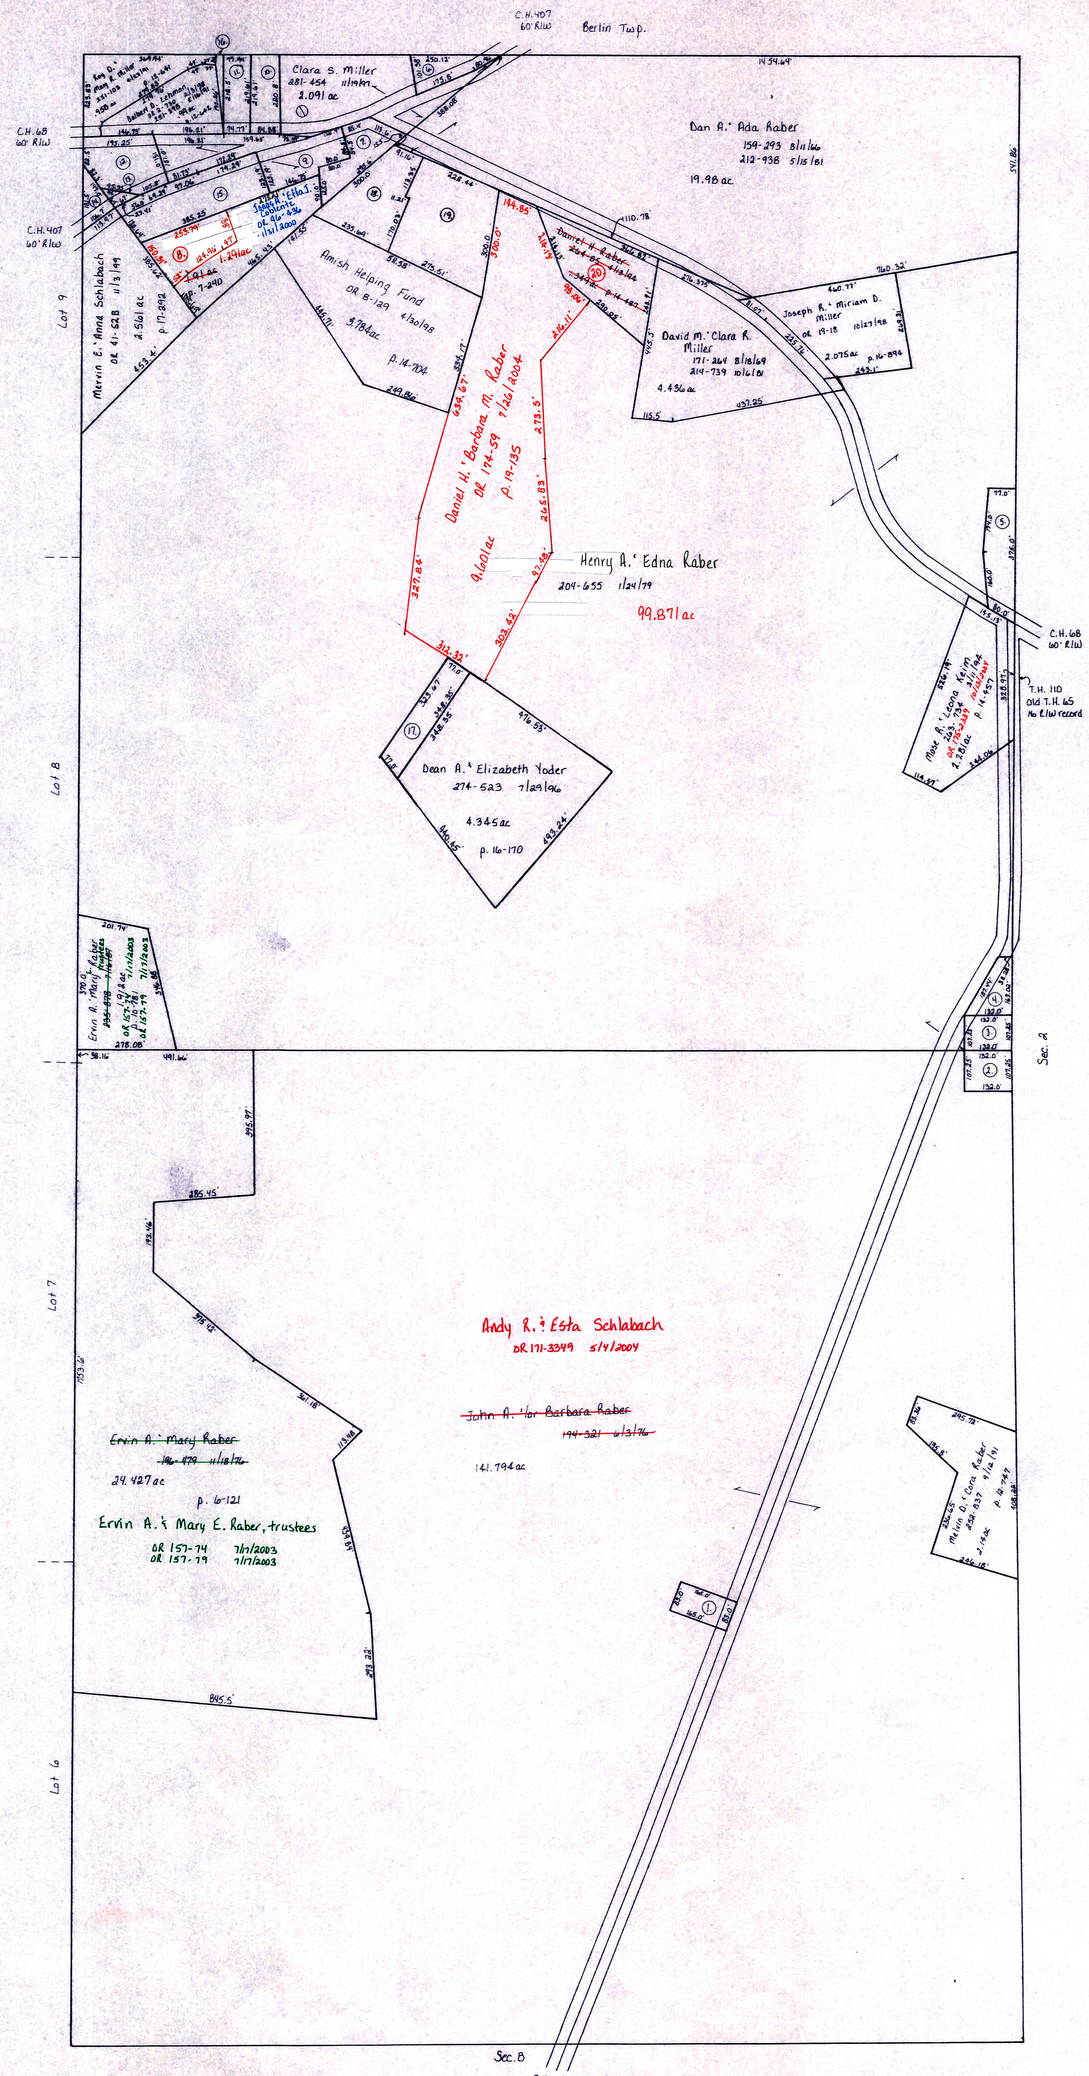

(7) ~~Betty M. & Susan M. & Mary M. Yoder 207-805 11/21/74 .314ac p. 8-523~~

(2) ~~Trustees of the German Reformed & Lutheran Church 4-326 11/7/1913 .325ac~~

(1) ~~Trustees of the German Reformed & Lutheran Church 9-388 11/7/1913 .325ac~~

(4) ~~Trustees of the Salem's Reformed Church 45-547 12/31/1884 .32ac~~

(3) ~~Allen H. & Freda Beachy 258-986 2/17/83 .614ac p. 5-148~~

(6) ~~Andy R. & Salome Yoder OR 41-194 3/30/2000~~

(5) ~~Jonas R. & Effie J. Coblentz OR 41-136 11/9/1999~~

(7) ~~Alvin J. & Rebecca Raber 157-11 2/17/81, 234-10 7/27/88 .78ac p. 4-103~~

(8)

(9) ~~Delbert D. Lehman OR 2-730 251-898 5/16/91 1.312ac p. 12-642~~
~~2/3/98~~

(10) ~~Roy D. & Mary R. Miller 214-527 11/17/81 .416ac p. 7-109~~

(11) ~~Roy D. & Mary R. Miller 214-589 11/17/81 .384ac p. 7-109~~

(12) ~~Henry M. & Katie Yoder 272-694 3/22/96 .962ac p. 5-22~~
~~279-510 8/14/97~~

(13) ~~Evan R. "Estate" 252-866 4/17/91, 259-641 4/23/93 .05ac~~

(14) ~~Evan R. "Estate" 252-866 4/17/91, 259-641 4/23/93 .18ac~~

(15) ~~John Henry & Mary J. Beachy 208-217 12/17/79 1.147ac p. 8-530~~

(16) ~~Roy D. & Mary R. Miller 251-103 4/23/91 .051ac p. 12-642~~

(17) ~~Dean A. & Elizabeth Yoder 277-243 2/21/97 .577ac p. 16-364~~

(8) ~~Mary E. Raber OR 38-3 9/1/88 1.064ac p. 17-237~~

(A) ~~Nancy & Marvin E. & Mary E. Raber 1.636ac p. 7-294~~
~~203-892 2/17/81 251-352 5/16/91~~

T-8, R-6, Sec. 3
MECHANIC TWP.

SCALE: 1" = 200'

LET IT BE KNOWN, THIS MAP HAS BEEN PREPARED AS A REFERENCE GUIDE TO PROPERTY OWNERSHIP. WE BELIEVE THIS INFORMATION TO BE CORRECT AND CURRENT, HOWEVER, IT IS NOT INTENDED FOR ANY LEGAL USE, WHETHER IT BE IN SALES, TRANSFERS, TRADES, LEASES OF ANY TYPE, ETC., AND DO NOT ACCEPT RESPONSIBILITY FOR ERRORS OF ANY NATURE OR OMISSIONS CONTAINED HEREIN.

MC-27