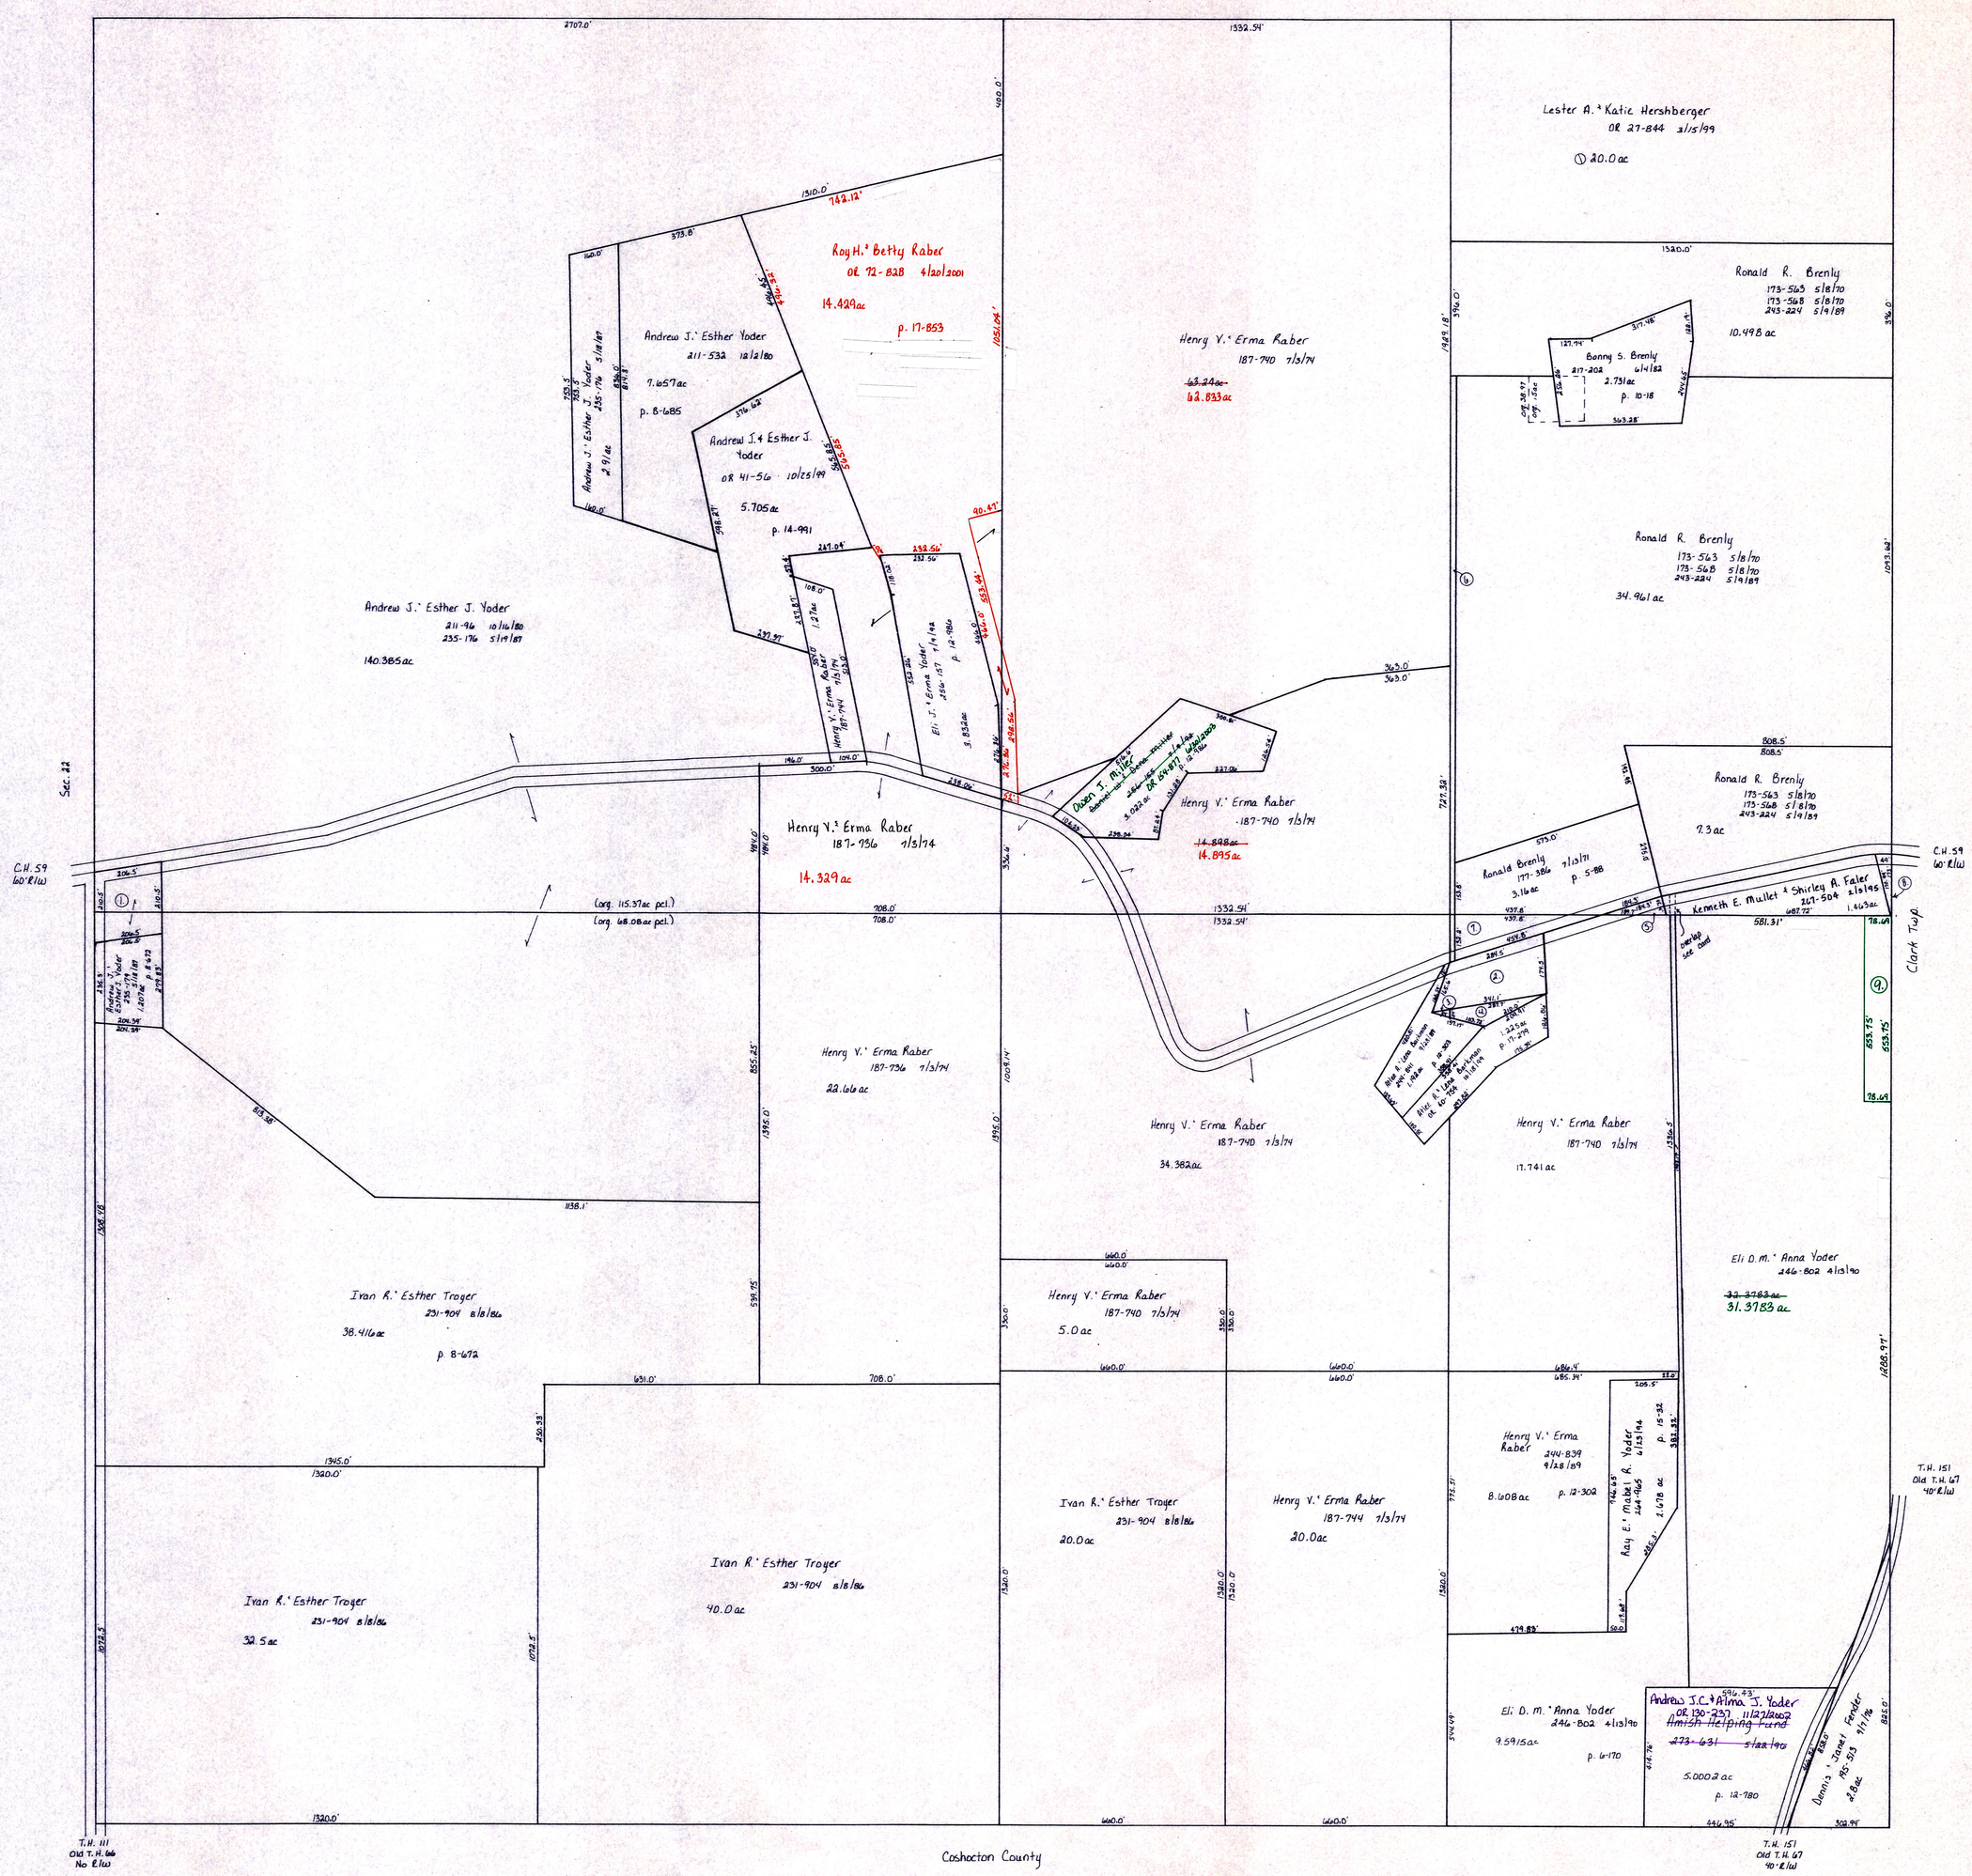

1. ~~Andrew J.' Esther J. Yoder 235-179 5/18/87 1.0ac~~
2. ~~Alice A.' Lena Barkman 242-75 1/23/89 1.12ac p. 5-52, p. 7-317~~
3. ~~Alice A.' Lena Barkman 242-75 1/23/89 .08ac p. 7-318~~
4. ~~Alice A.' Lena Barkman 242-75 1/23/89 .85ac p. 7-318~~
5. ~~Henry V.' Erma Raber 187-744 7/3/74 .12ac p. 5-88~~
6. ~~Ronald R. Brenly OR 18-142 10/1/88 .55ac~~
7. ~~Ronald R. Brenly 173-563 5/8/70, 173-568 5/8/70, 243-224 5/9/89 .16ac~~
8. ~~Lester E.' Mattie L. Yoder OR 33-578 6/10/99 .097ac p. 17-141~~
9. 1.463ac

T-8, R-6, Sec. 21
MECHANIC TWP.

SCALE: 1" = 200'

LET IT BE KNOWN, THIS MAP HAS BEEN PREPARED AS A REFERENCE GUIDE TO PROPERTY OWNERSHIP. WE BELIEVE THIS INFORMATION TO BE CORRECT AND CURRENT, HOWEVER, IT IS NOT INTENDED FOR ANY LEGAL USE, WHETHER IT BE IN SALES, TRANSFERS, TRADES, LEASES OF ANY TYPE, ETC., AND DO NOT ACCEPT RESPONSIBILITY FOR ERRORS OF ANY NATURE OR OMISSIONS CONTAINED HEREIN.

MC-33