



SEE M-6
O.L. 82

SEE M-7
O.L. 83

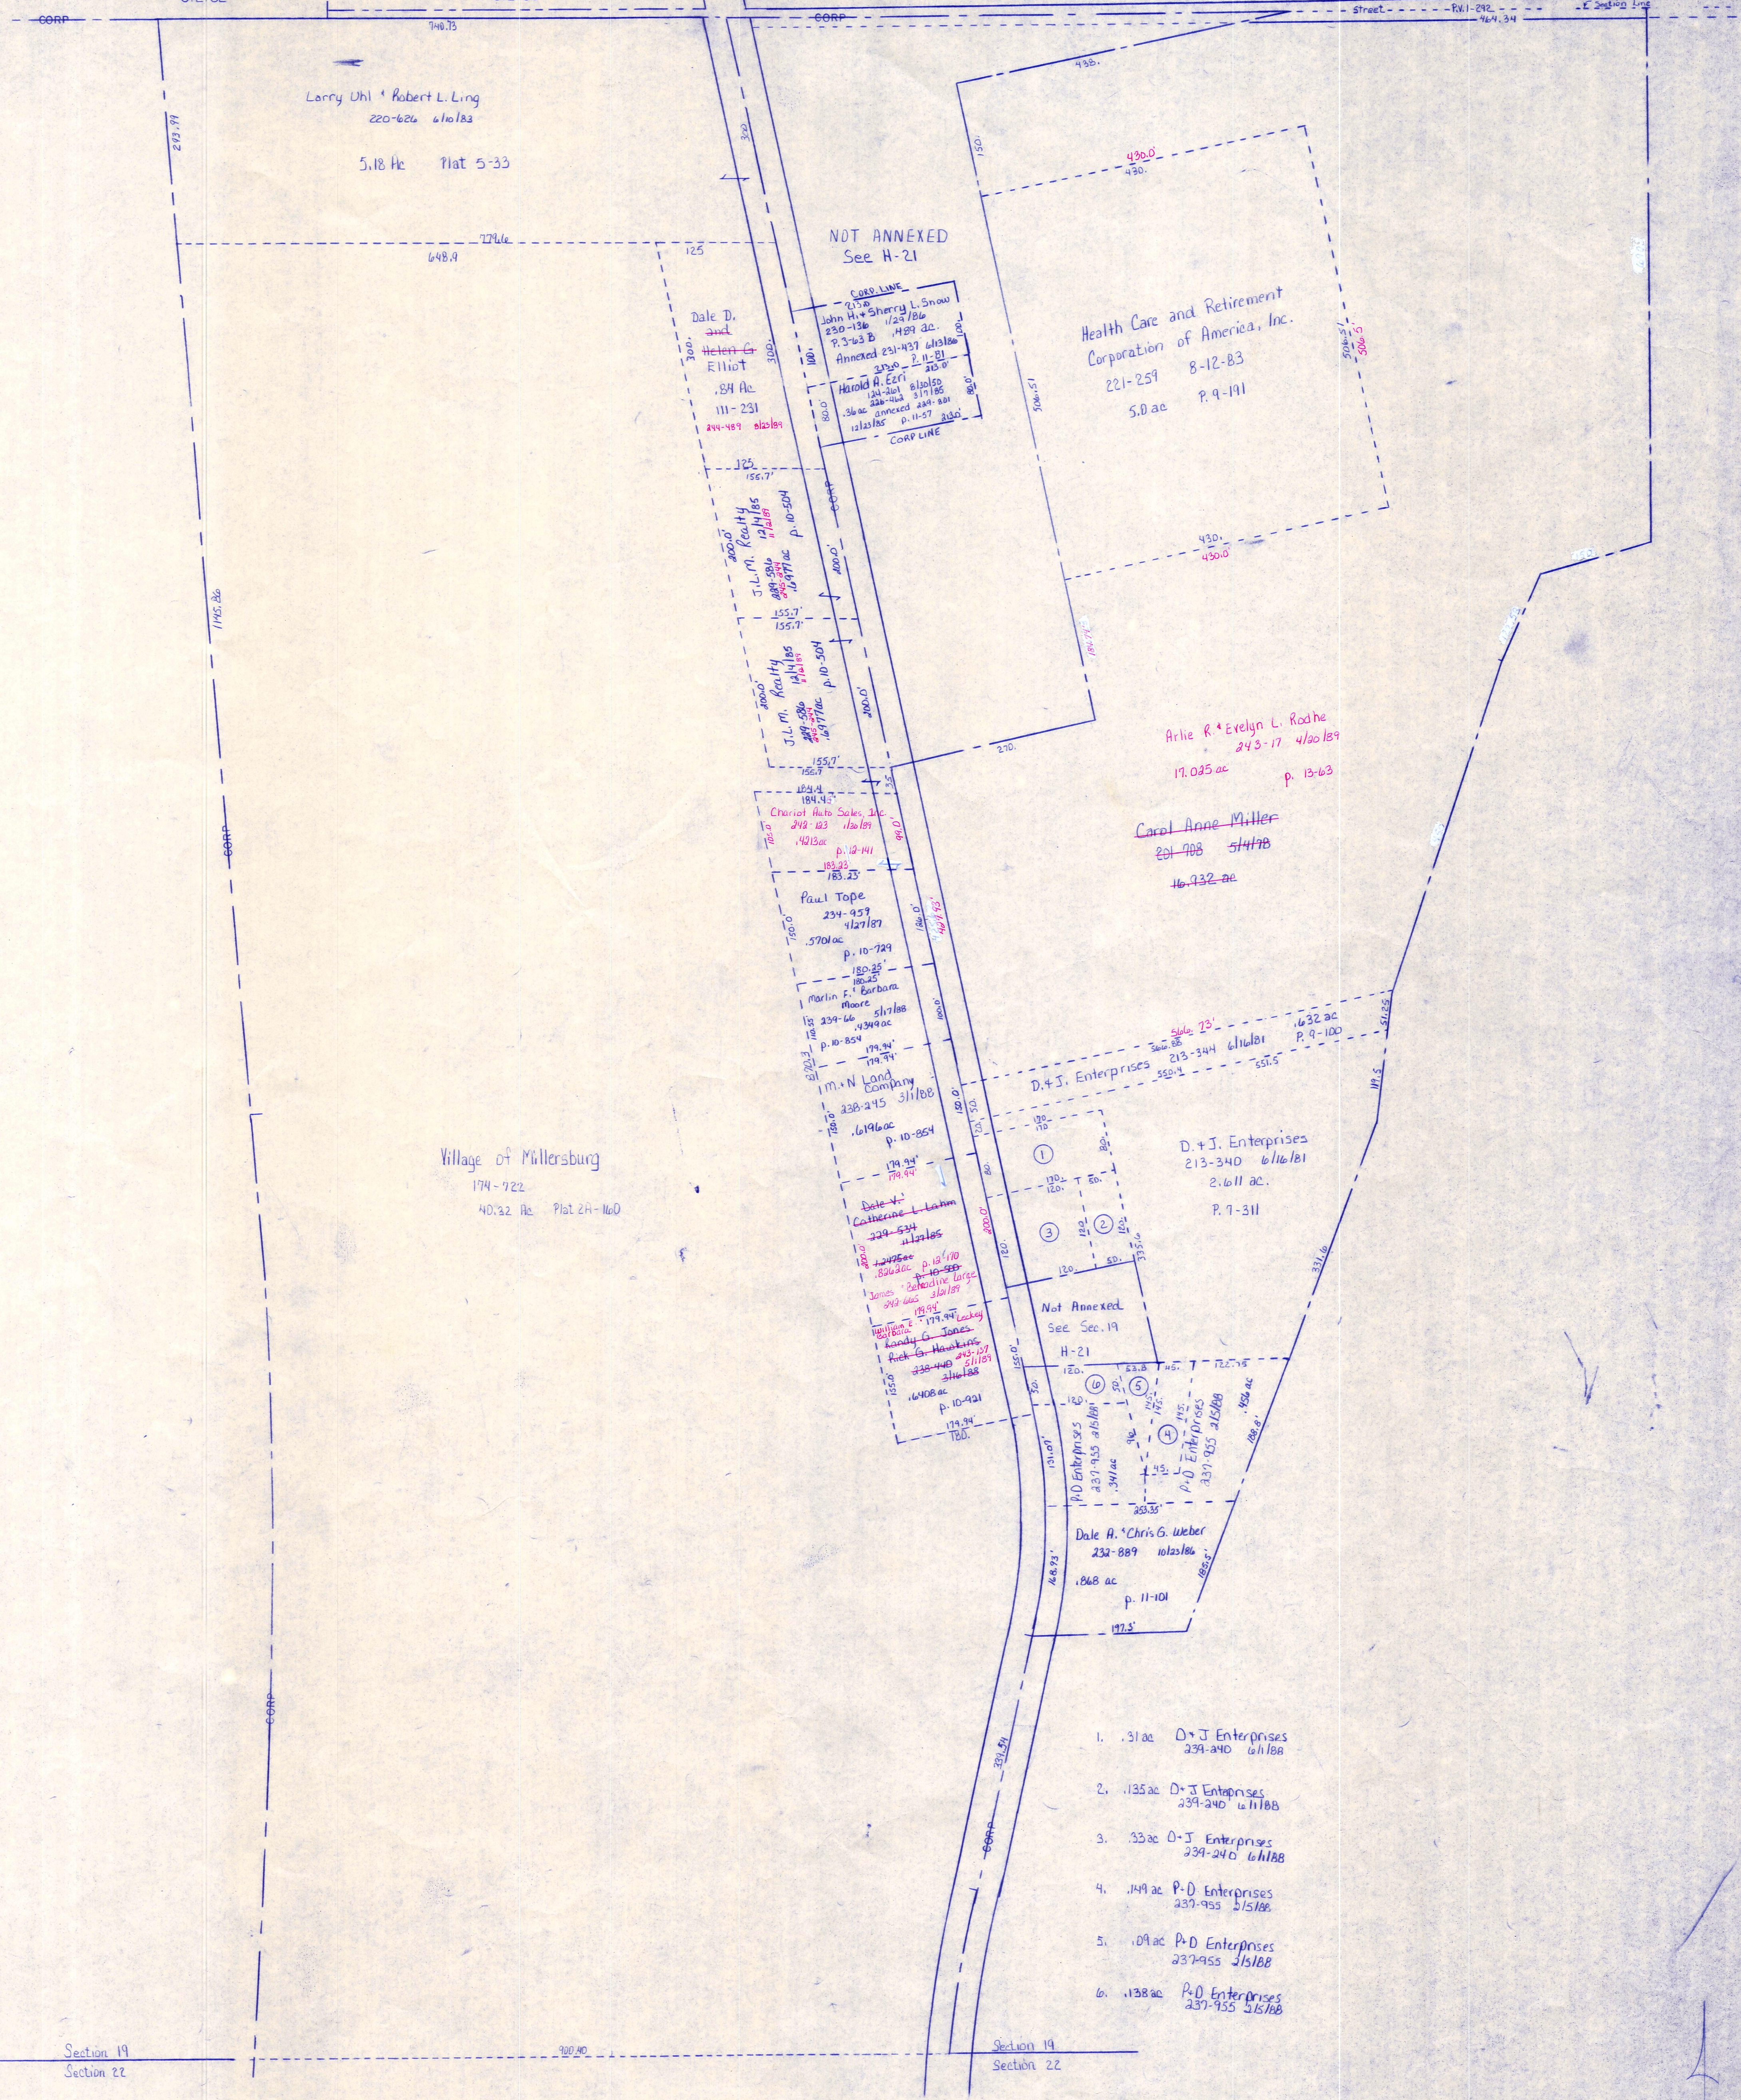

1. .31 ac D+J Enterprises 239-240 6/1/88
2. .135 ac D+J Enterprises 239-240 6/1/88
3. .33 ac D+J Enterprises 239-240 6/1/88
4. .149 ac P.O. Enterprises 237-235 2/5/88
5. .09 ac P.O. Enterprises 237-235 2/5/88
6. .138 ac P.O. Enterprises 237-235 2/5/88

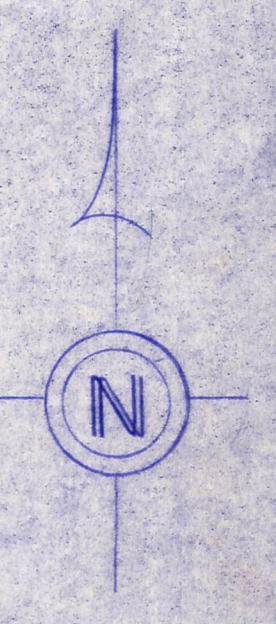

MILLERSBURG VILLAGE
SCALE 1" = 100'

LET IT BE KNOWN, THIS MAP HAS BEEN PREPARED AS A REFERENCE GUIDE TO PROPERTY OWNERSHIP. WE BELIEVE THIS INFORMATION TO BE CORRECT AND CURRENT, HOWEVER, IT IS NOT INTENDED FOR ANY LEGAL USE, WHETHER IT BE IN SALES, TRANSFERS, TRADES, LEASES OF ANY TYPE, ETC. AND DO NOT ACCEPT RESPONSIBILITY FOR ERRORS OF ANY NATURE OR OMISSIONS CONTAINED HEREIN.

MIV-8