


Plat Vol. 3 Pg 13
Ord. No. 496 Ord. No. 5-284
Vacated Alley

see mv-12

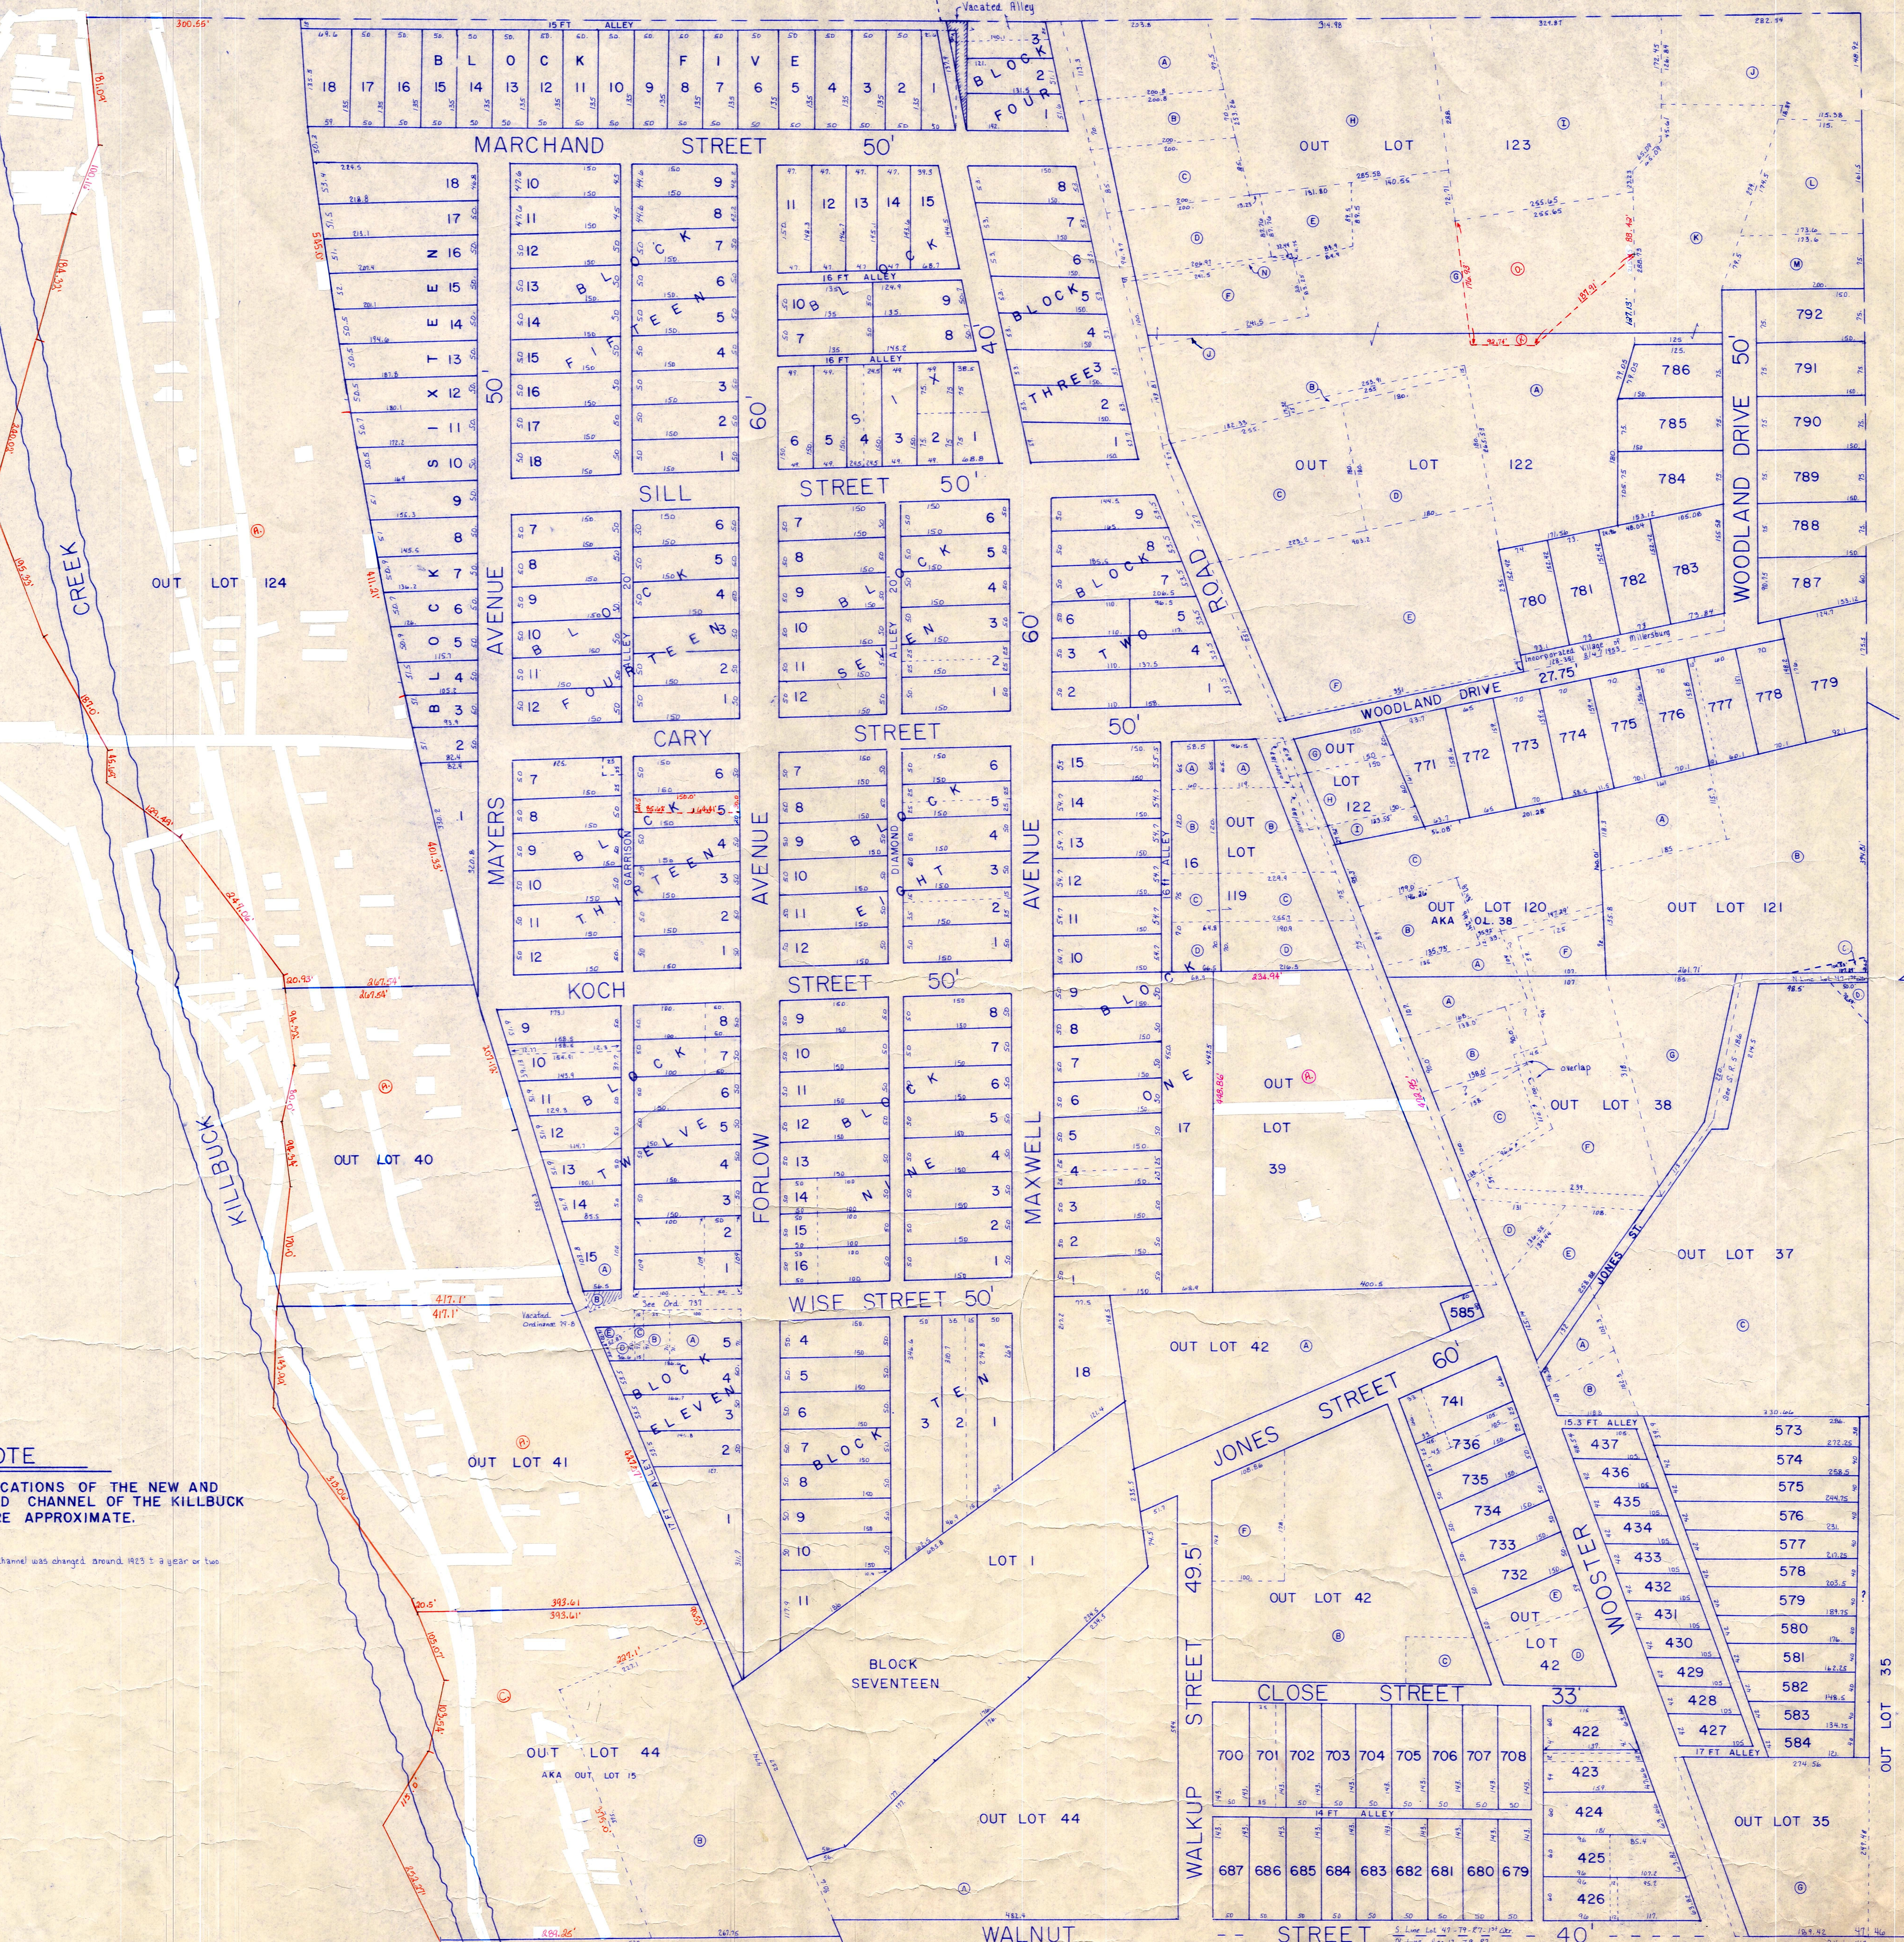


NOTE

LOCATIONS OF THE NEW AND OLD CHANNEL OF THE KILLBUCK ARE APPROXIMATE.

Channel was changed around 1825 to a year or two

SEE MV-2

SEE MV-3

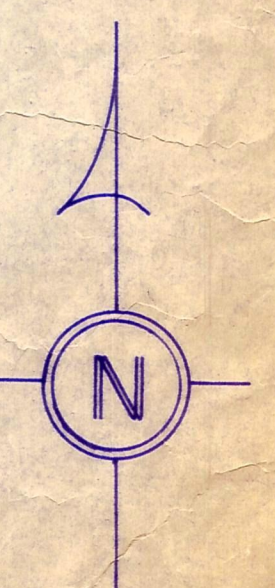

SCALE 1" = 100'

MILLERSBURG VILLAGE
HARDY TOWNSHIP

T-9, R-7, 1st Qtr., Lots 42 + 47

LET IT BE KNOWN THIS MAP HAS BEEN PREPARED AS A REFERENCE GUIDE TO PROPERTY OWNERSHIP AND CURRENT, HOWEVER, IT IS NOT INTENDED FOR ANY LEGAL USE, WHETHER IT BE IN SALES, TRANSFERS, TRUSTS, LEASES OF ANY TYPE, ETC., AND DO NOT ACCEPT RESPONSIBILITY FOR ERRORS OF ANY NATURE OR OMISSIONS CONTAINED HEREIN.

MV-1