

SEE M-3

Old Creek By D.V. 14-206

OUT LOT 61

OUT LOT 60

OUT LOT 59

OUT LOT 57

OUT LOT 62

OUT LOT 63

OUT LOT 64

OUT LOT 65

OUT LOT 66

OUT LOT 73  
AKA O.L. 62


OUT LOT 72

OUT LOT 71

OUT LOT 70

OUT LOT 69

OUT LOT 67

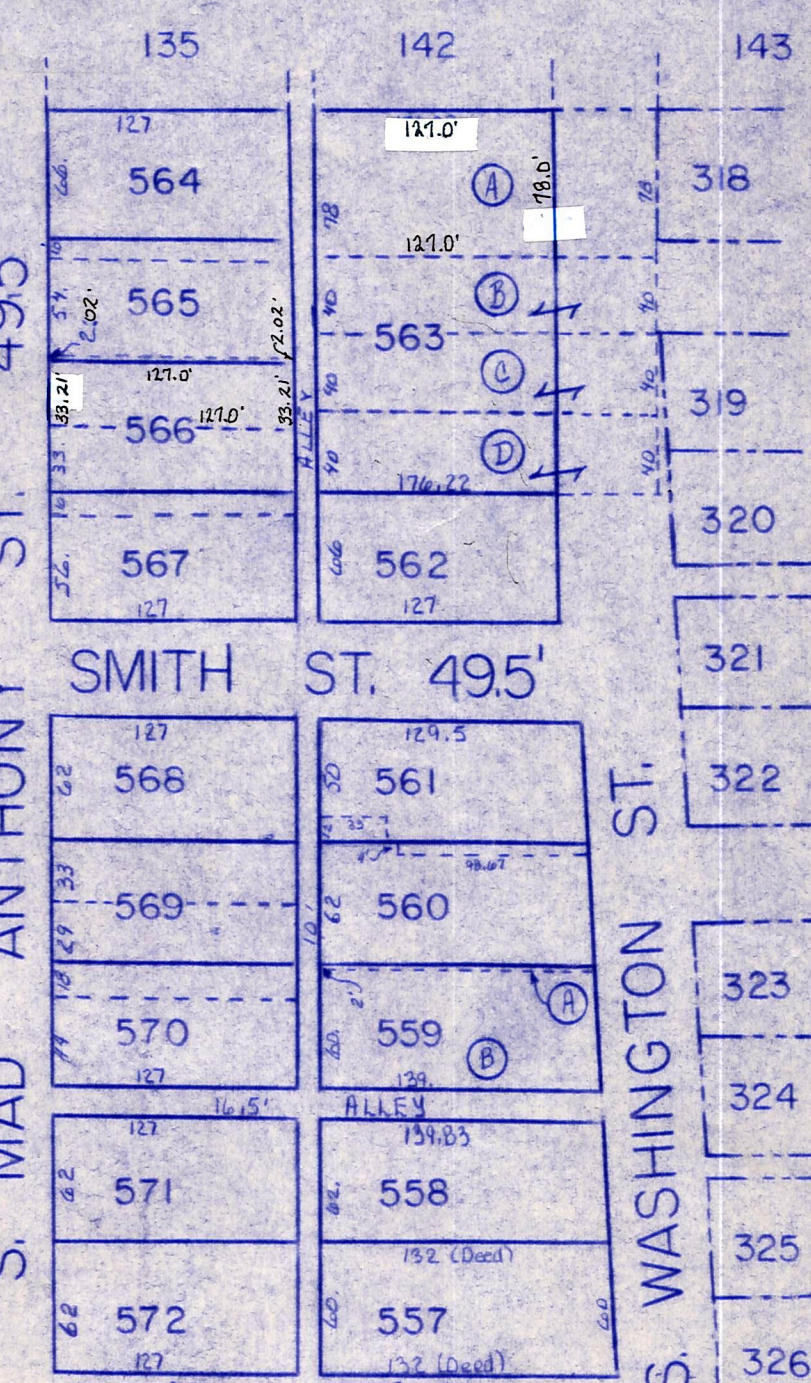

OUT LOT 103

590

591

592

593

594

OUT LOT 86

OUT LOT 85

OUT LOT 84

OUT LOT 83

SEE M-7


LOCATIONS OF THE NEW AND OLD CHANNEL OF THE KILLBUCK CREEK ARE APPROXIMATE.

KILLBUCK CREEK

OUT LOT 81

OUT LOT 82

SEE M-8

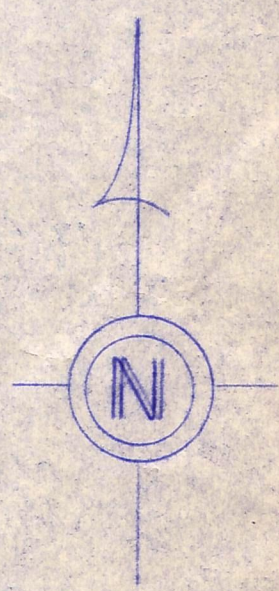

MILLERSBURG VILLAGE

SCALE 1"=100'

LET IT BE KNOWN THIS MAP HAS BEEN PREPARED AS A REFERENCE GUIDE TO PROPERTY OWNERSHIP. WE BELIEVE THIS INFORMATION TO BE CORRECT AND CURRENT, HOWEVER, IT IS NOT INTENDED FOR ANY LEGAL USE, WHETHER IT BE IN SALES, TRANSFERS, TRADES, LEASES OF ANY TYPE, ETC., AND DO NOT ACCEPT RESPONSIBILITY FOR ERRORS OF ANY NATURE OR OMISSIONS CONTAINED HEREIN.

MIV-6