


SEE M-1

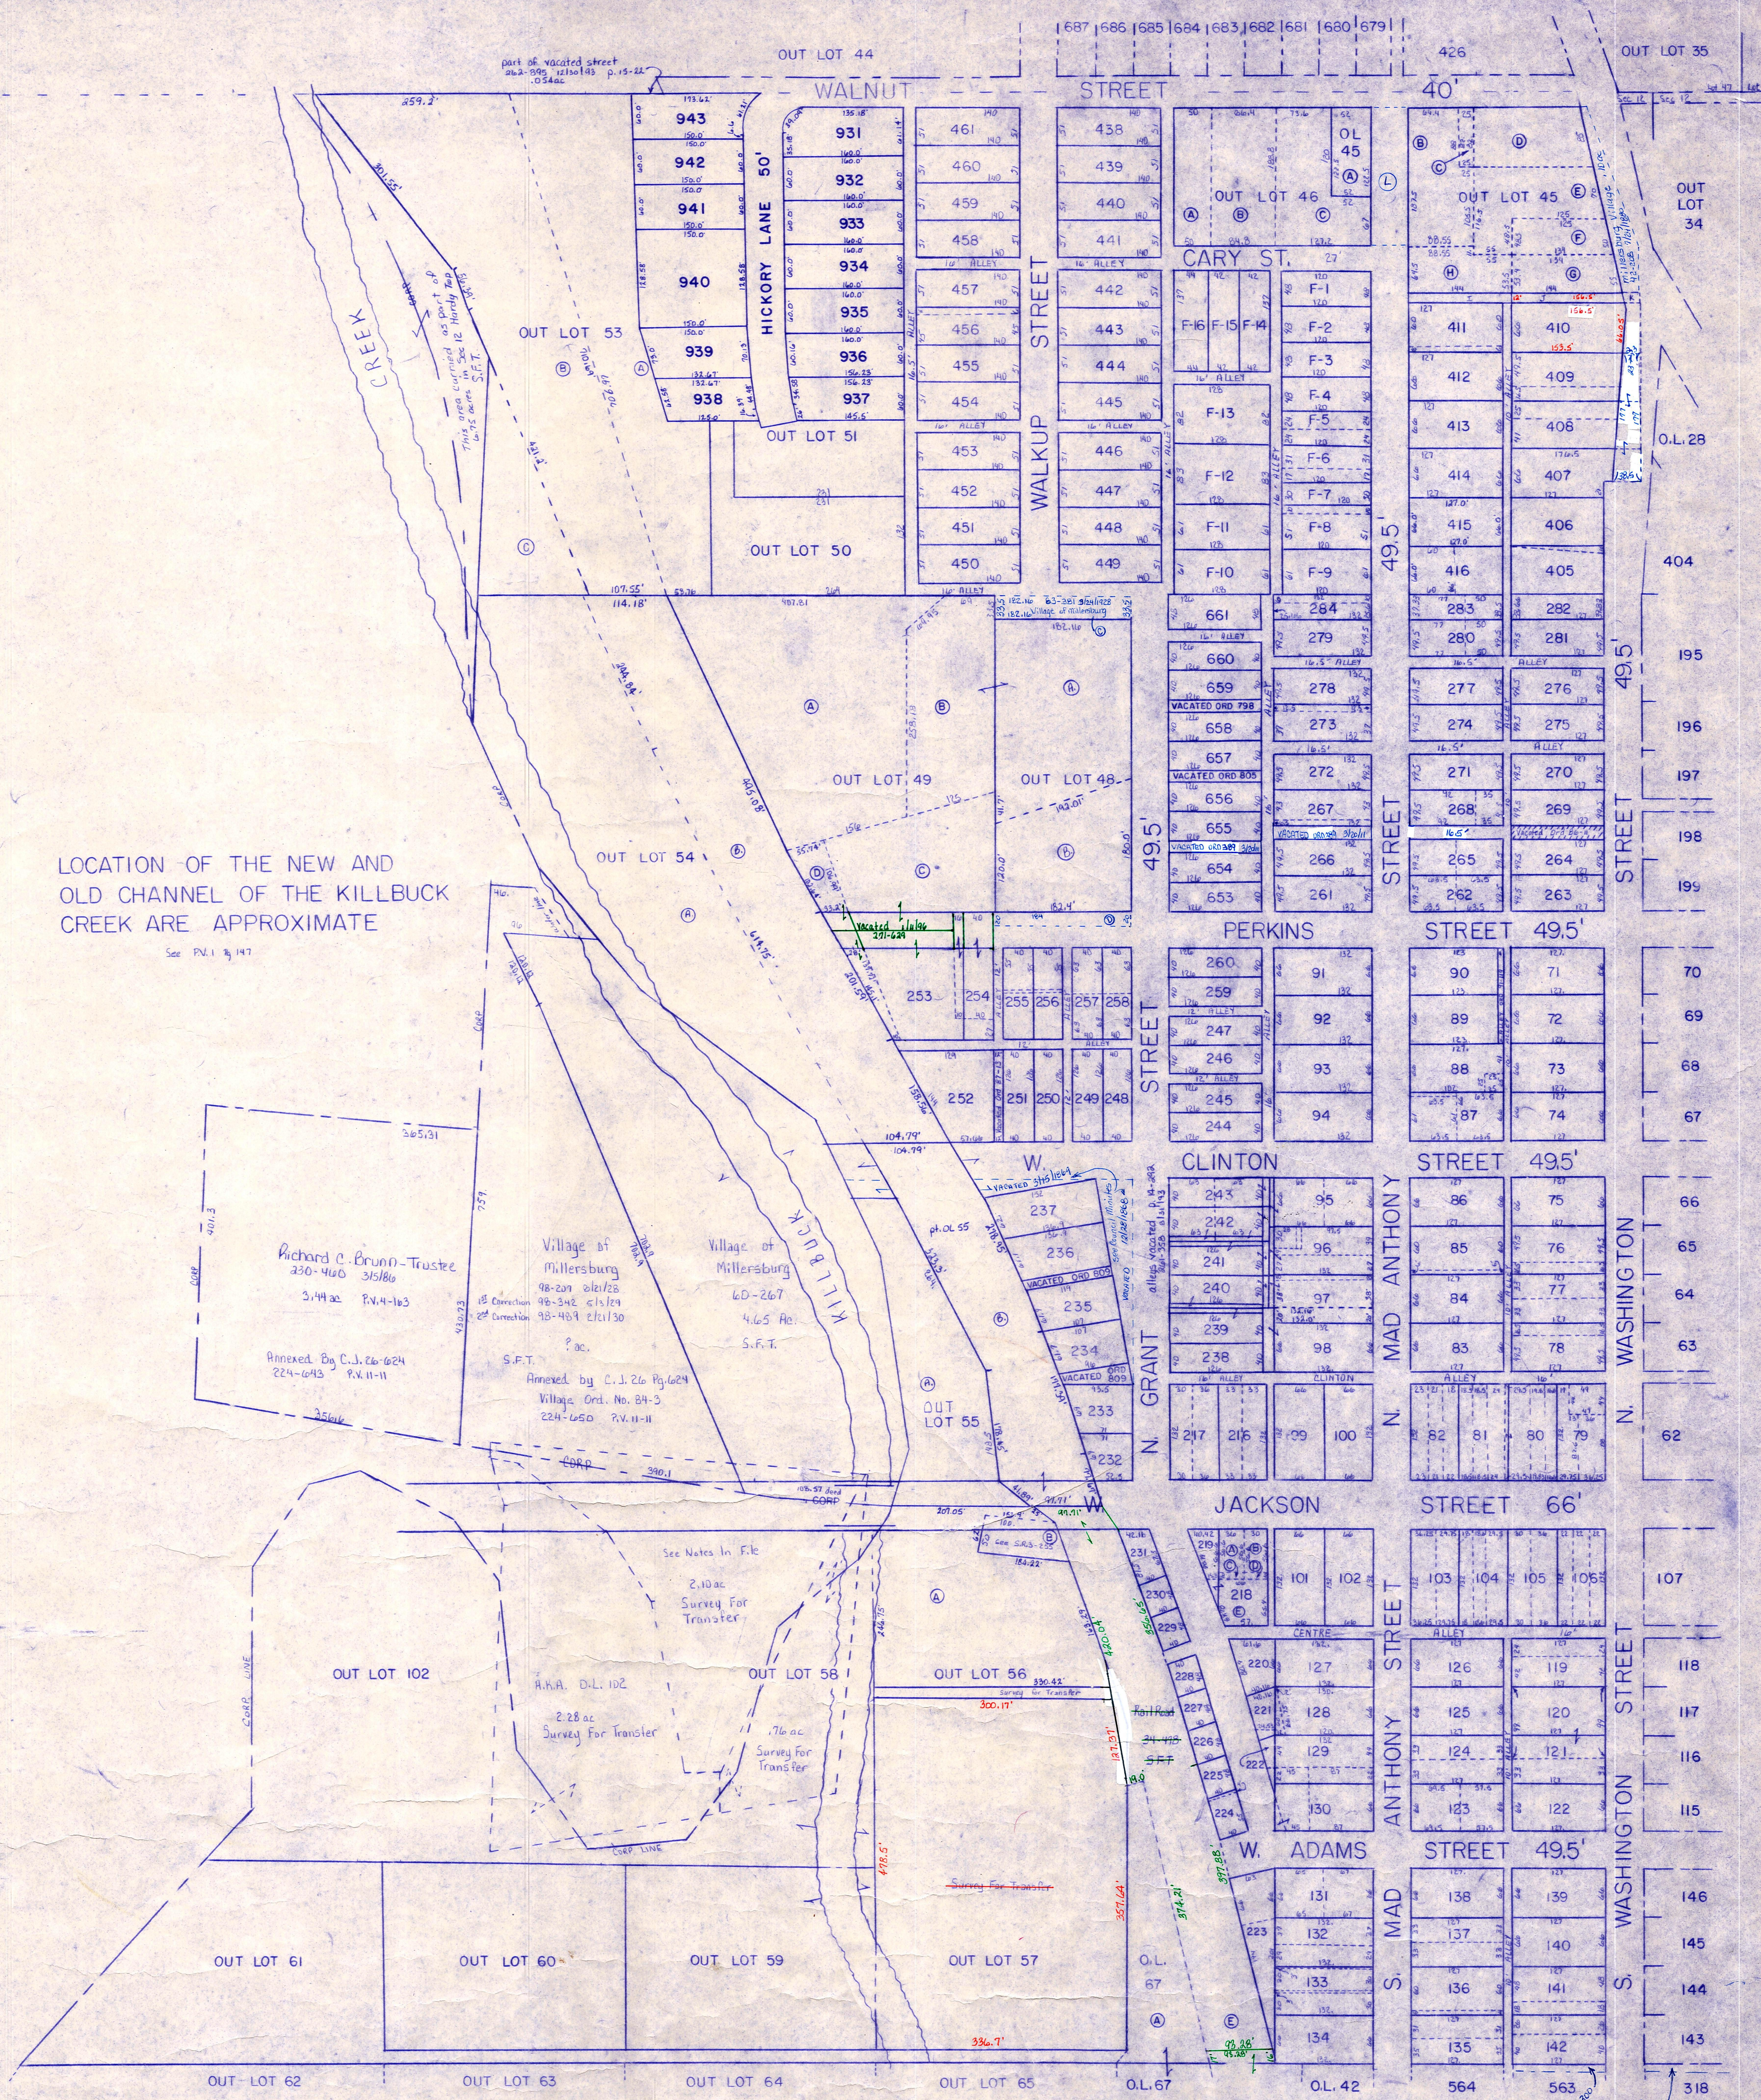

LOCATION OF THE NEW AND
 OLD CHANNEL OF THE KILLBUCK
 CREEK ARE APPROXIMATE
 See P.V. 1 p. 147

SEE M-4

SEE M-6

MILLERSBURG VILLAGE
 SCALE 1"=100'

LET IT BE KNOWN, THIS MAP HAS BEEN PREPARED AS A REFERENCE GUIDE TO PROPERTY OWNERSHIP. WE BELIEVE THIS INFORMATION TO BE CORRECT AND CURRENT, HOWEVER, IT IS NOT INTENDED FOR ANY LEGAL USE, WHETHER IT BE IN SALES, TRANSFERS, TRADES, LEASES OF ANY TYPE, ETC., AND DO NOT ACCEPT RESPONSIBILITY FOR ERRORS OF ANY NATURE OR OMISSIONS CONTAINED HEREIN.

MIV-3