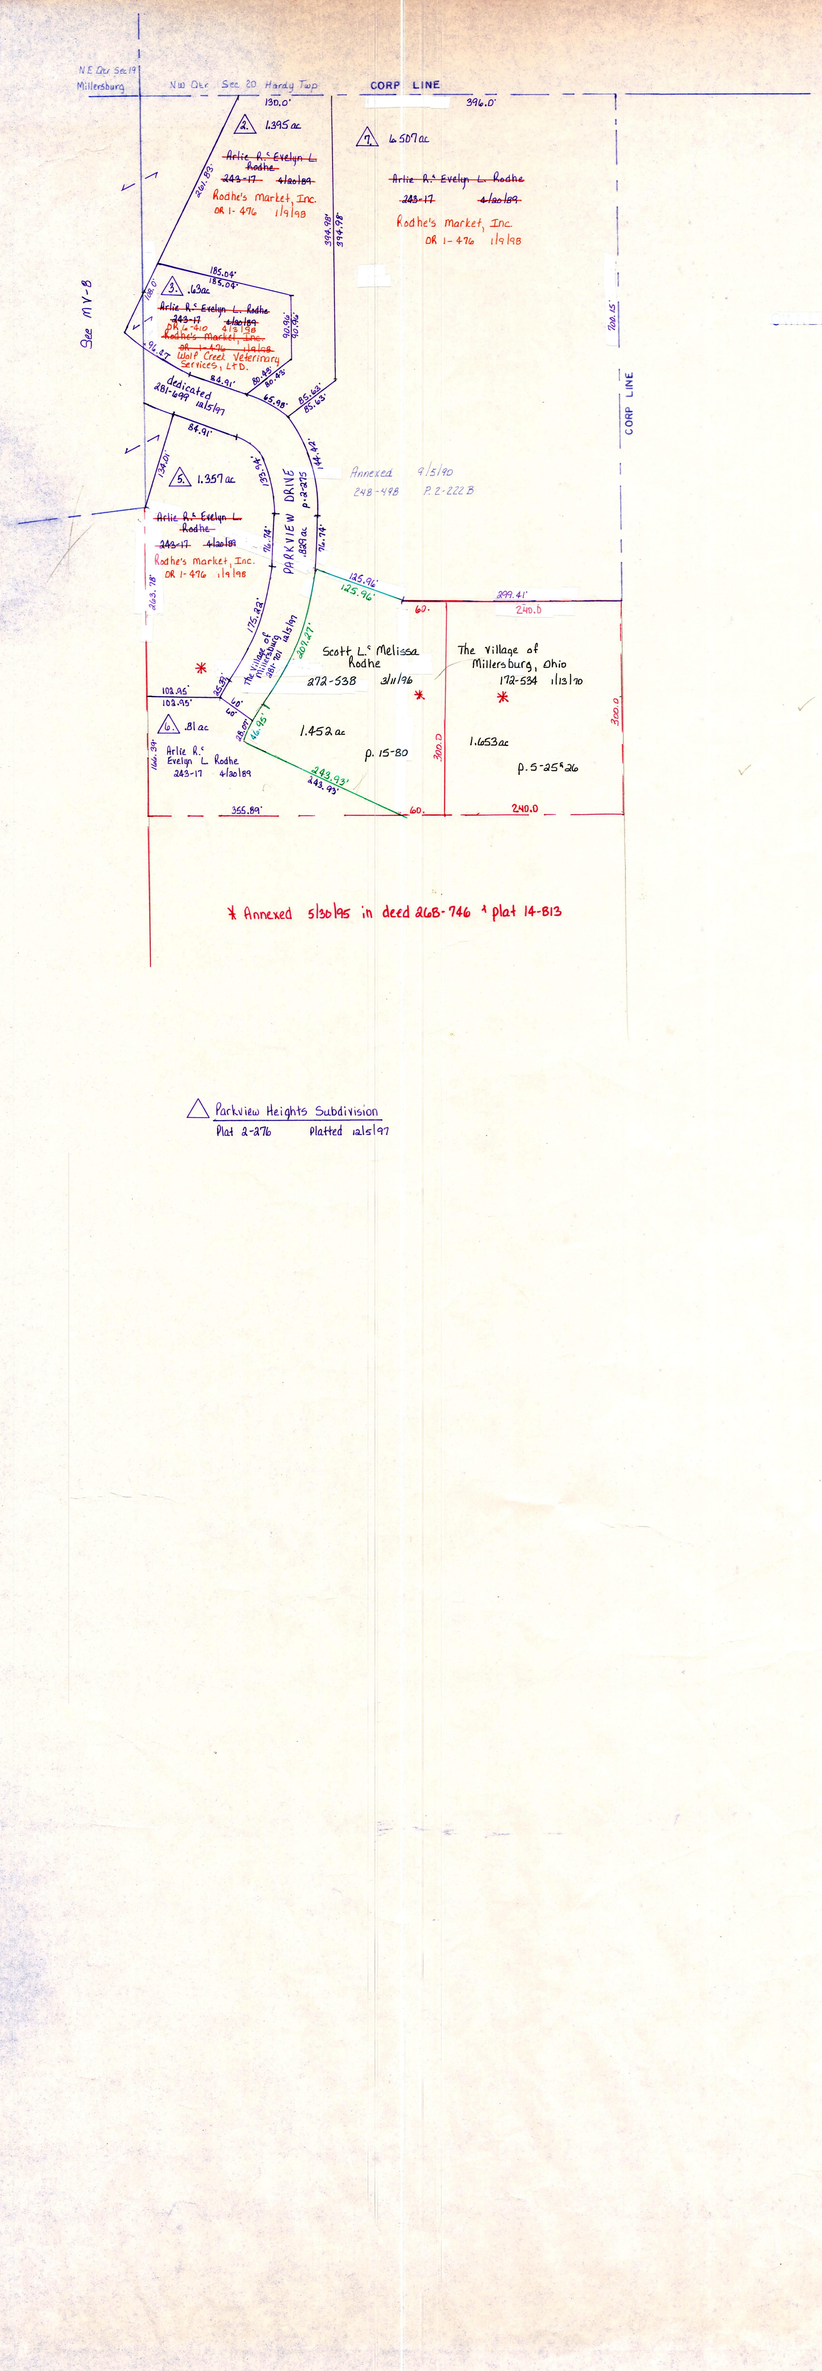

△ Parkview Heights Subdivision
Plat 2-376 Platted 12/5/97

* Annexed 5/30/95 in deed 268-746 & plat 14-813

MILLERSBURG VILLAGE
PART SW QTR. SEC 20, T-9, R-7
SCALE 1" = 100'

N

LET IT BE KNOWN, THIS MAP HAS BEEN PREPARED AS A REFERENCE GUIDE TO PROPERTY OWNERSHIP. WE BELIEVE THIS INFORMATION TO BE CORRECT AND CURRENT; HOWEVER, IT IS NOT INTENDED FOR ANY LEGAL USE, WHETHER IT BE IN SALES, TRANSFERS, TRADES, LEASES OF ANY TYPE, ETC., AND DO NOT ACCEPT RESPONSIBILITY FOR ERRORS OF ANY NATURE OR OMISSIONS CONTAINED HEREIN.

MV-11