



T.H. 258  
Old T.H. 309  
60' R/W

T.H. 260  
Old T.H. 441  
60' R/W

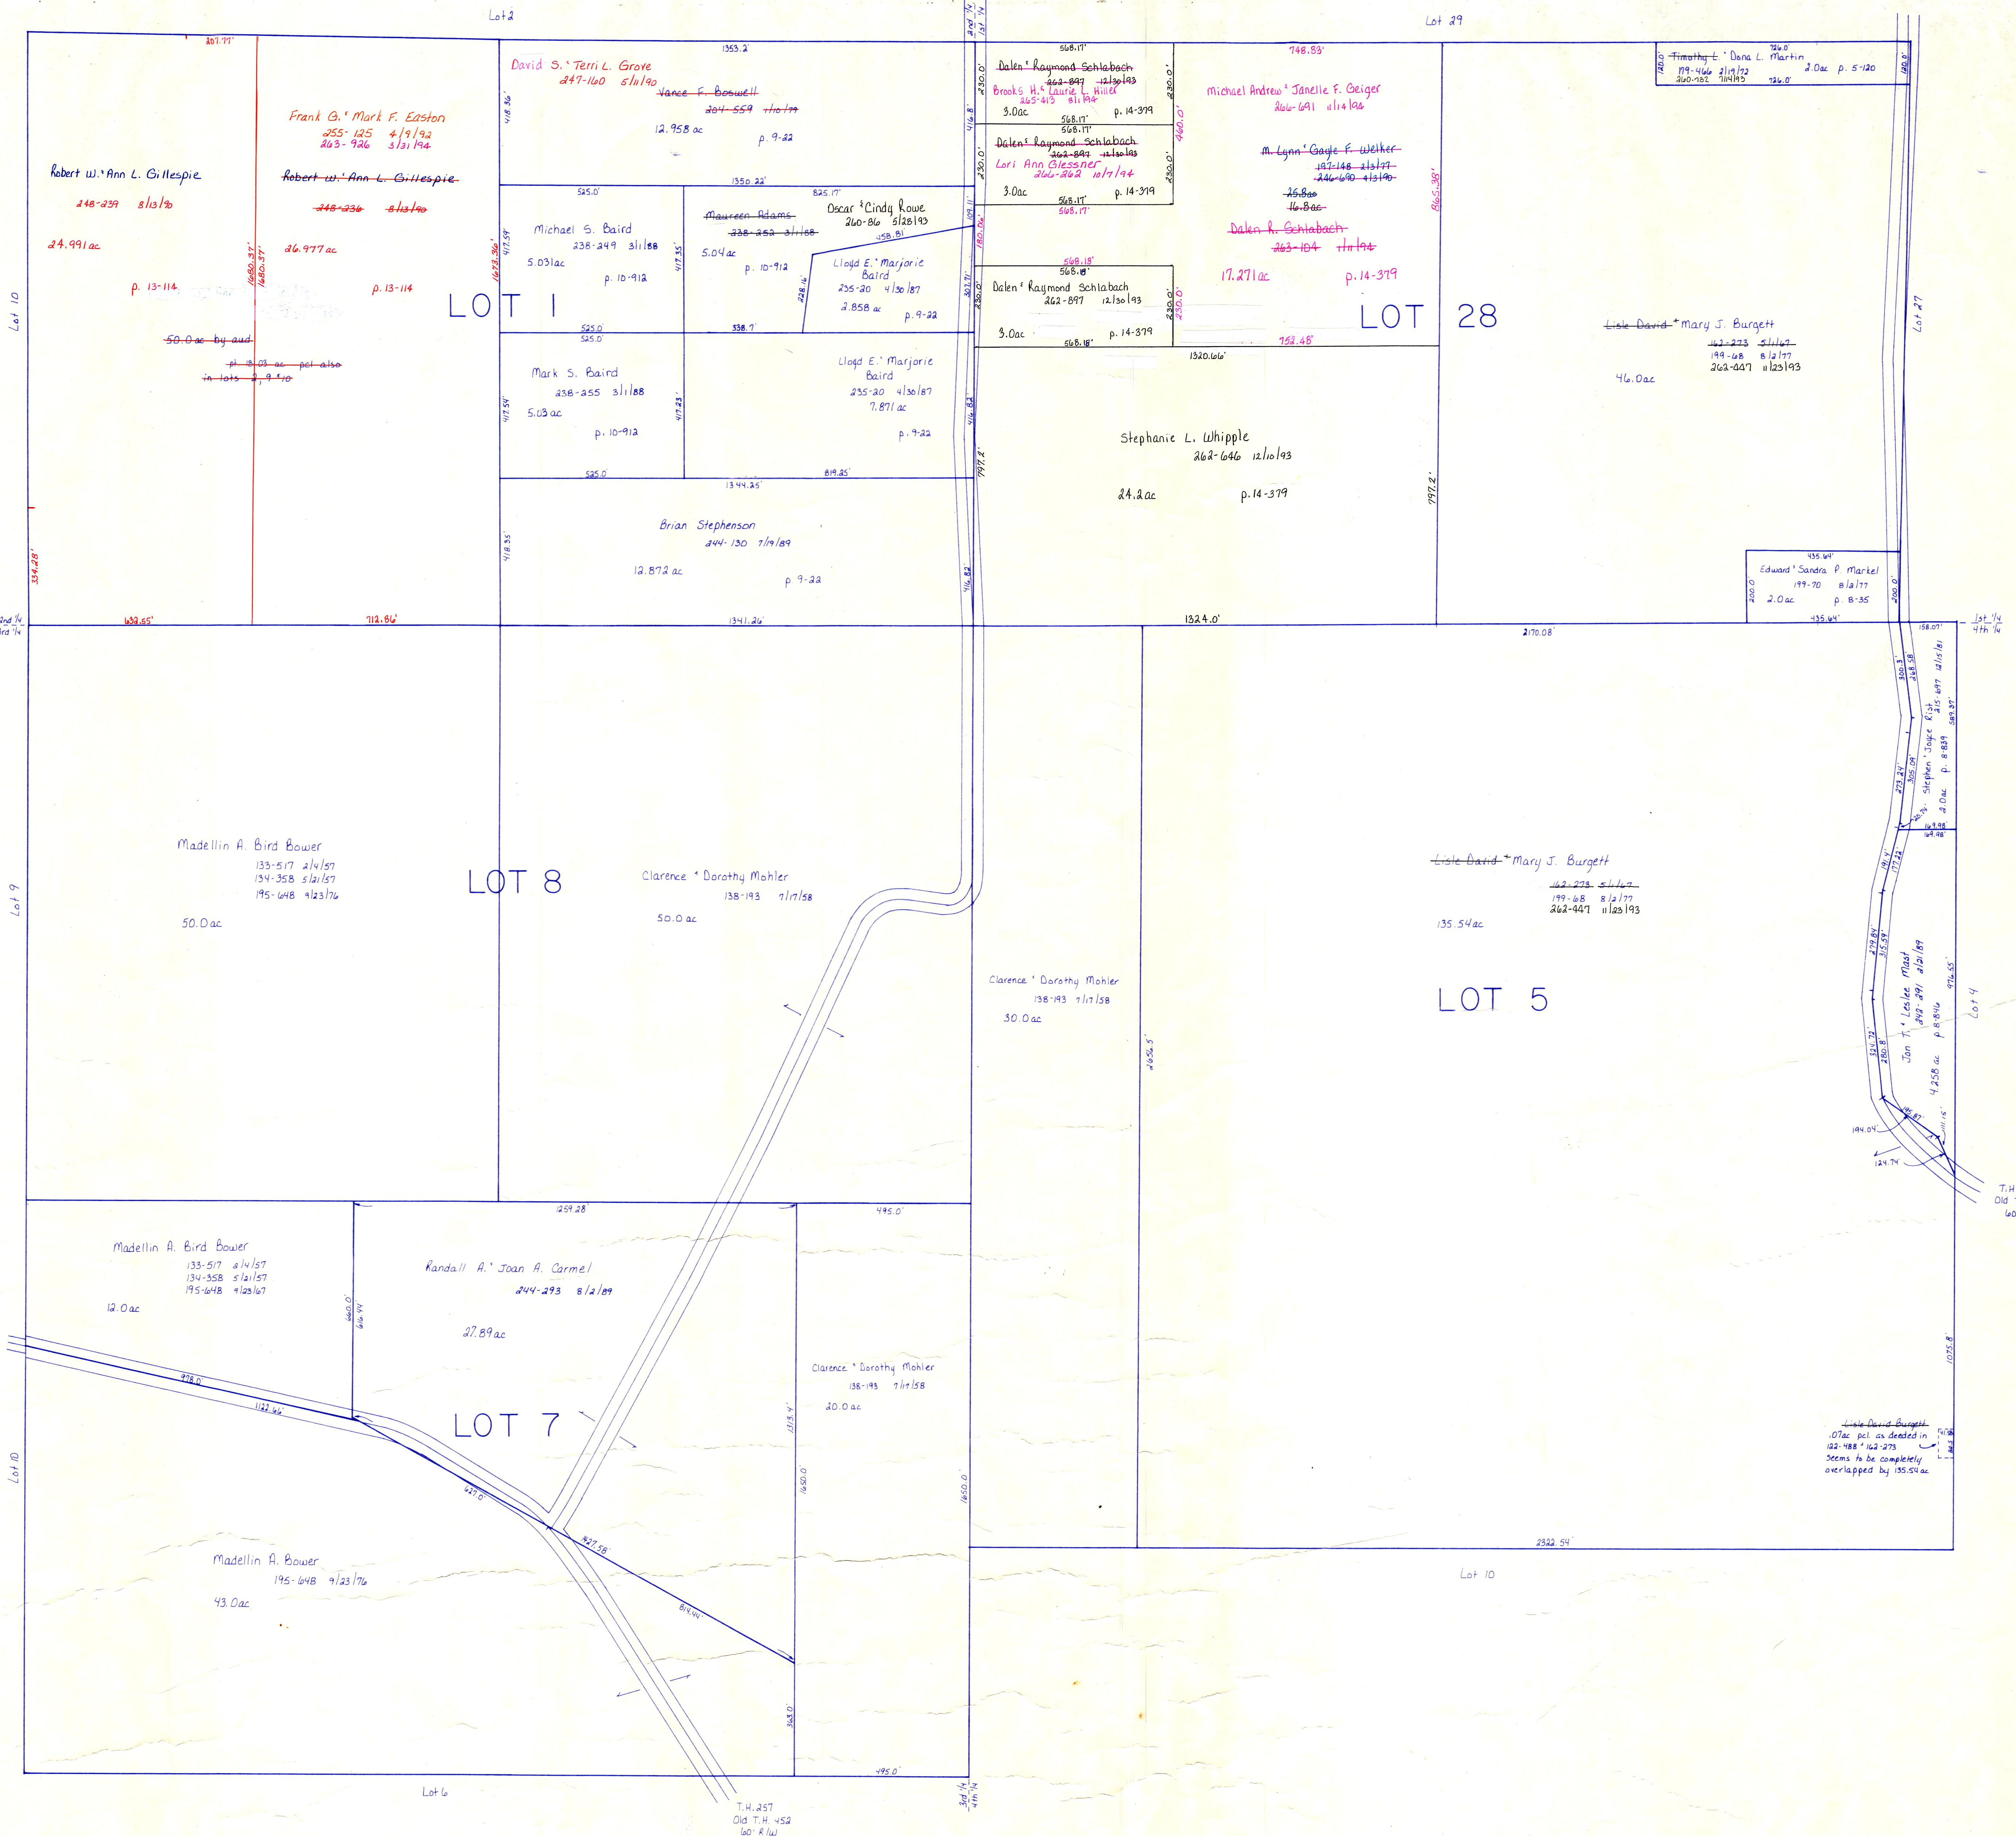

T.H. 257  
Old T.H. 452  
60' R/W

T.H. 260  
Old T.H. 441  
60' R/W

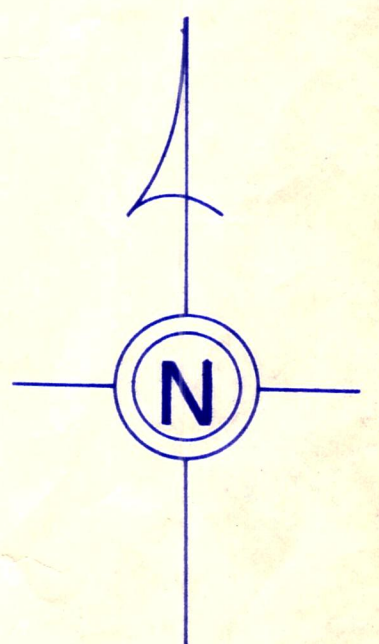

T-9, R-8  
 1st. Qtr. lot 28  
 2nd. Qtr. lot 1  
 3rd. Qtr. lots 7, 8  
 4th. Qtr. lot 5  
 MONROE TWP.  
 SCALE: 1" = 200'

LET IT BE KNOWN, THIS MAP HAS BEEN PREPARED AS A REFERENCE GUIDE TO PROPERTY OWNERSHIP. WE BELIEVE THIS INFORMATION TO BE CORRECT AND CURRENT. HOWEVER, IT IS NOT INTENDED FOR ANY LEGAL USE, WHETHER IT BE IN SALES, TRANSFERS, TRADES, LEASES OF ANY TYPE, ETC. AND DO NOT ACCEPT RESPONSIBILITY FOR ERRORS OF ANY NATURE OR OMISSIONS CONTAINED HEREIN.

M-11