


T.H. 652  
Old T.H. 210  
33° 50' E/W

Sec. 31

T.H. 656  
Old T.H. 216  
30° E/W

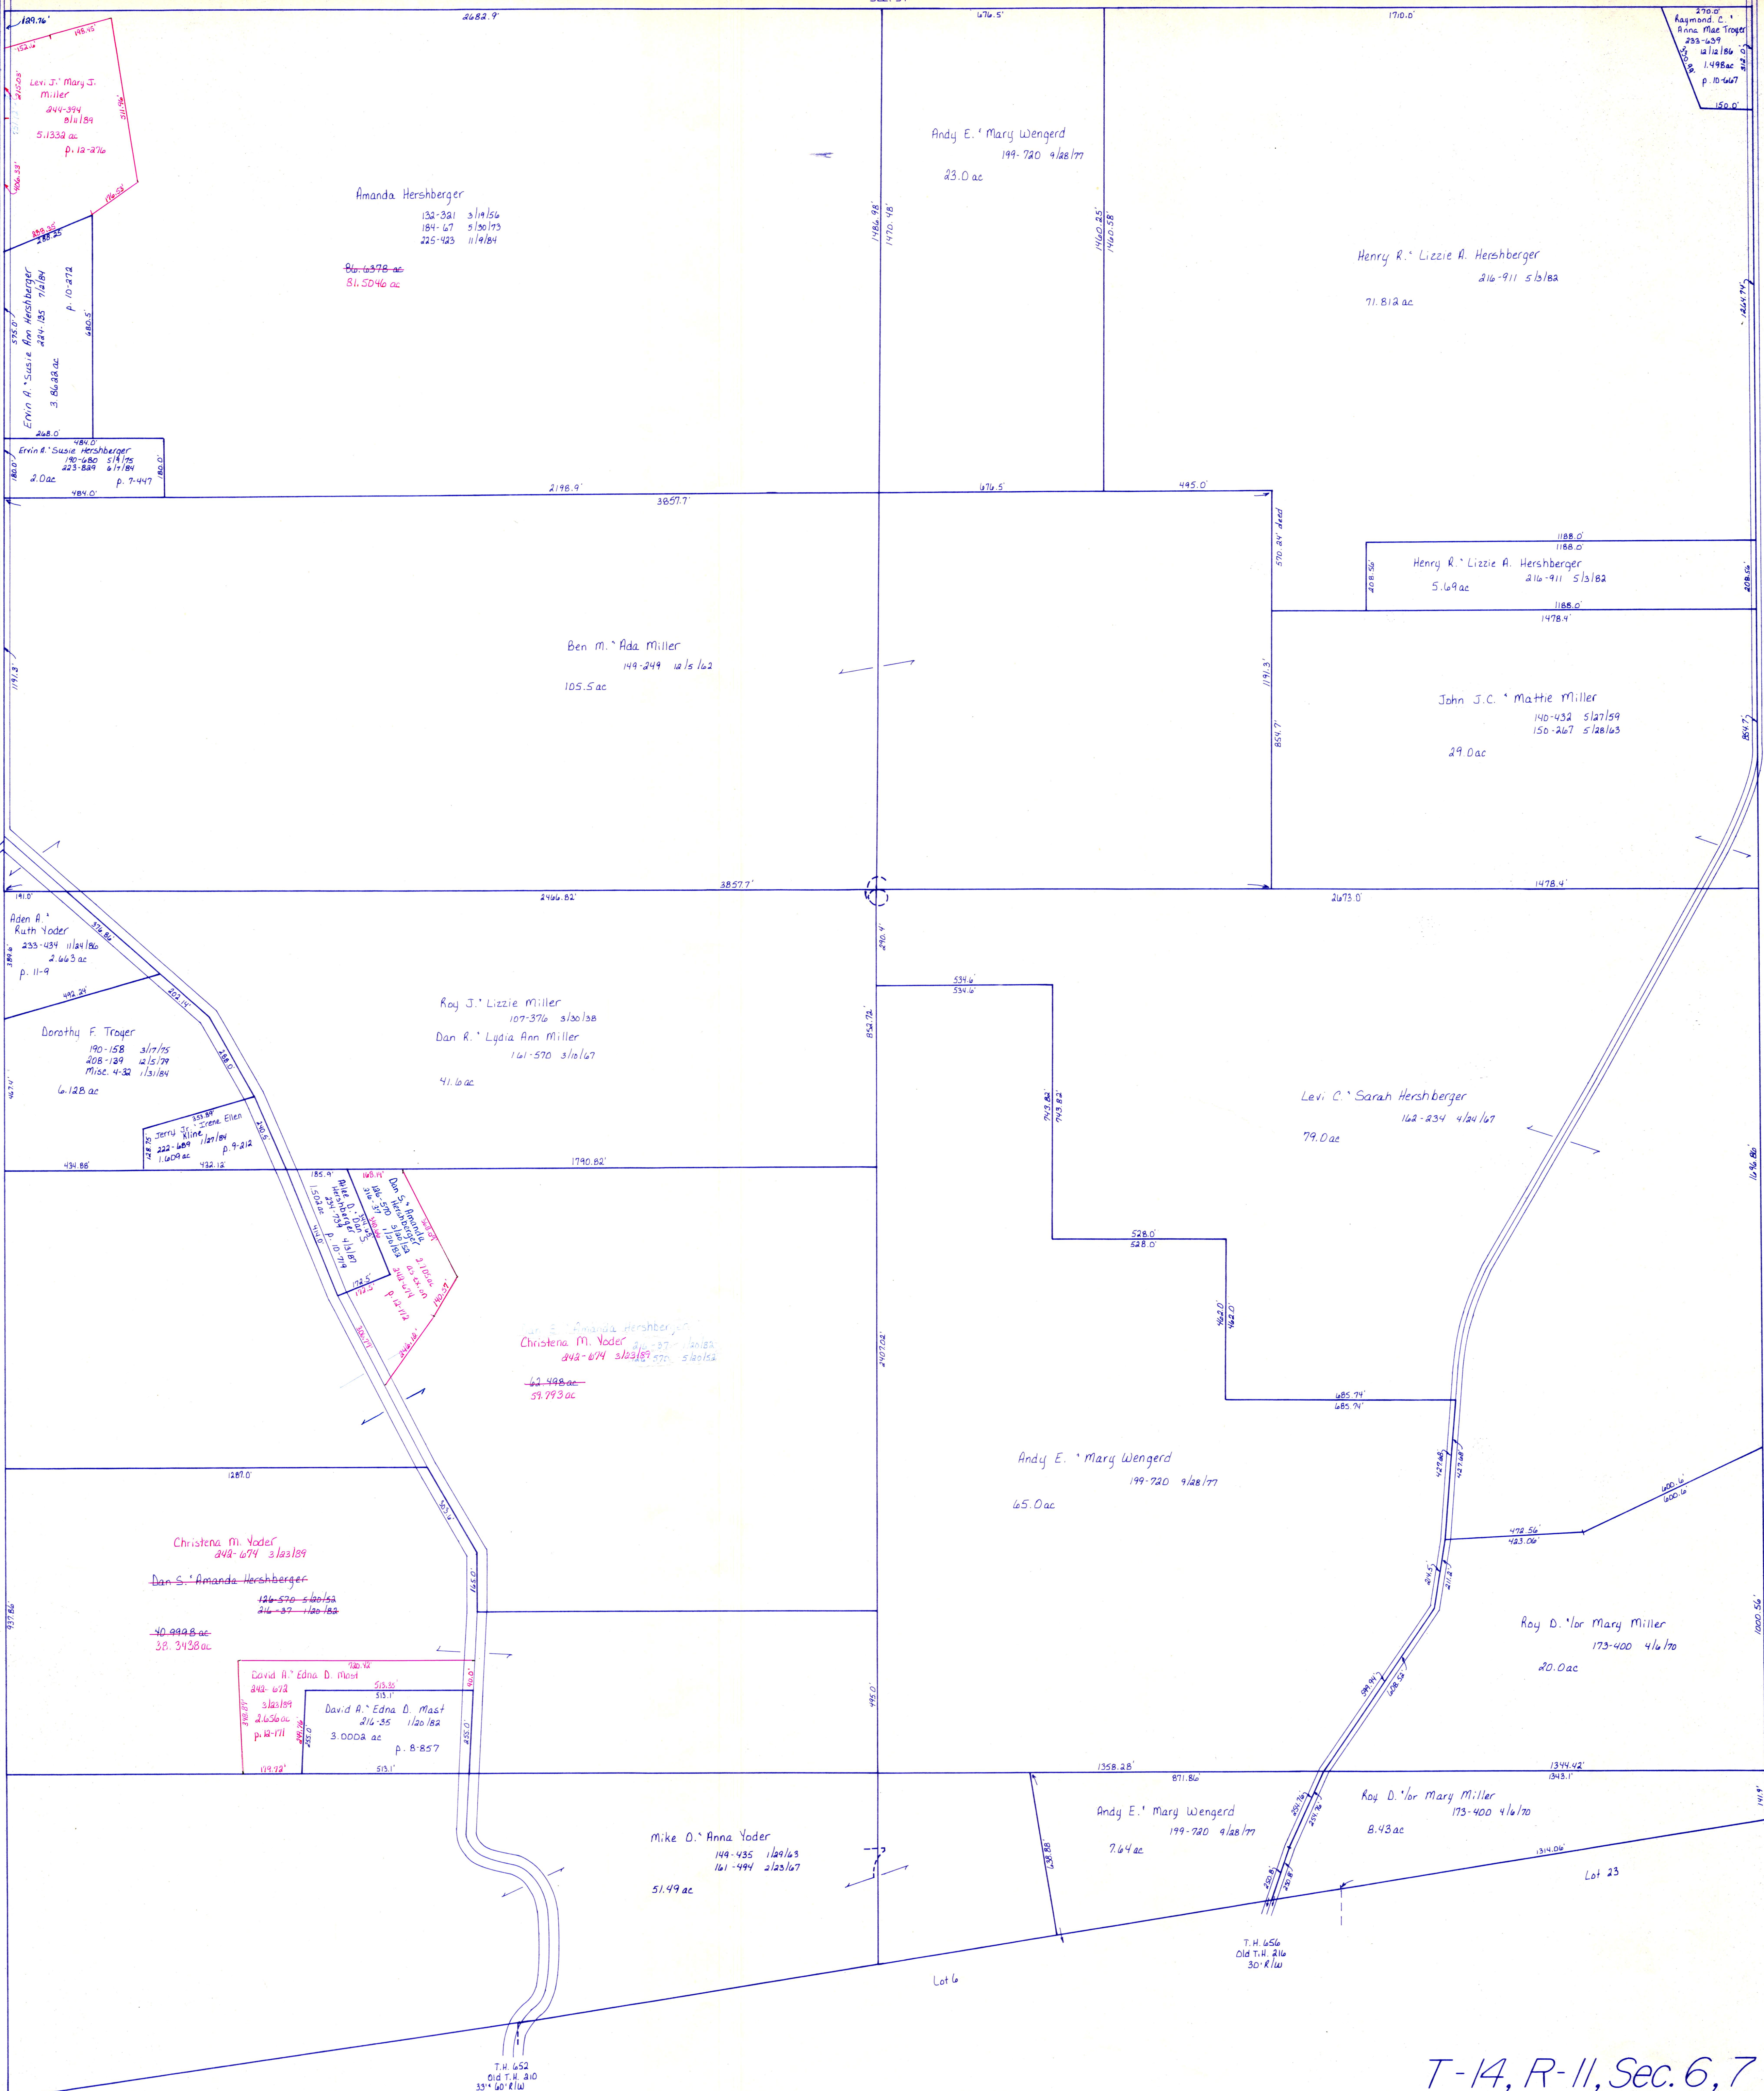

T.H. 617  
Old T.H. 310  
No E/W

South Creek Twp.

Sec. 5

Greenville Treaty Line -  
Old Indian Boundary Line

Greenville Treaty Line -  
Old Indian Boundary Line

T-14, R-11, Sec. 6, 7  
PAINT TWP.  
SCALE: 1" = 200'

LET IT BE KNOWN, THIS MAP HAS BEEN PREPARED AS A REFERENCE GUIDE TO PROPERTY OWNERSHIP. WE BELIEVE THIS INFORMATION TO BE CORRECT AND CURRENT, HOWEVER, IT IS NOT INTENDED FOR ANY LEGAL USE, WHETHER IT BE IN SALES, TRANSFERS, TRADES, LEASES OF ANY TYPE, ETC. AND DO NOT ACCEPT RESPONSIBILITY FOR ERRORS OF ANY NATURE OR OMISSIONS CONTAINED HEREIN.

P-16