



Sec 3

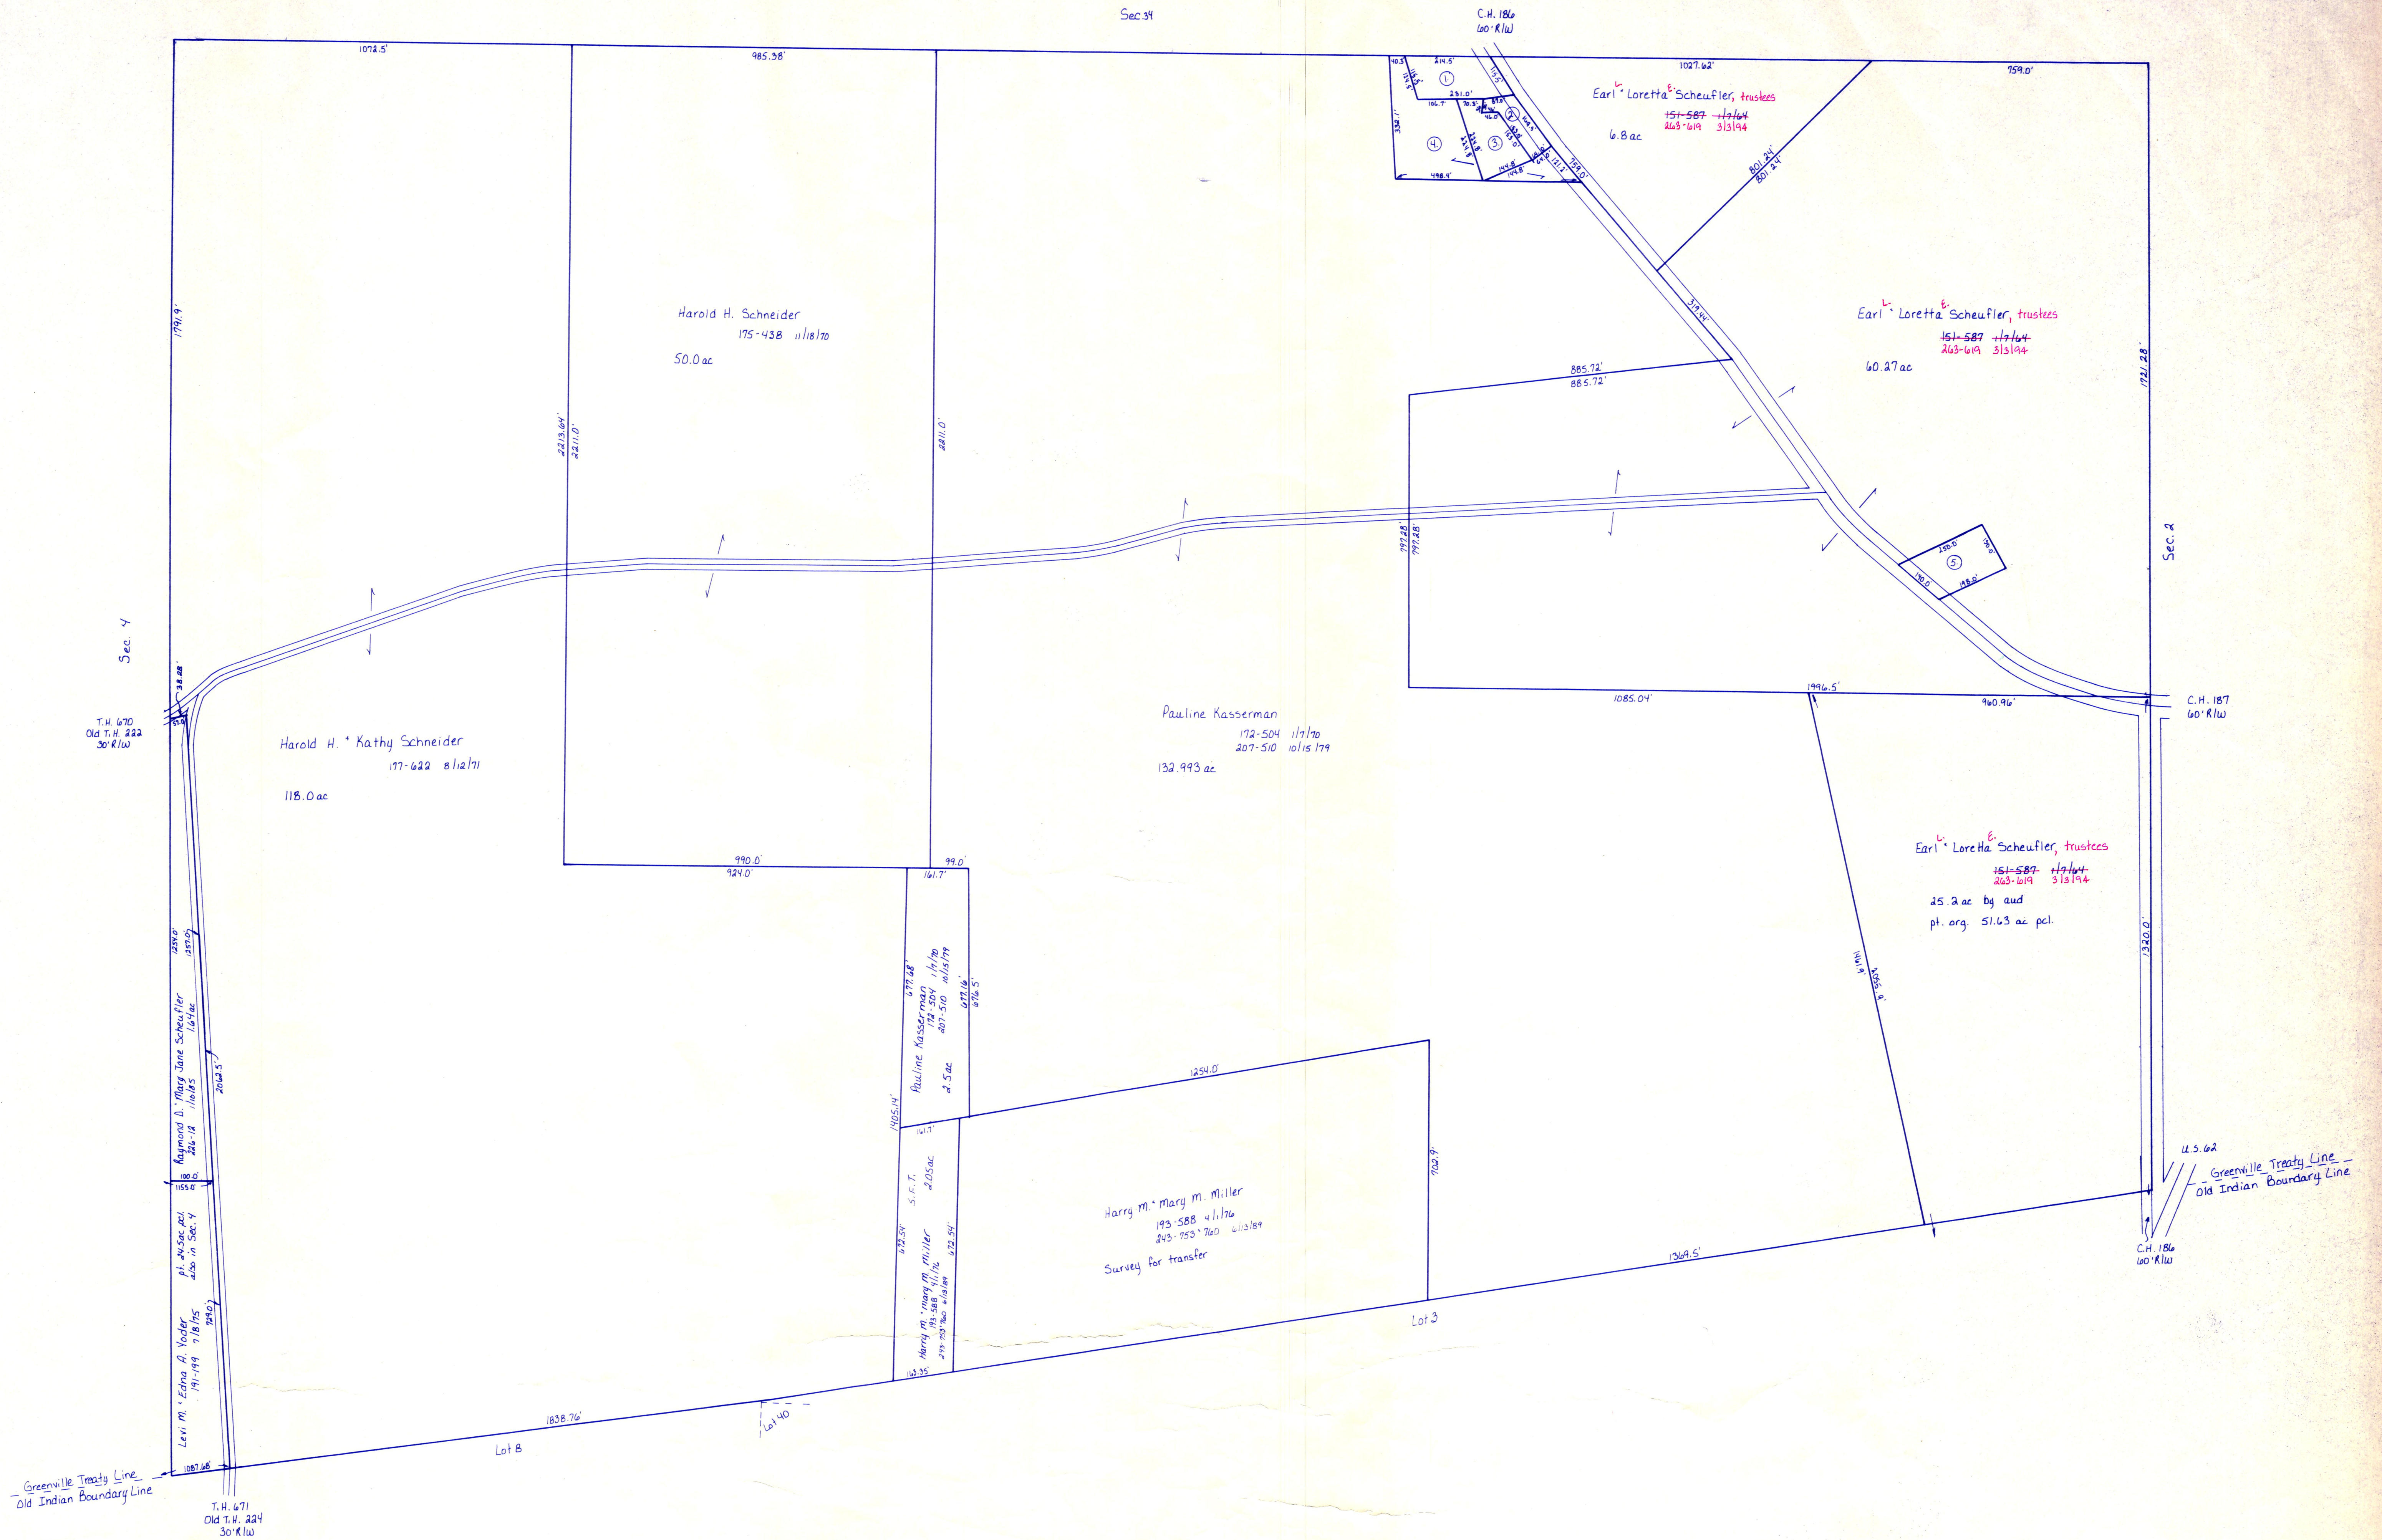

- ① parcel used as burying ground 5.471 317/1037 .68 ac
- ② Trustees of the Mennonite Church 52.98 1/10/1890 .61 ac
- ③ Trustees of the Longenecker Mennonite Church 132.500 1/10/1890 .50 ac p. 3
- ④ Trustees of the Longenecker Mennonite Church 141.319 1/10/1890 p. 4/100
- ⑤ Earl Loretta Scheufler 131.01 1/1/1895 .73 ac

for numbered parcels, see folder

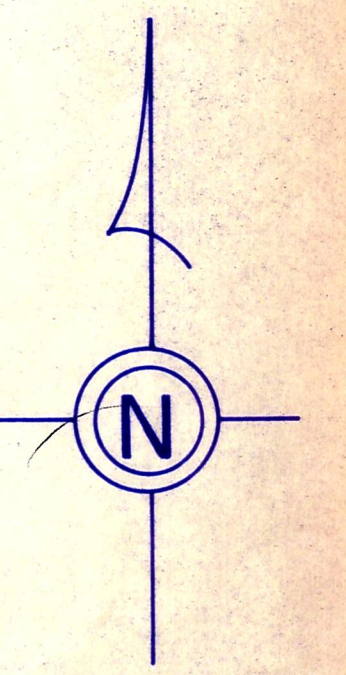

T-14, R-11, Sec. 3
 PAINT TWP.
 SCALE: 1" = 200'

LET IT BE KNOWN, THIS MAP HAS BEEN PREPARED AS A REFERENCE GUIDE TO PROPERTY OWNERSHIP. WE BELIEVE THIS INFORMATION TO BE CORRECT AND CURRENT, HOWEVER, IT IS NOT INTENDED FOR ANY LEGAL USE, WHETHER IT BE IN SALES, TRANSFERS, TRADES, LEASES OF ANY TYPE, ETC., AND DO NOT ACCEPT RESPONSIBILITY FOR ERRORS OF ANY NATURE OR OMISSIONS CONTAINED HEREIN.