


T.H. 525
T.H. 534 (Old)
60' R/W

Sec. 7

T.H. 551
T.H. 551 (Old)
60' R/W

T.H. 555
T.H. 433 (Old)
60' R/W

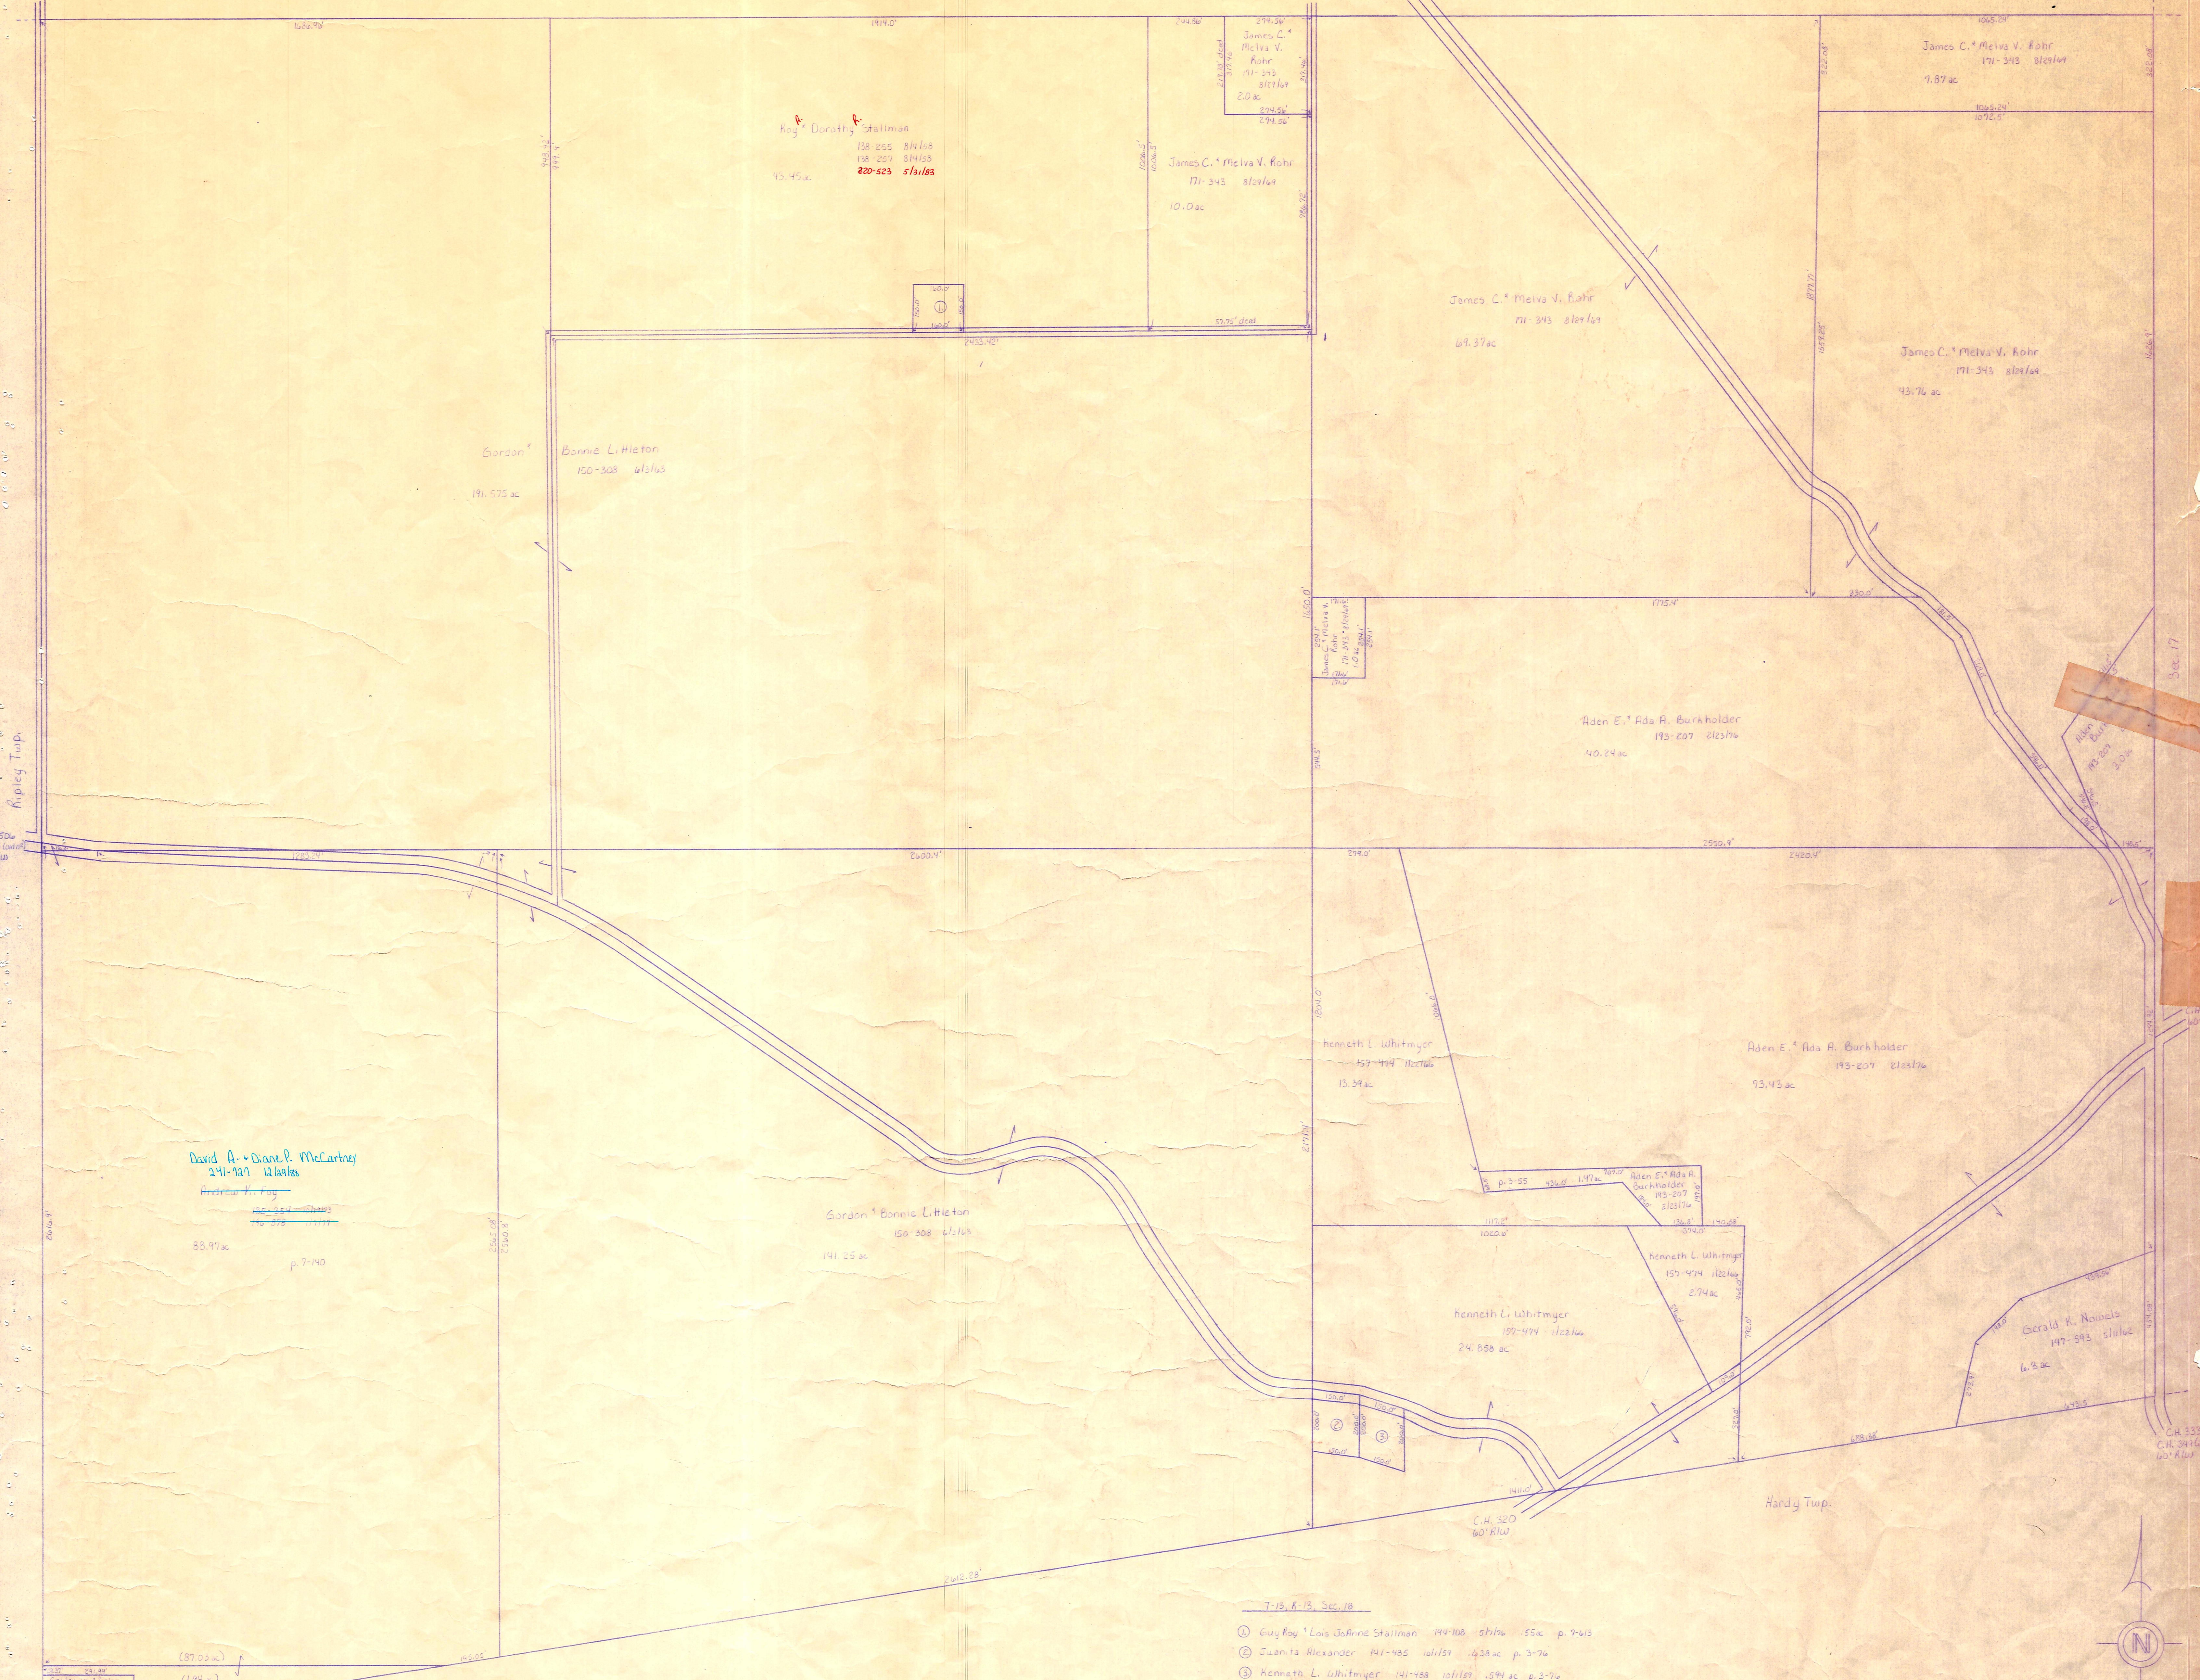

David A. & Diane P. McCartney


85.97 ac
p. 7-140

Gordon & Bonnie Littleton
141.25 ac

James C. & Melva V. Rohr
10.0 ac

Aden E. & Ada A. Burkholder
193-207 2/23/76
40.24 ac

James C. & Melva V. Rohr
43.76 ac

Kenneth L. Whitmyer
15.34 ac

Aden E. & Ada A. Burkholder
193-207 2/23/76

Kenneth L. Whitmyer
24.88 ac

6.3 ac


T-13, R-13, Sec. 18


Sec. 19

Monroe Twp.

T-13, R-13, Sec. 18+19
PRAIRIE TWP.
SCALE: 1" = 200'

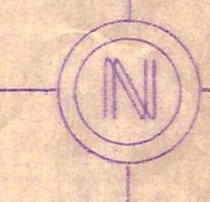

DR-1