


T.H. 325  
Old name  
60' x 100'

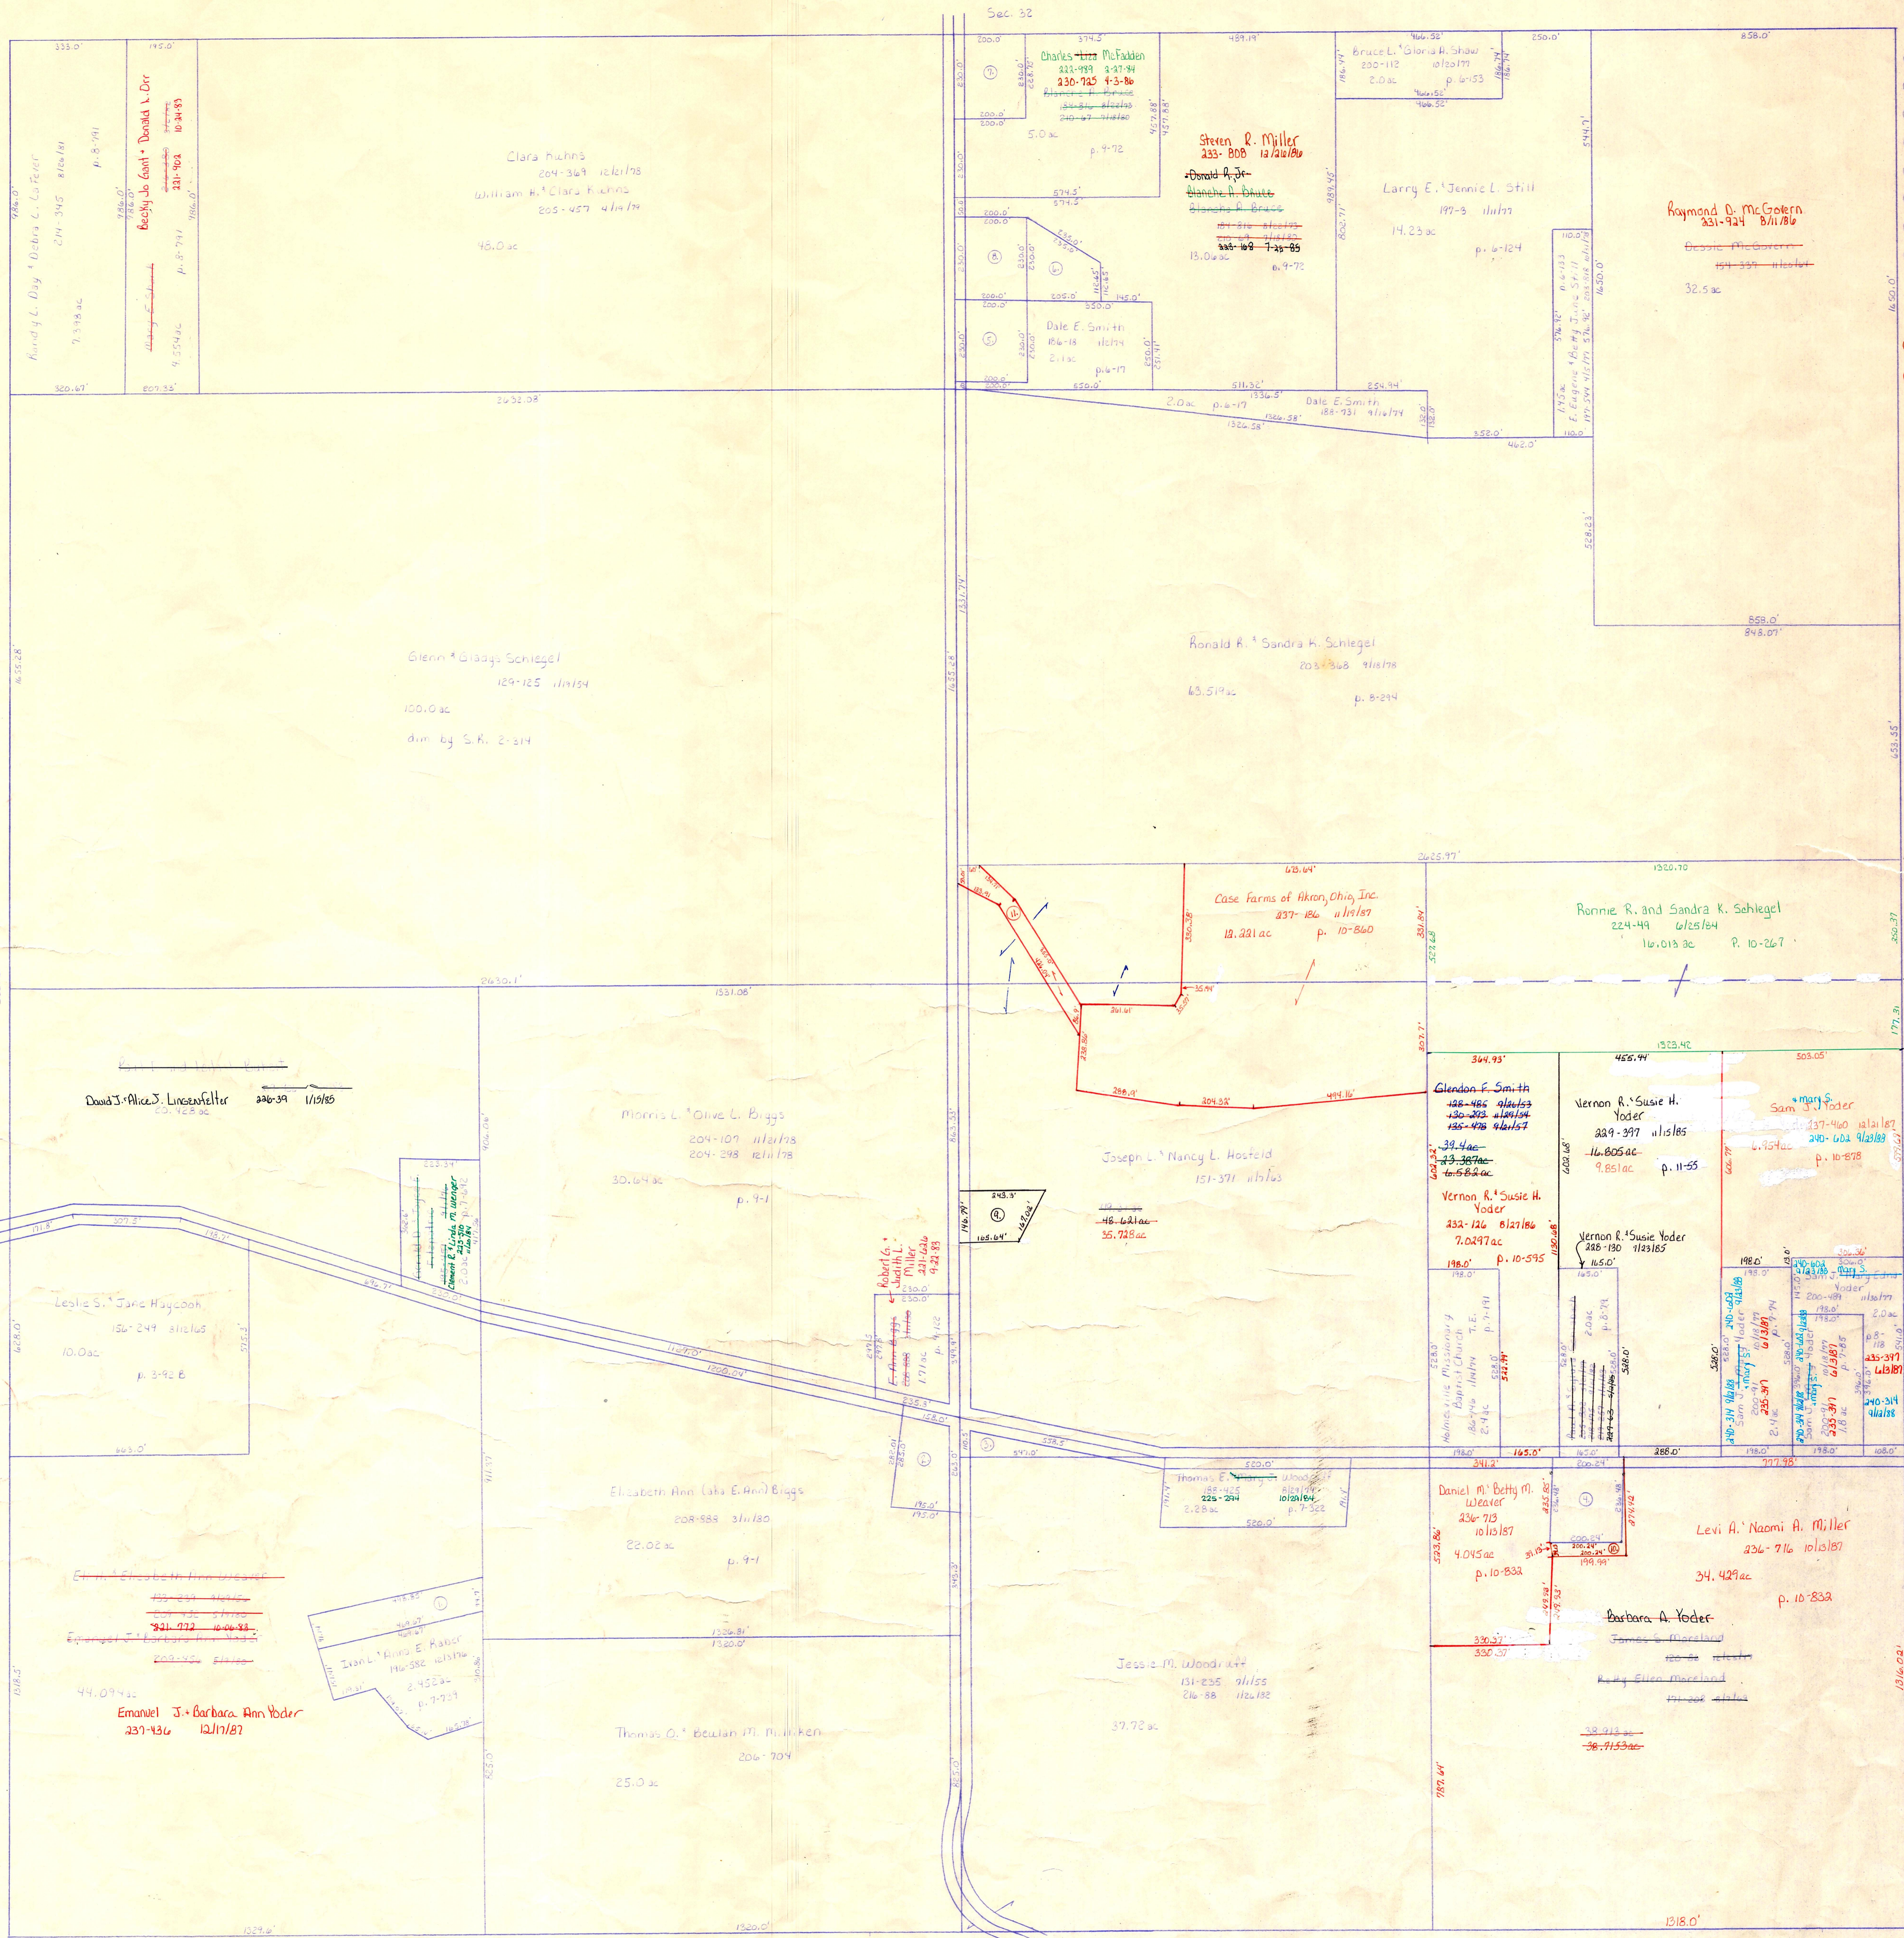


T-13, R-13, Sec. 5  
PRAIRIE TWP.  
SCALE: 1" = 200'

PR-8