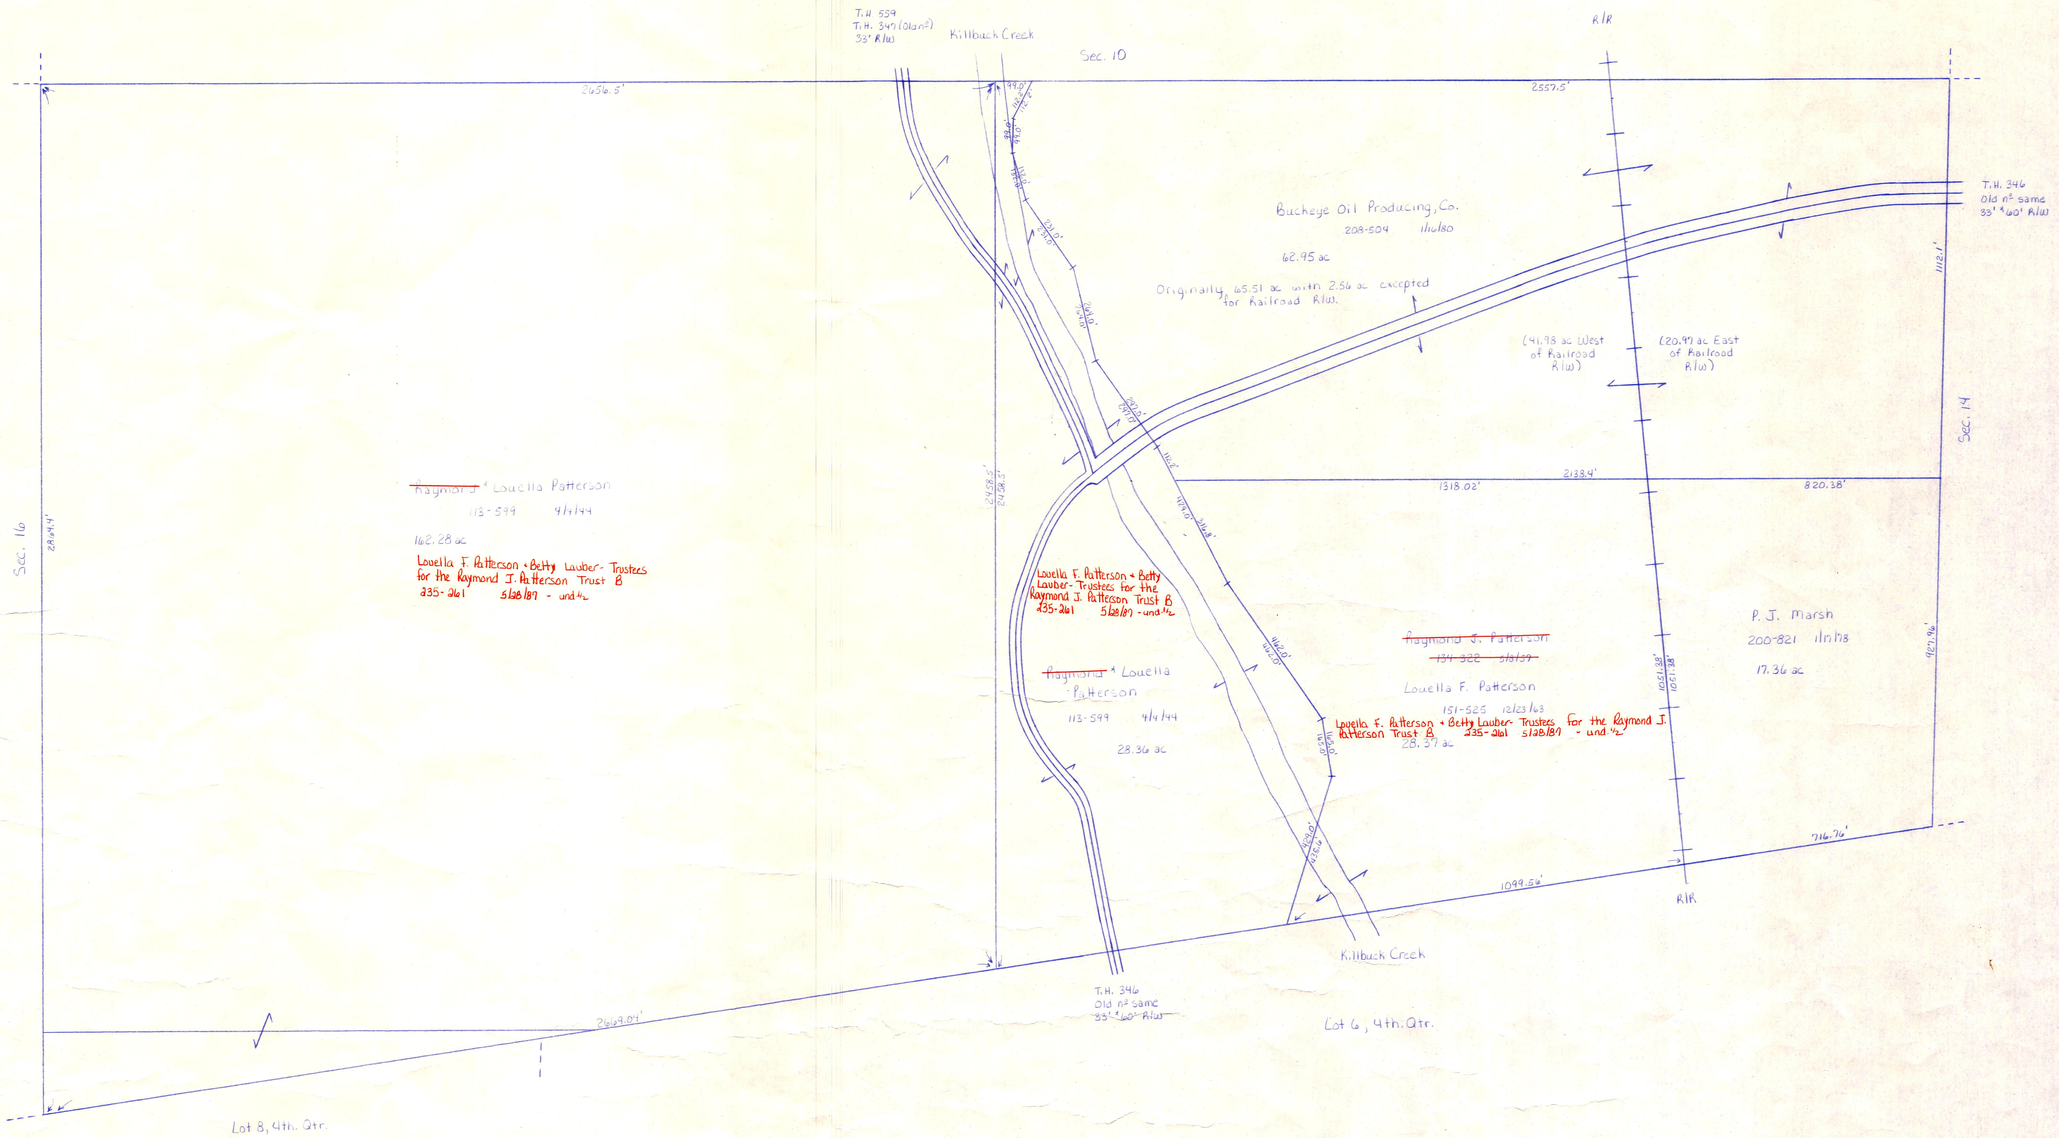

T-13, R-13, Sec. 15
PRAIRIE TWP.
SCALE: 1" = 200'

PR-18