


Noting: Albert Painter, Plack 110-131

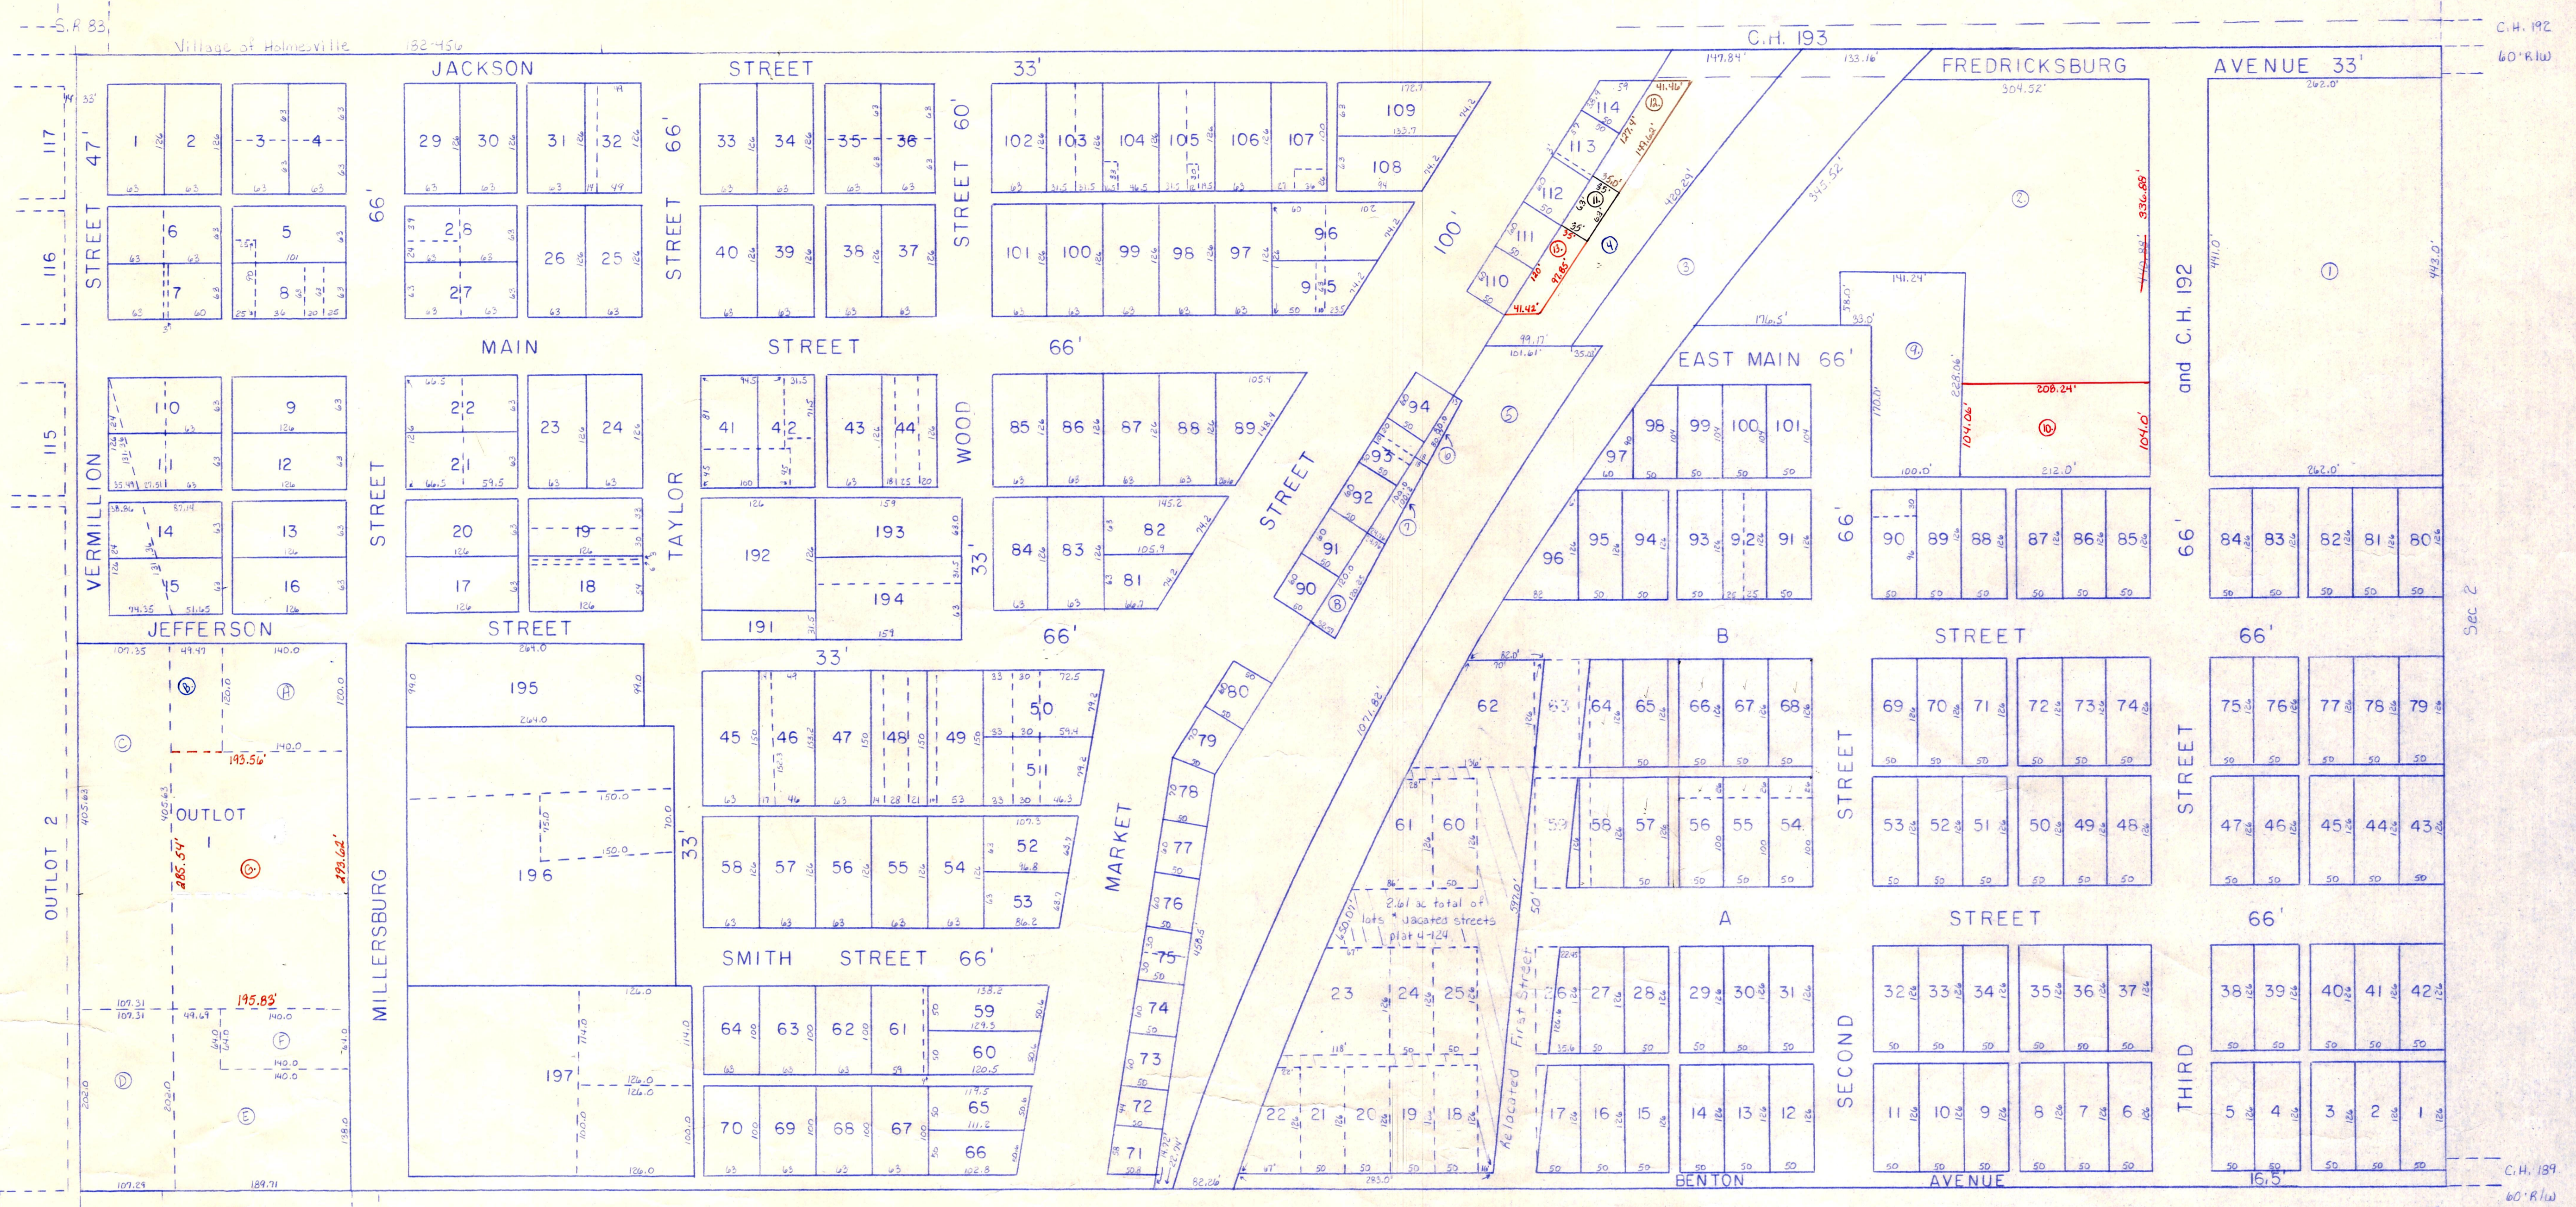

S. A. 83

C.H. 192

Noting: Albert Painter, Plack 110-131


HOMESTEAD ADDITION

Farrington Business Systems, Inc.
215-537

UNLESS OTHERWISE INDICATED,
ALL HOLMESVILLE ALLEYS ARE
12 FEET WIDE.

incorporated
HOLMESVILLE VILLAGE

T-13, R-13, Sec. 3
PRAIRIE TWP.
scale: 1" = 100'

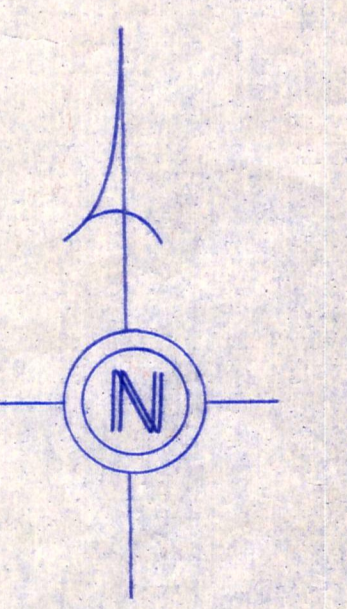

PR-2013