
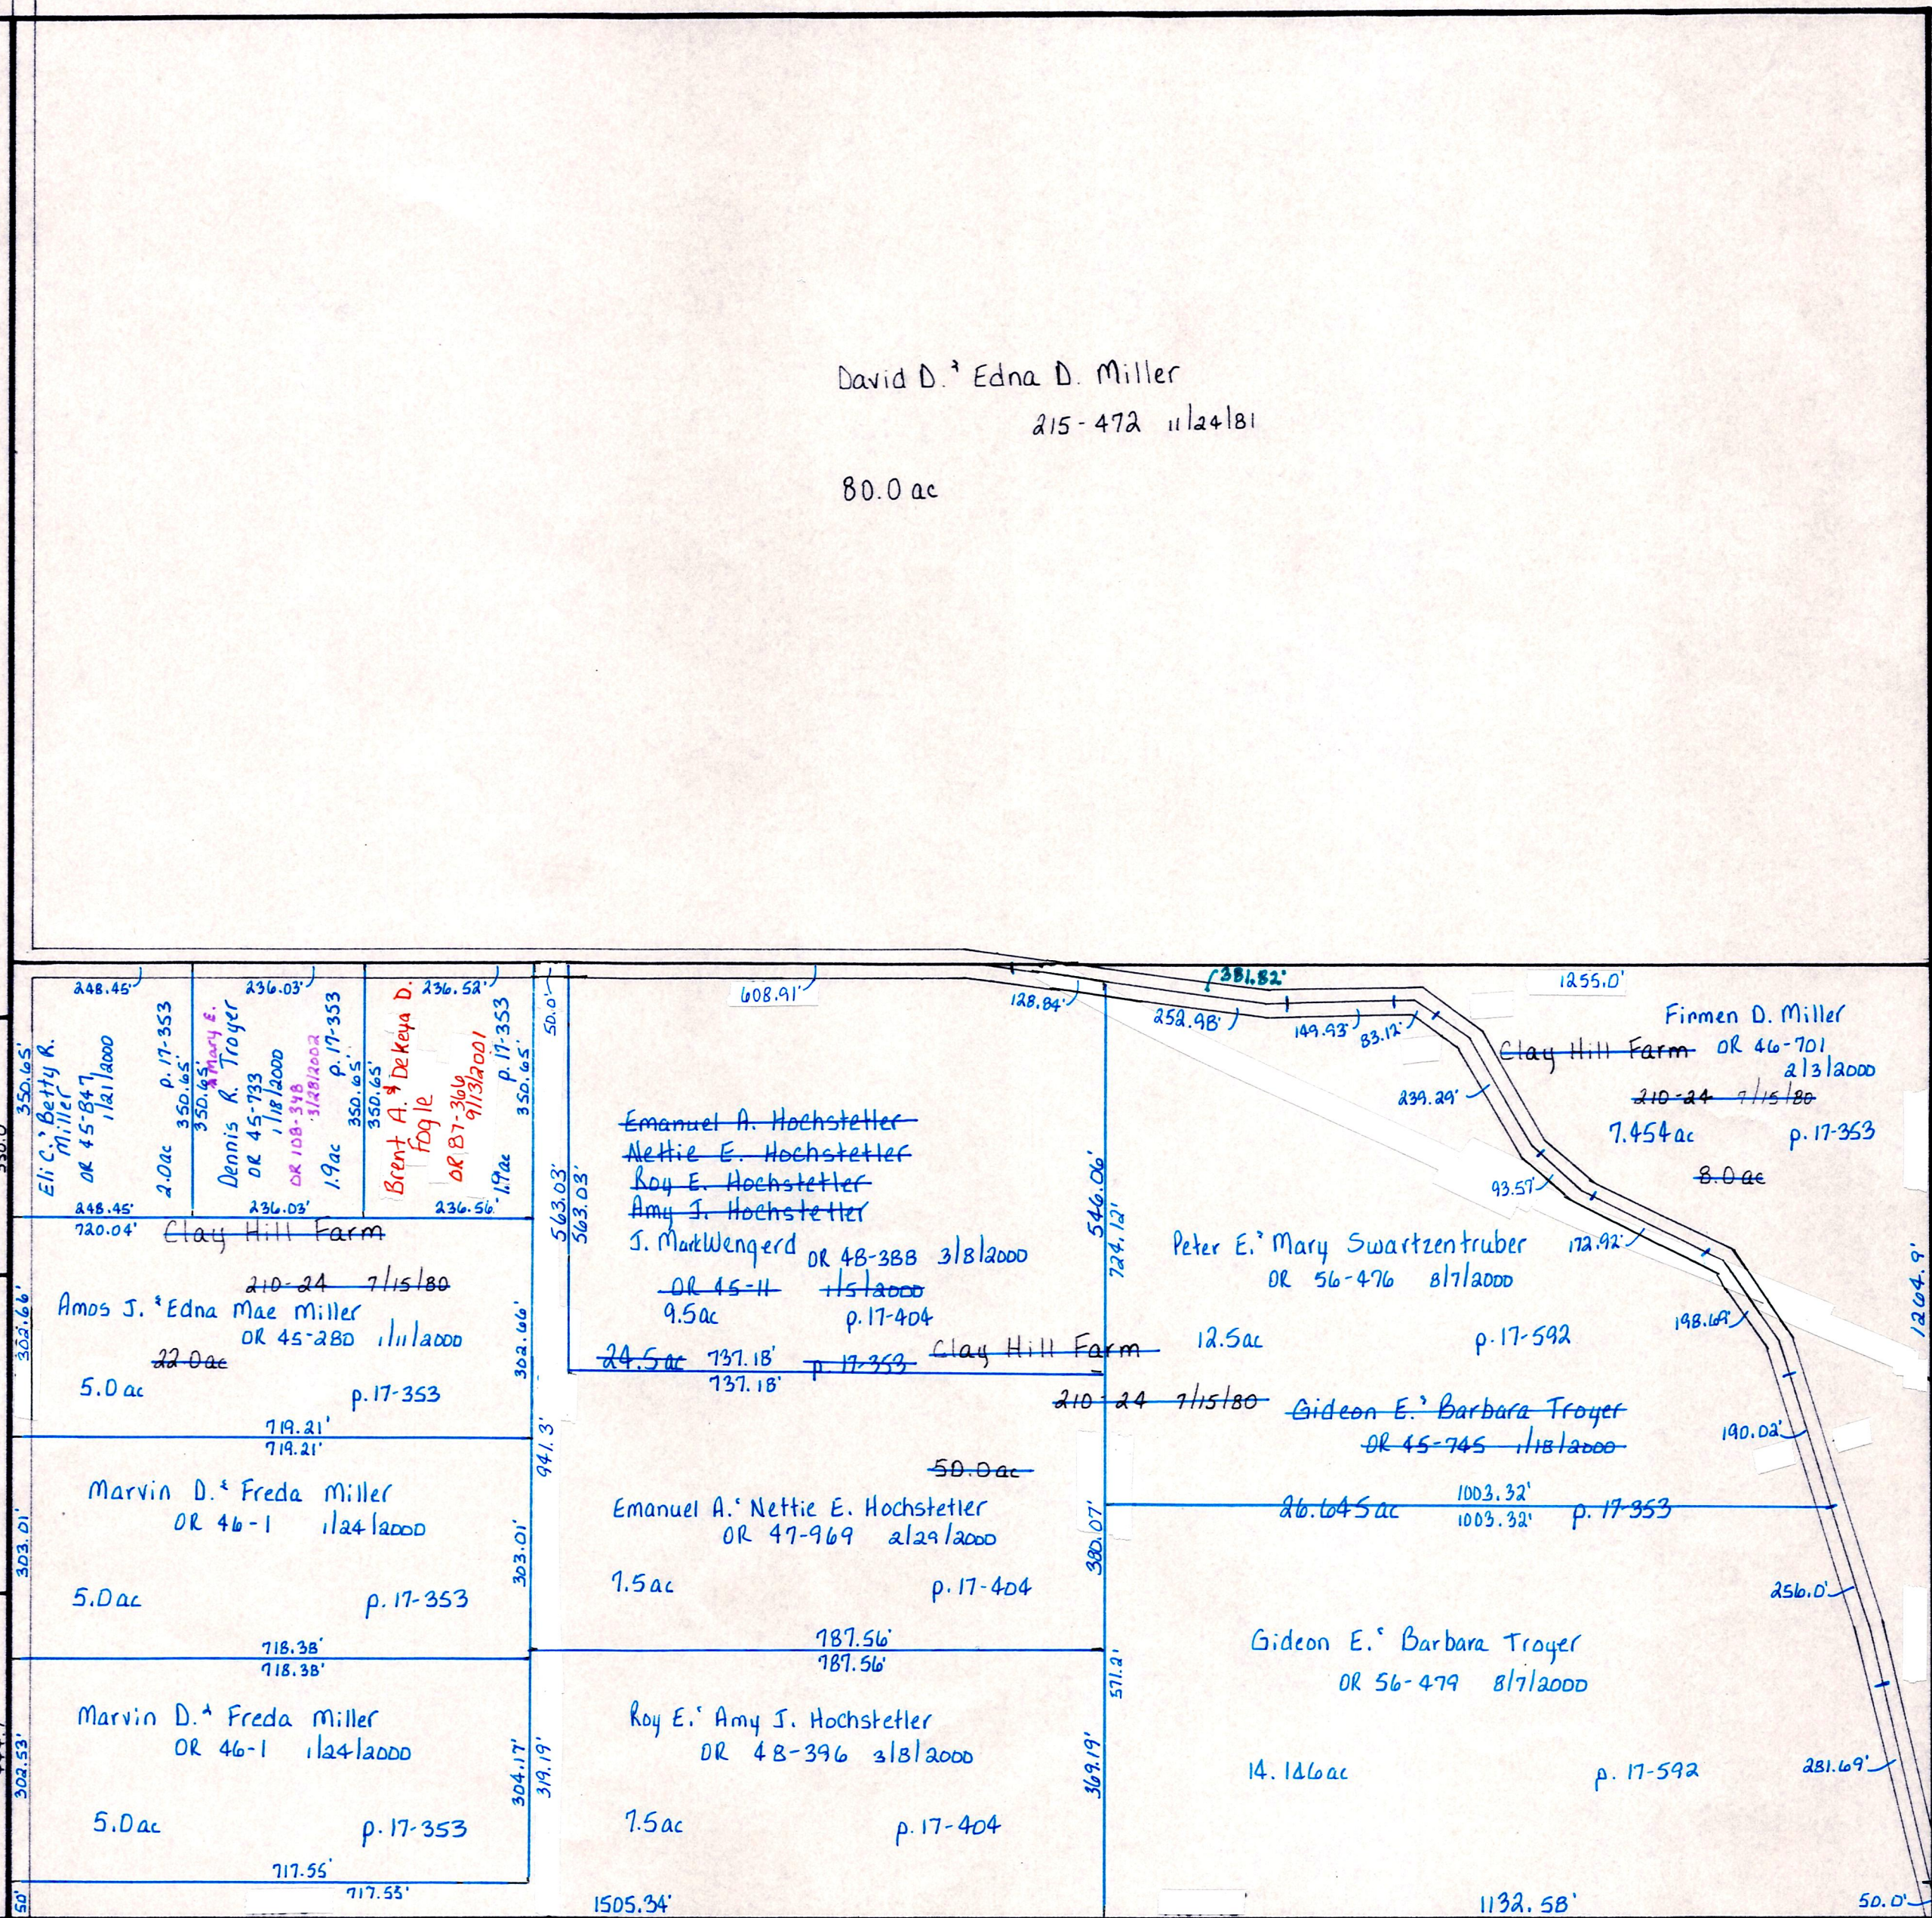


T.H. 564  
Old T.H. 391  
40' R/W

T.H. 565  
Old T.H. 246  
R/W unknown



Sec. 26

T.H. 561  
Old T.H. 246  
R/W unknown

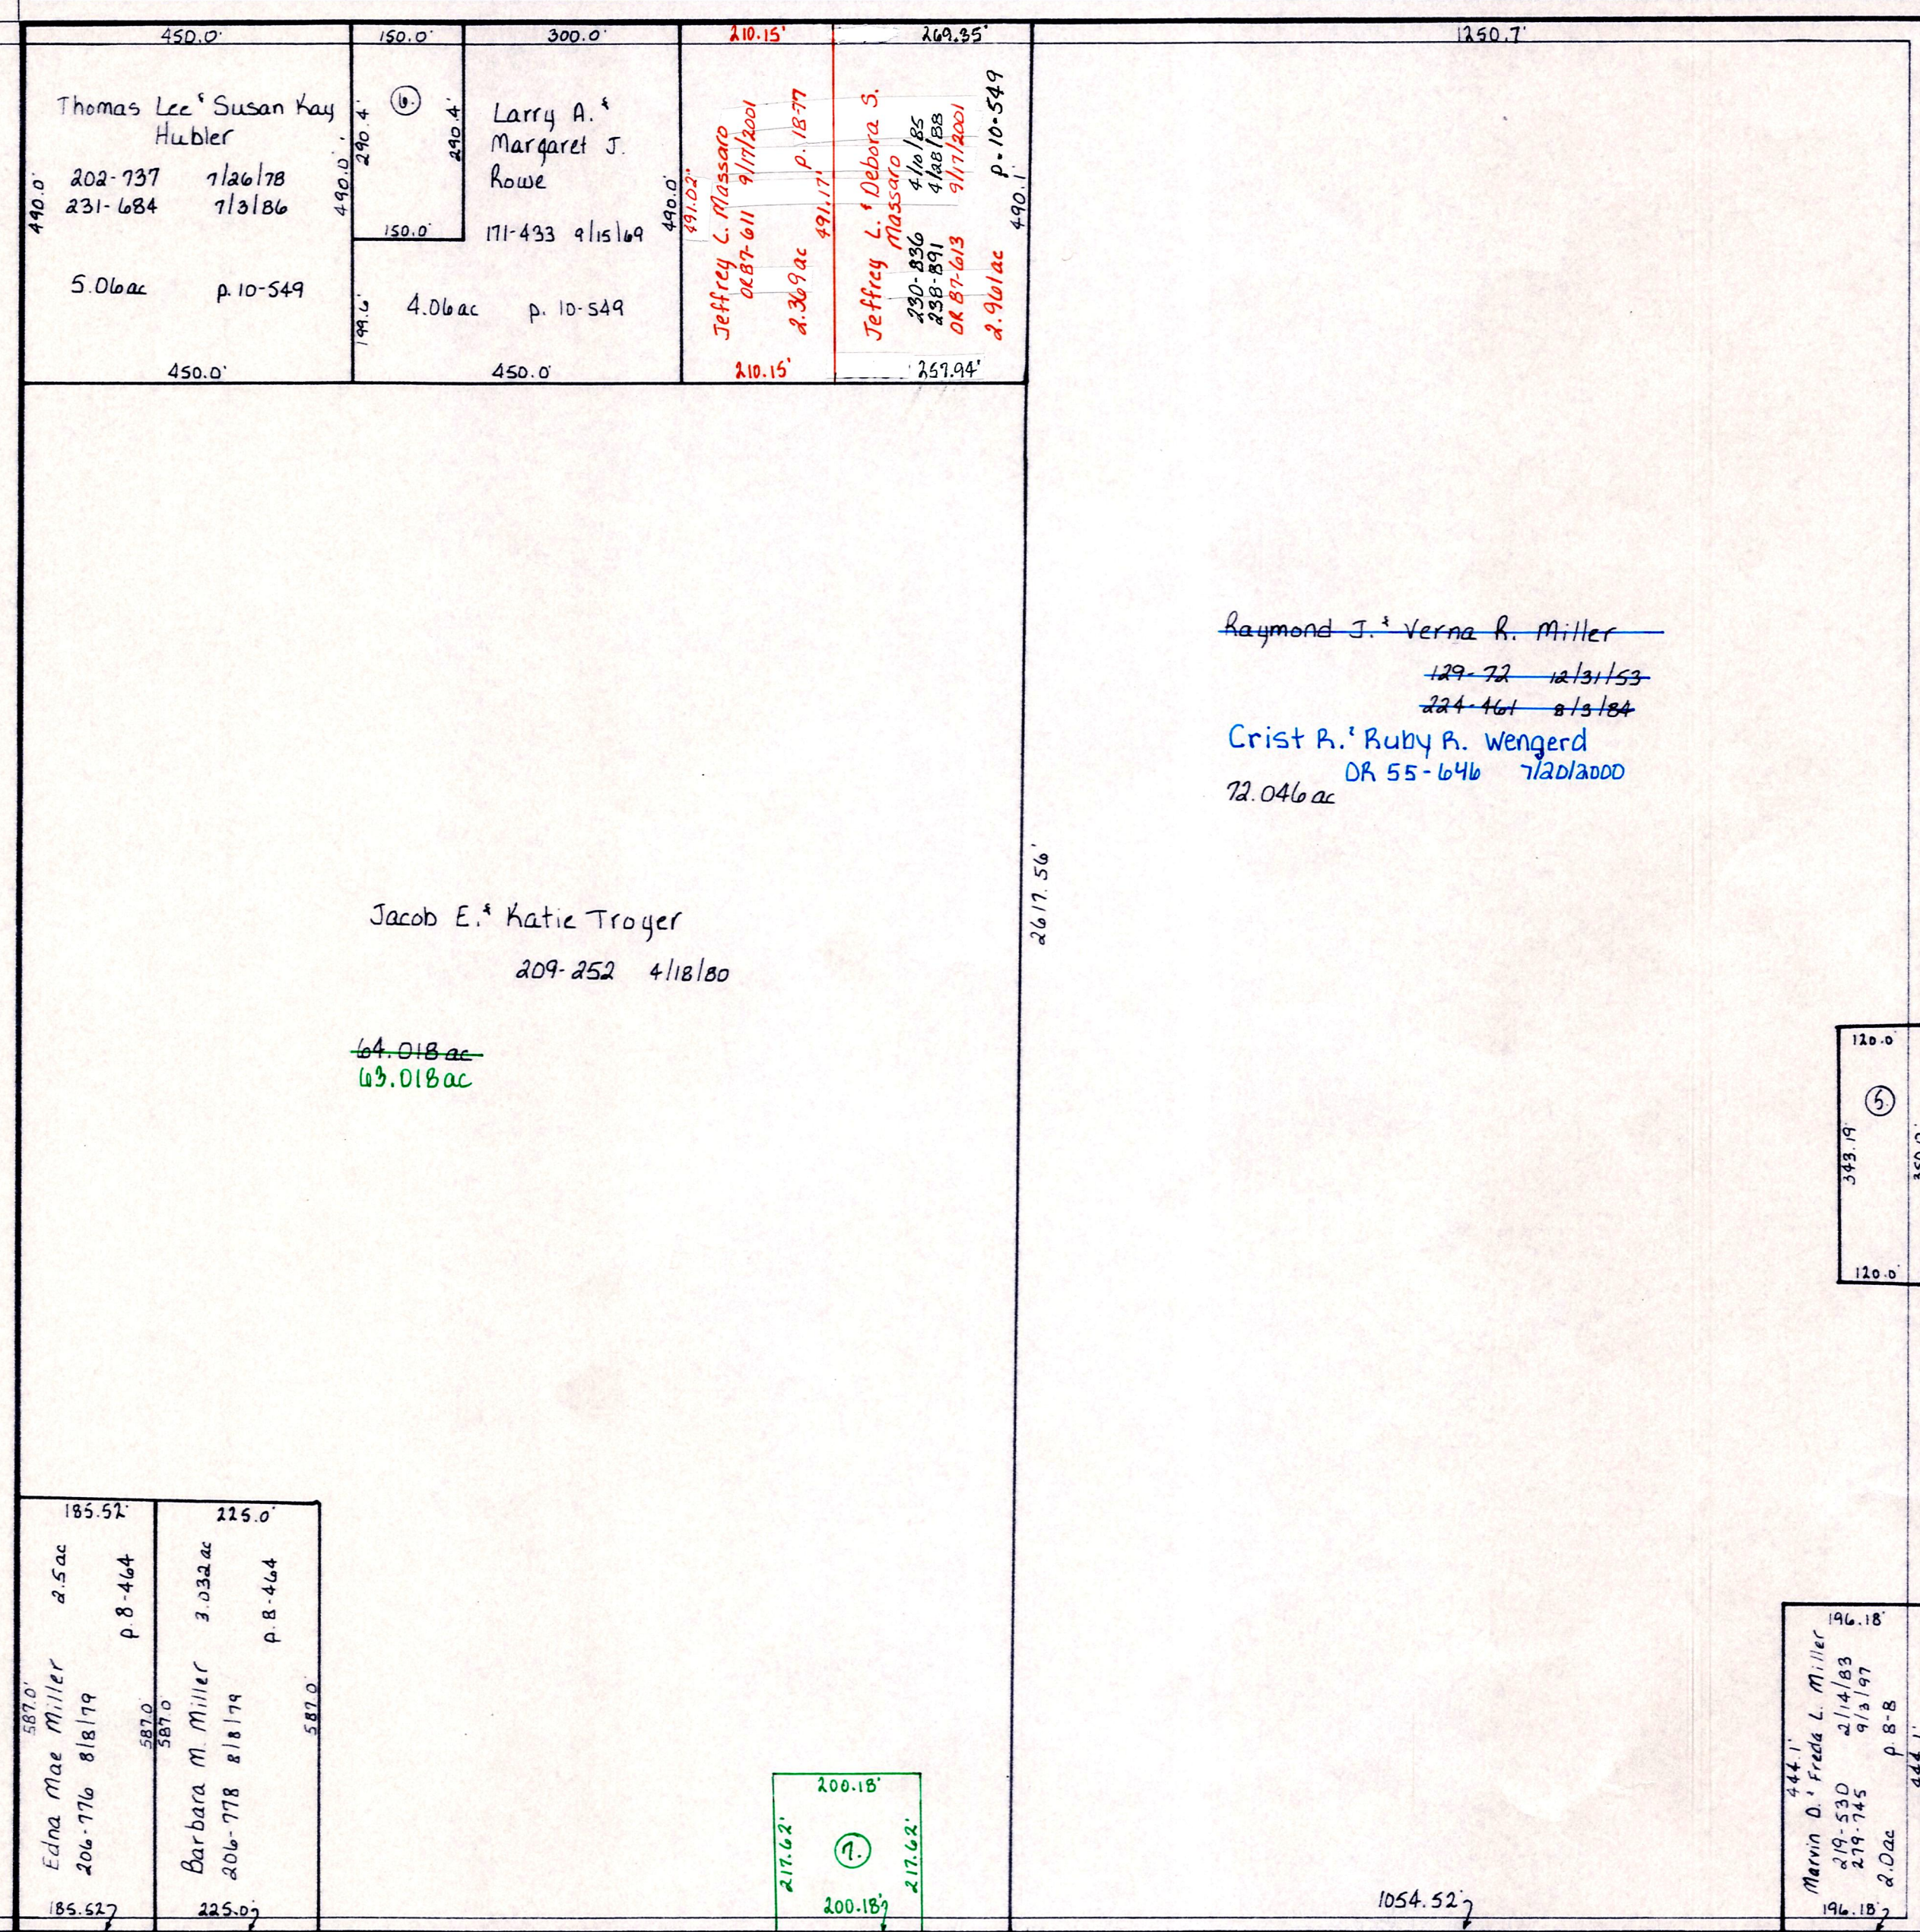

T.H. 565  
Old T.H. 248  
40' R/W

Sec. 34

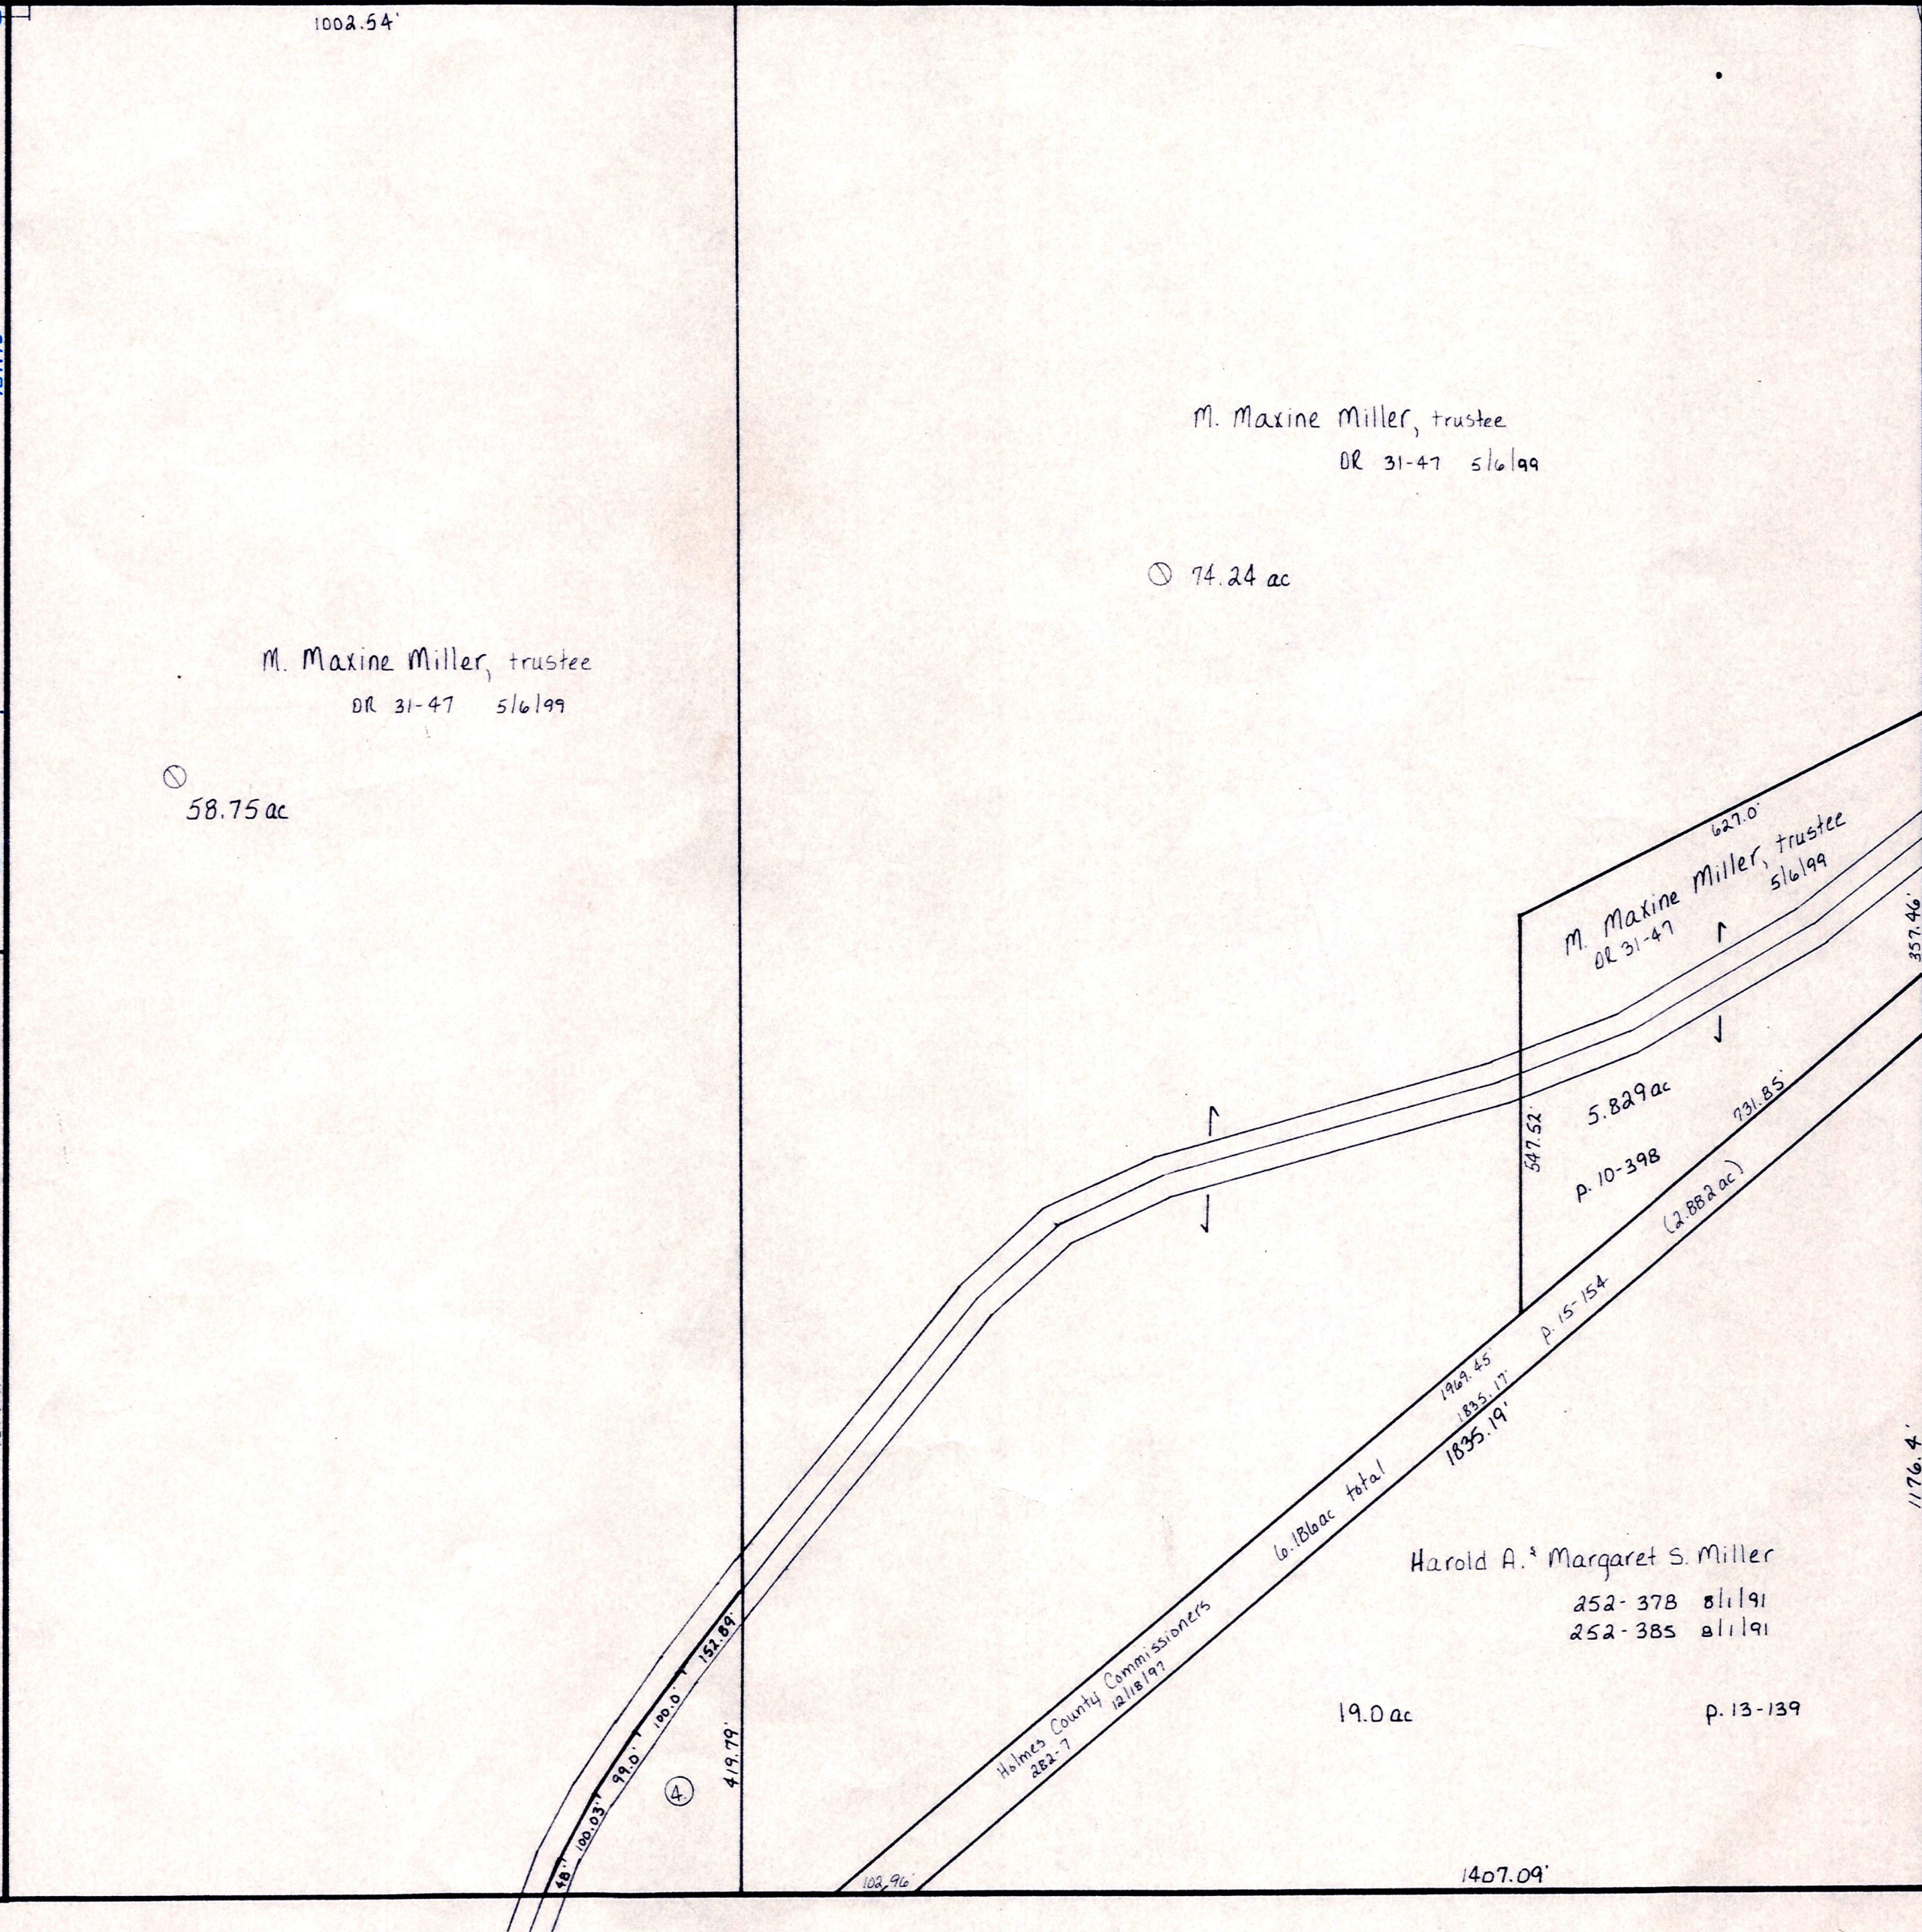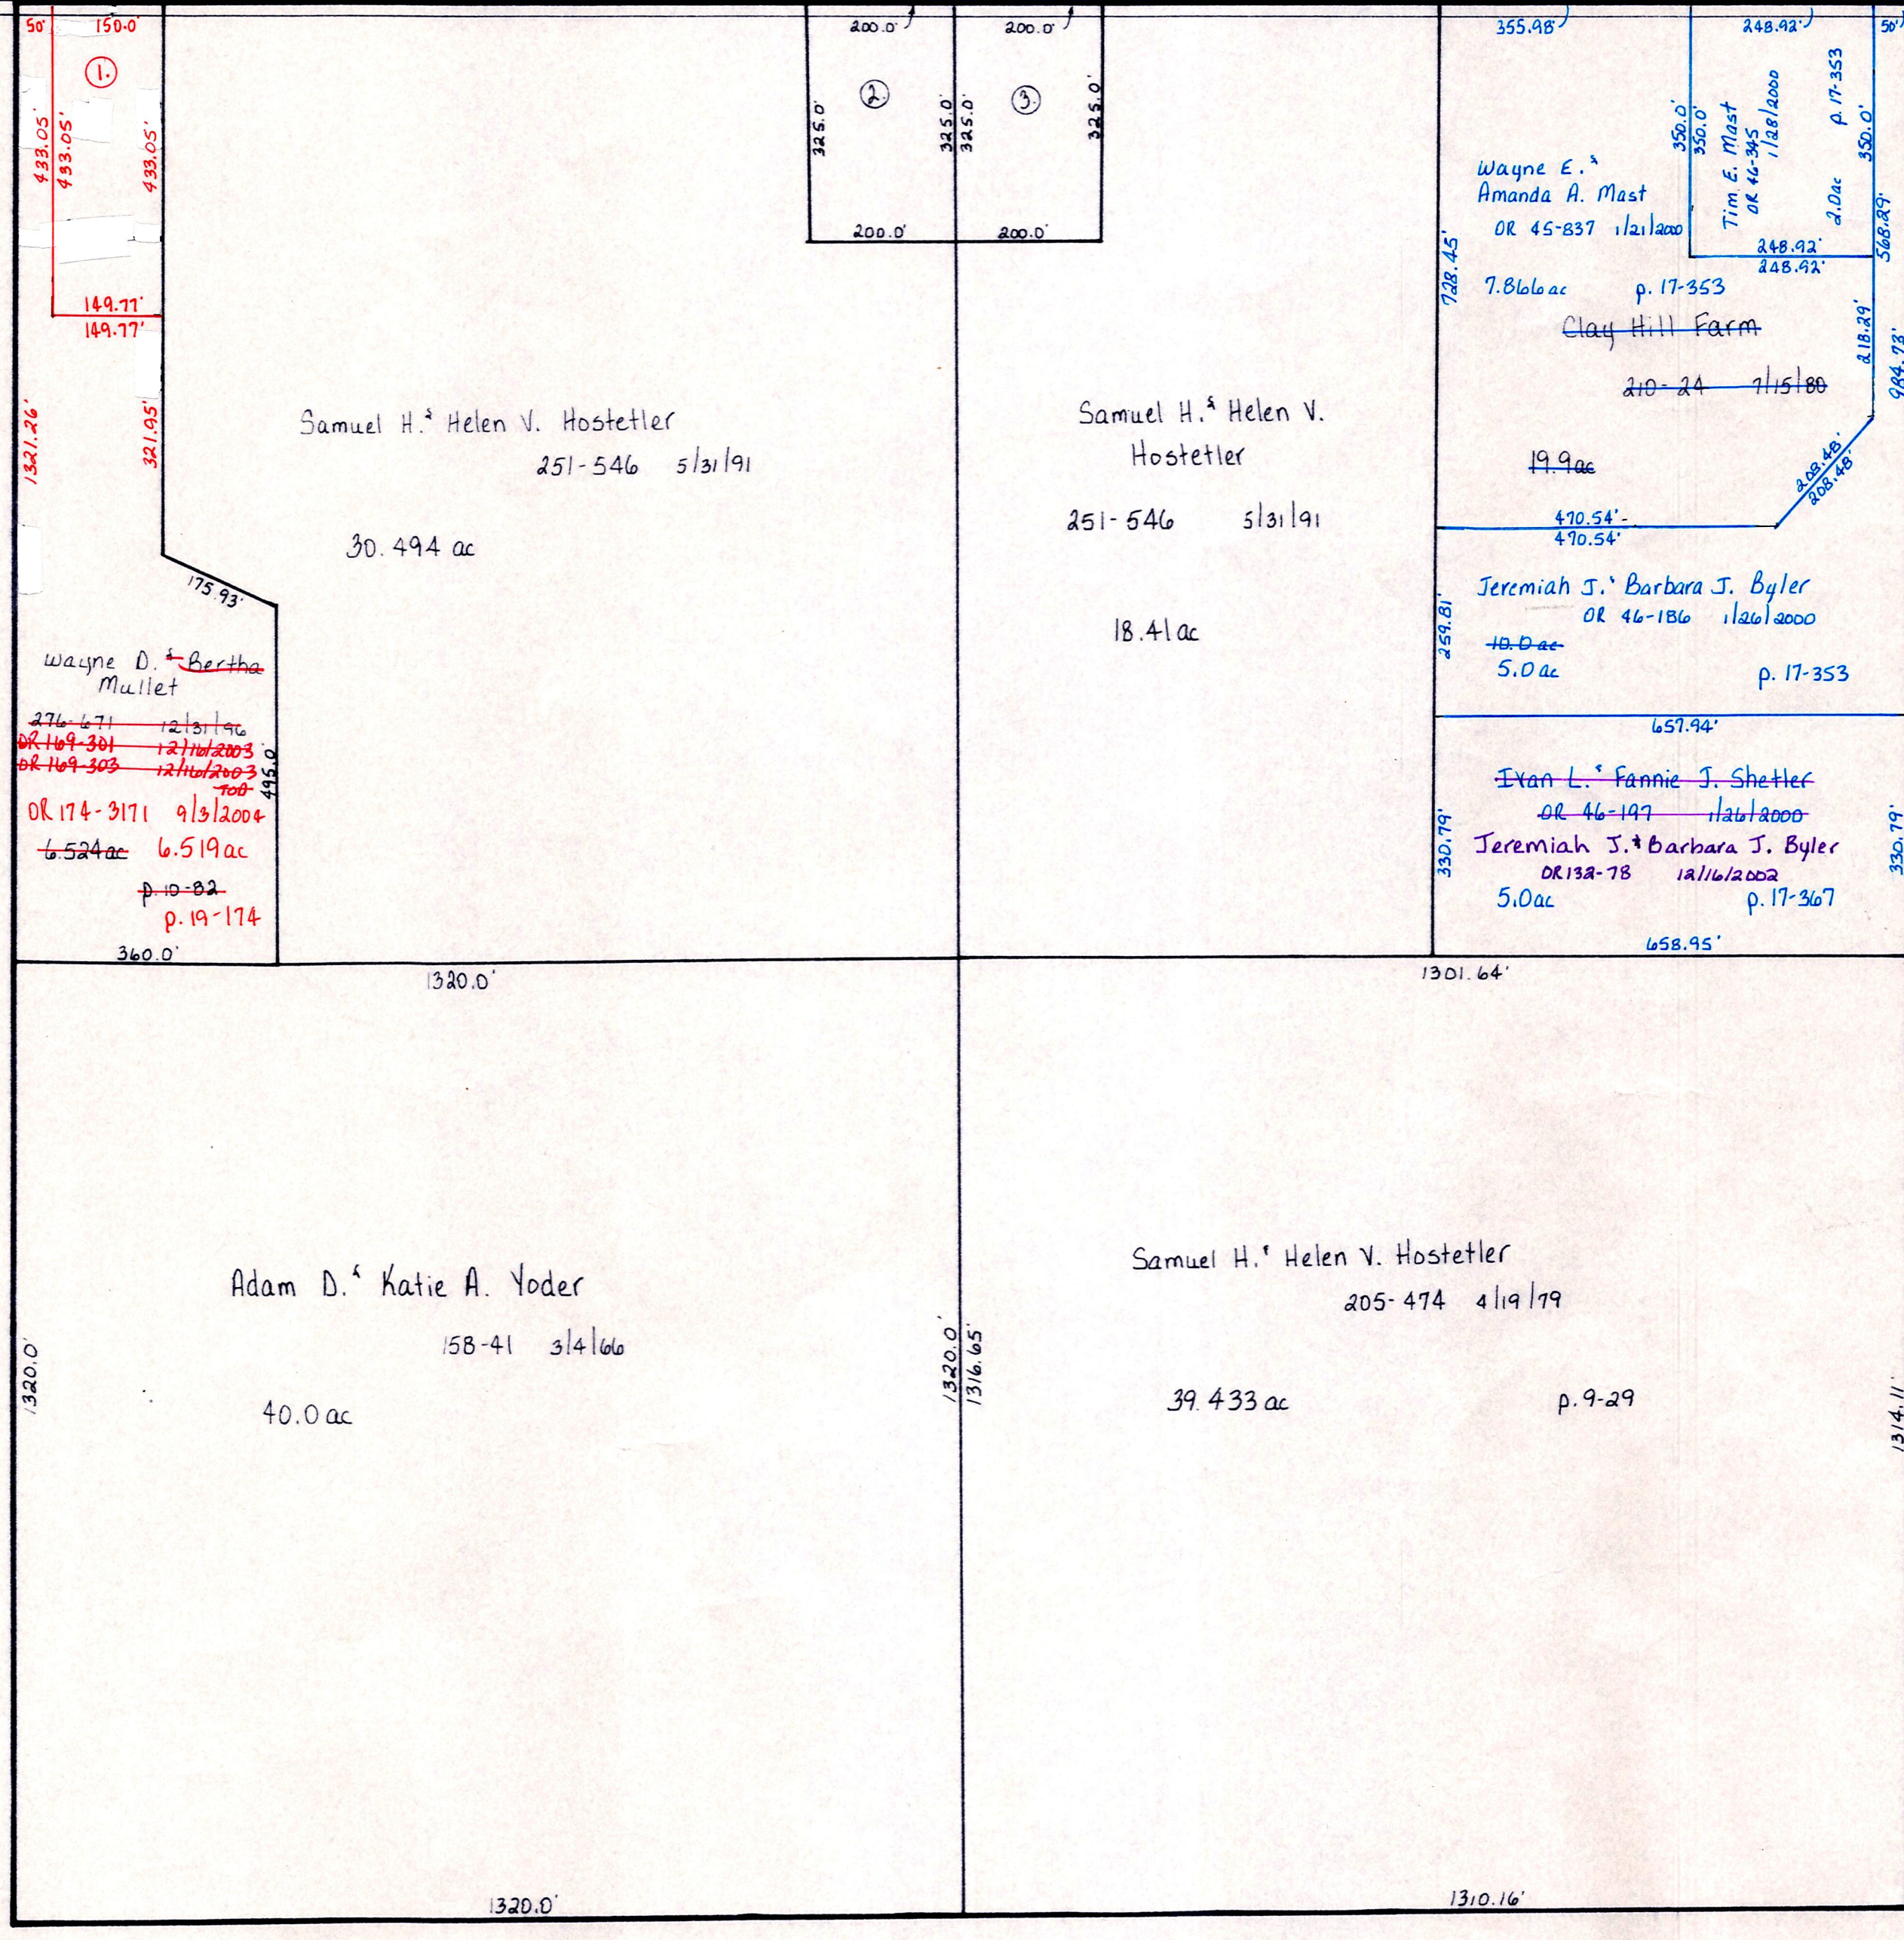

T.H. 567  
Old T.H. 249  
40' R/W

C.H. 192  
60' R/W

Sec. 2

C.H. 192  
60' R/W

LET IT BE KNOWN, THIS MAP HAS BEEN PREPARED AS A REFERENCE GUIDE TO PROPERTY OWNERSHIP. WE BELIEVE THIS INFORMATION TO BE CORRECT AND CURRENT, HOWEVER, IT IS NOT INTENDED FOR ANY LEGAL USE, WHETHER IT BE IN SALES, TRANSFERS, TRADES, LEASES OF ANY TYPE, ETC., AND DO NOT ACCEPT RESPONSIBILITY FOR ERRORS OF ANY NATURE OR OMISSIONS CONTAINED HEREIN.

T-14, R-13, Sec. 35  
Prairie Township

HOLMES CO. OHIO  
SCALE: 1" = 200'

PR-27