


Ac.	Owner	R.	T.	Vol.	P.
0.25	Larry Burrows	9	8	101	556
	Survey for Transfer				

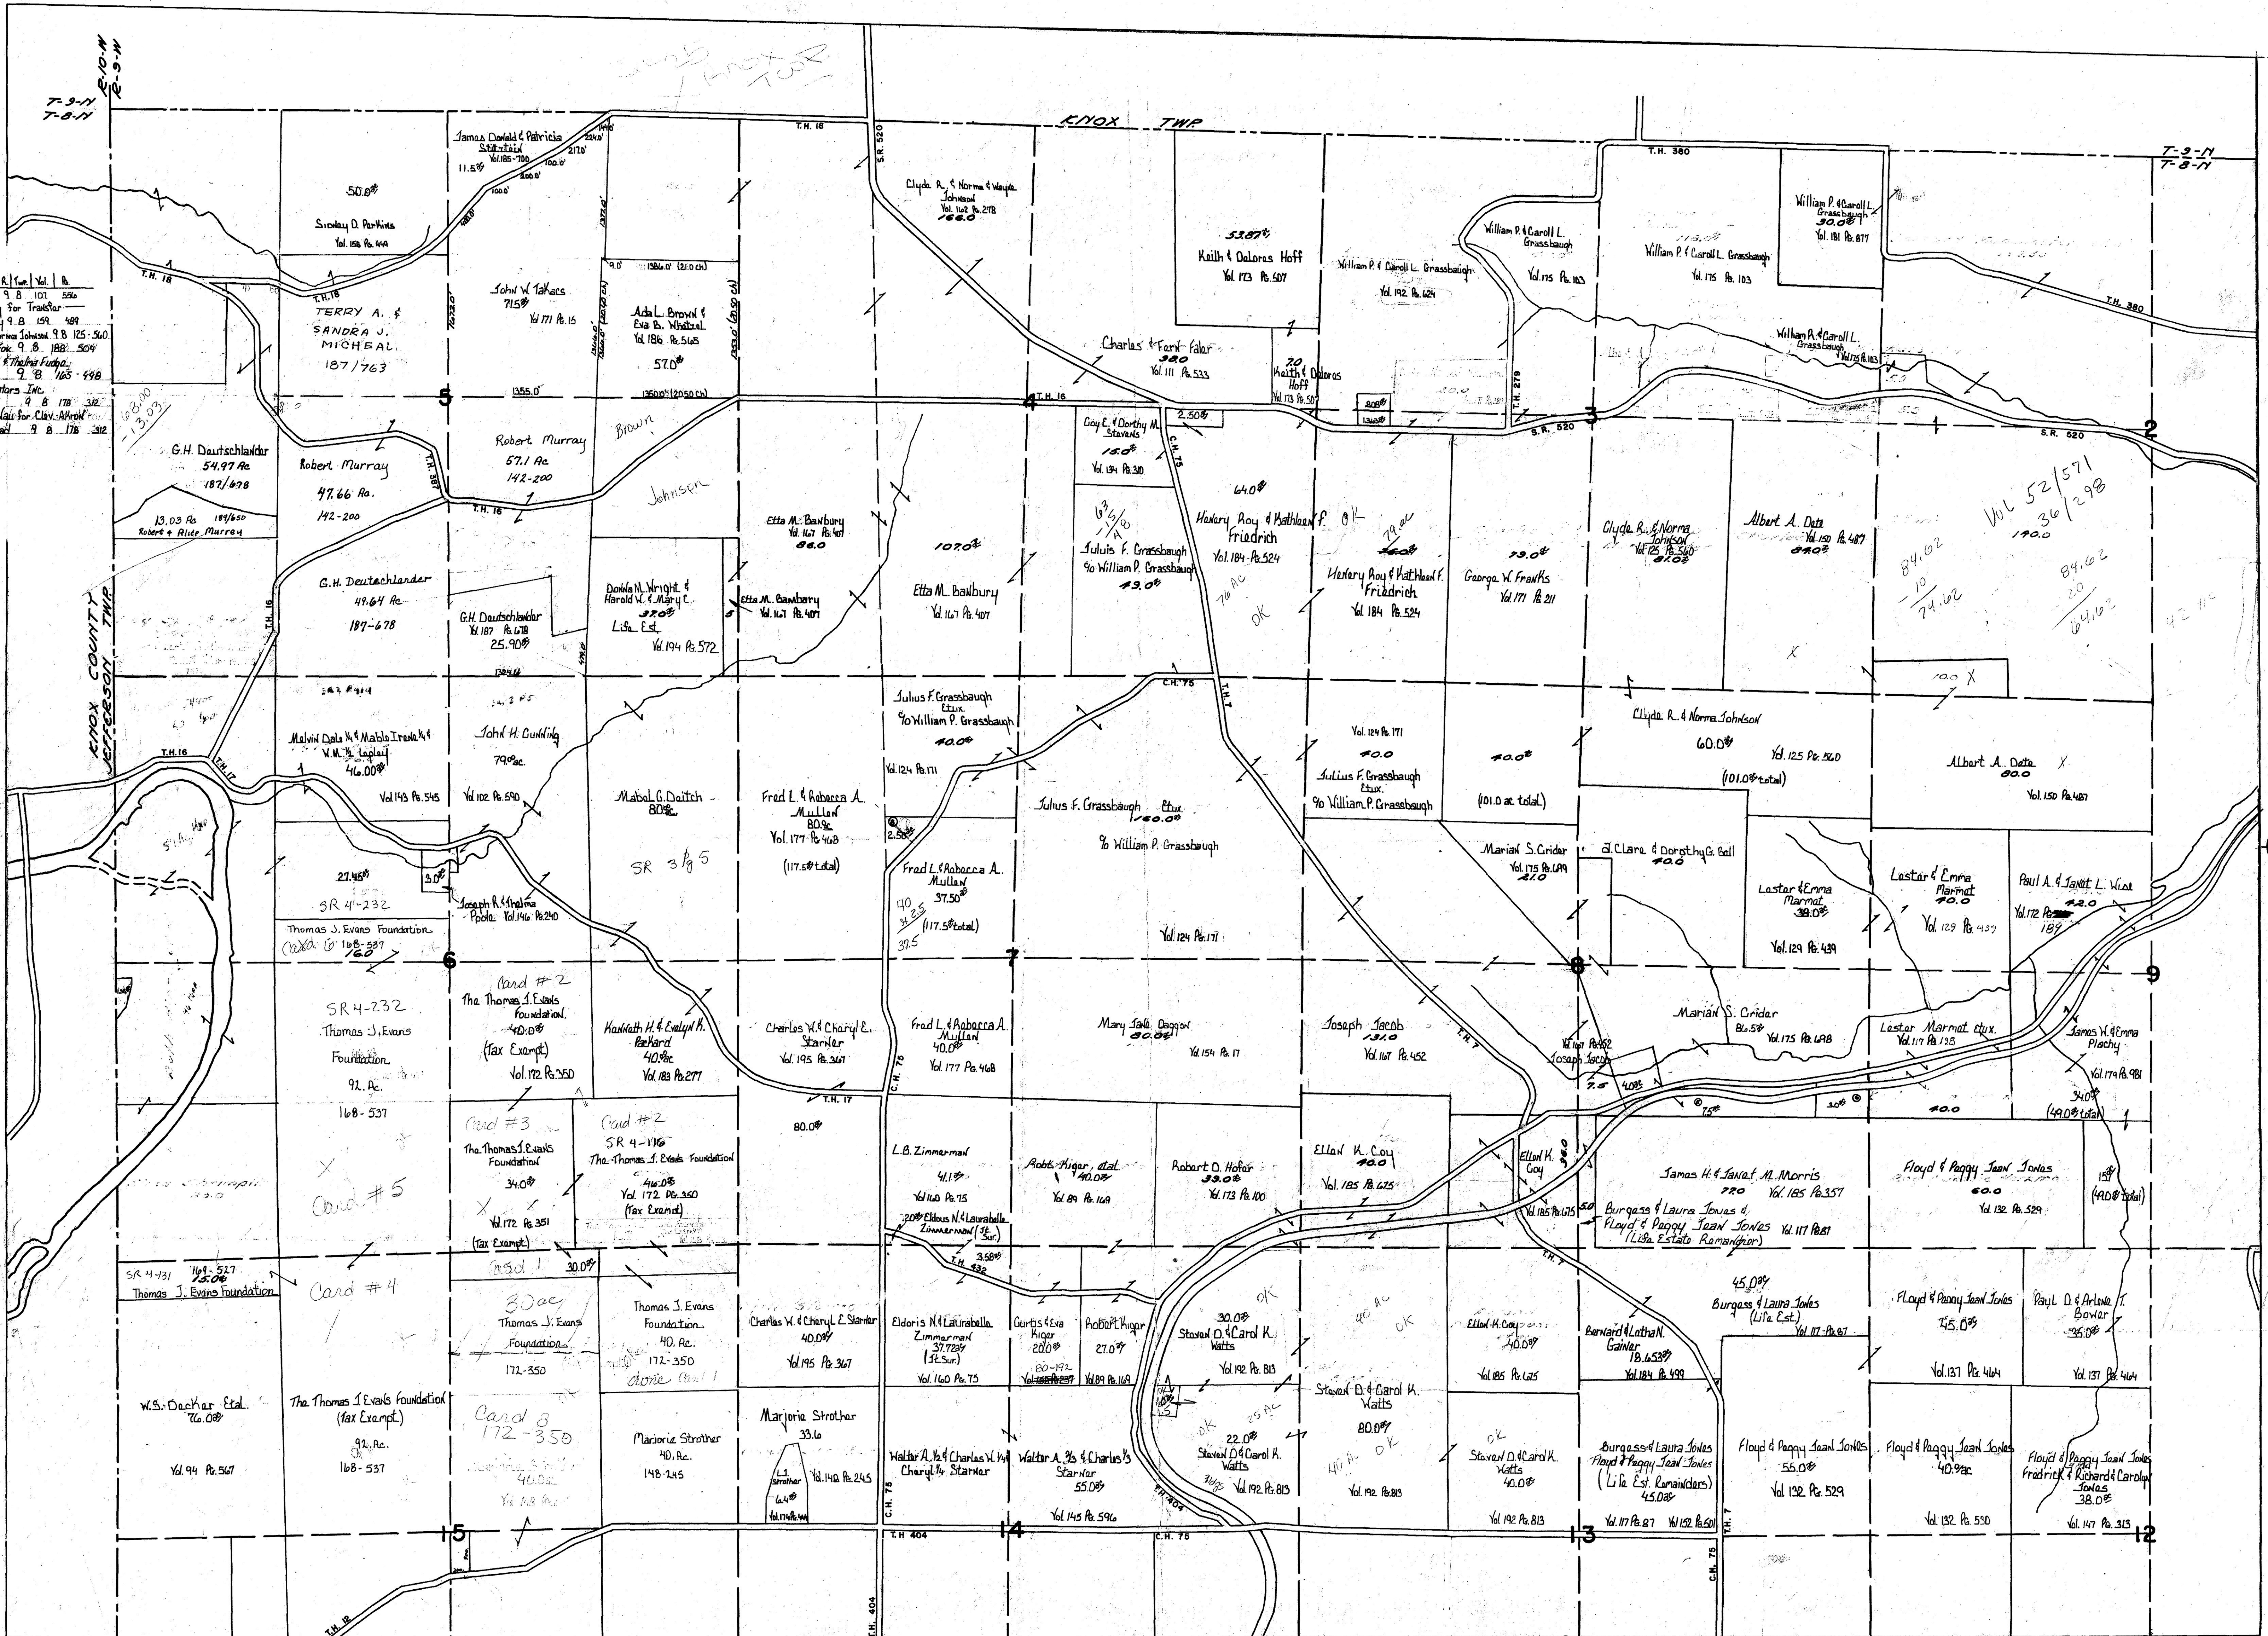

**HOLMES COUNTY
RICHLAND TOWNSHIP
N.W. PART**

SCALE: 1" = 660'