


Knox Twp.

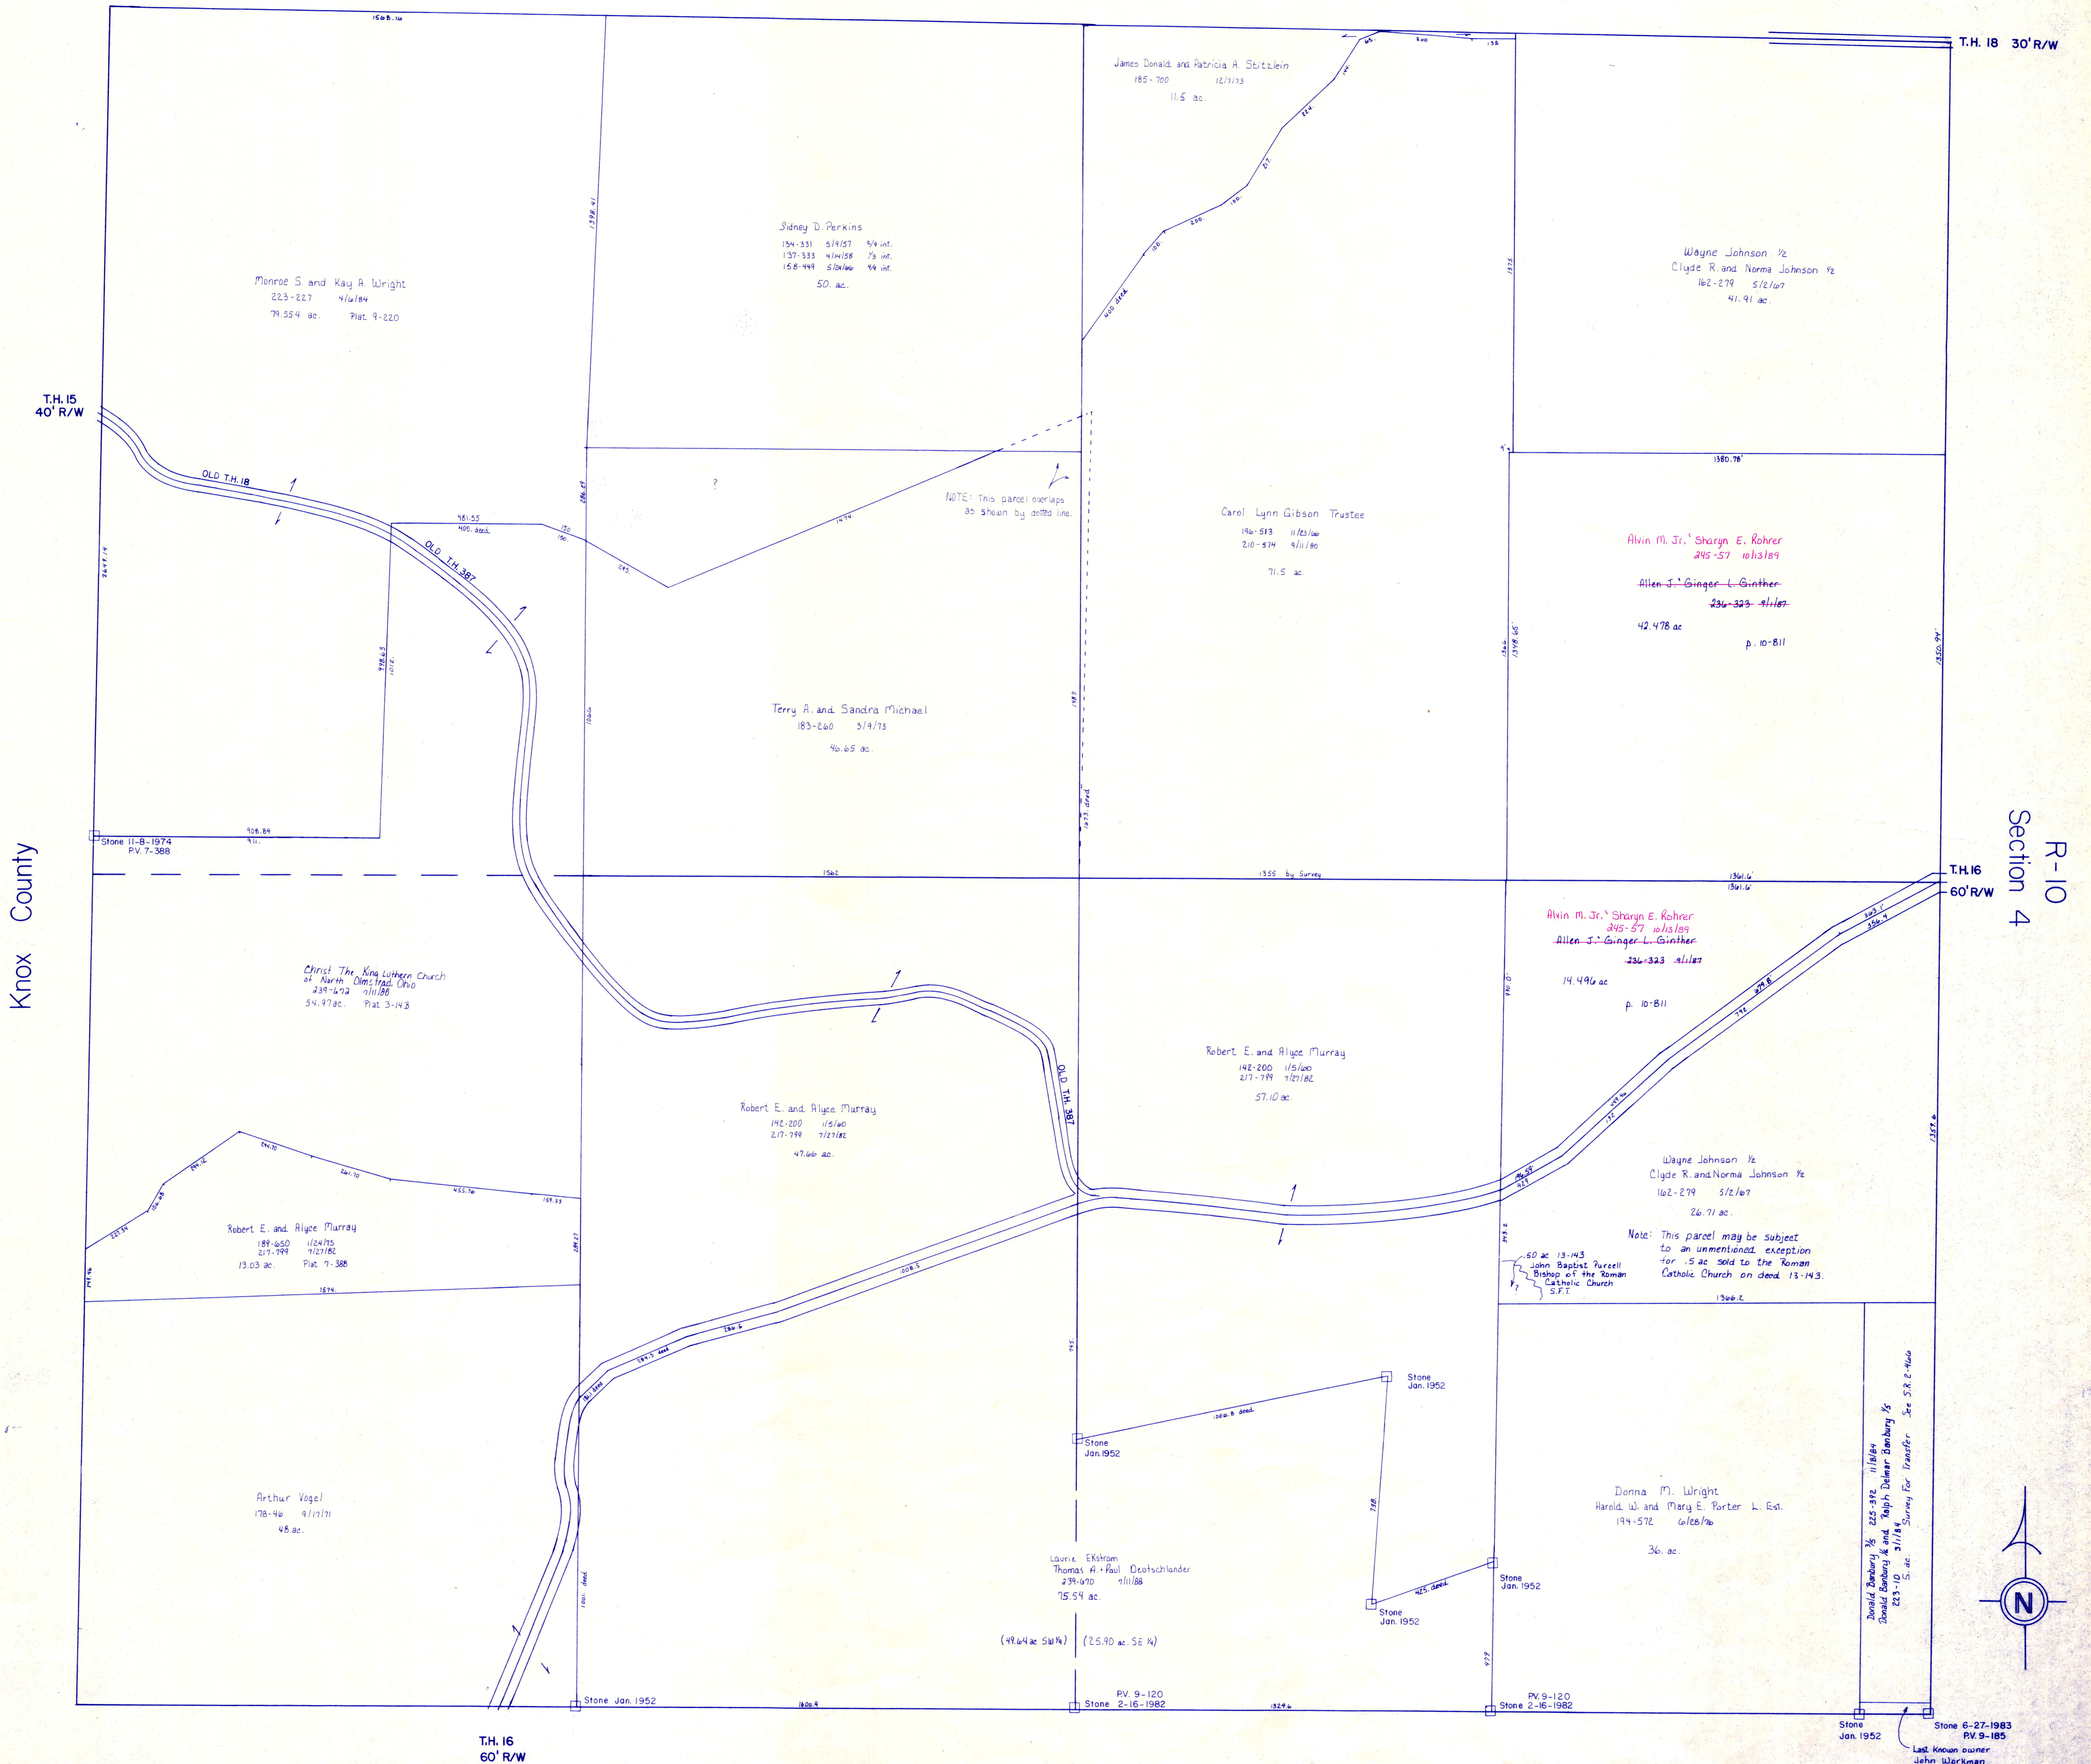


Knox County

Section 4
R-10

Section 6
R-4

T-8, R-9, Sec. 5
RICHLAND TWP.
SCALE 1" = 200'

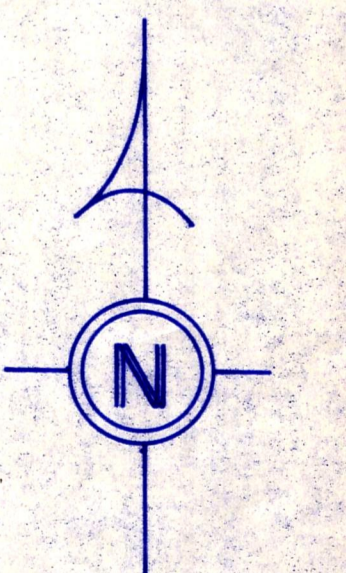

R-5