


Section 2  
R-20

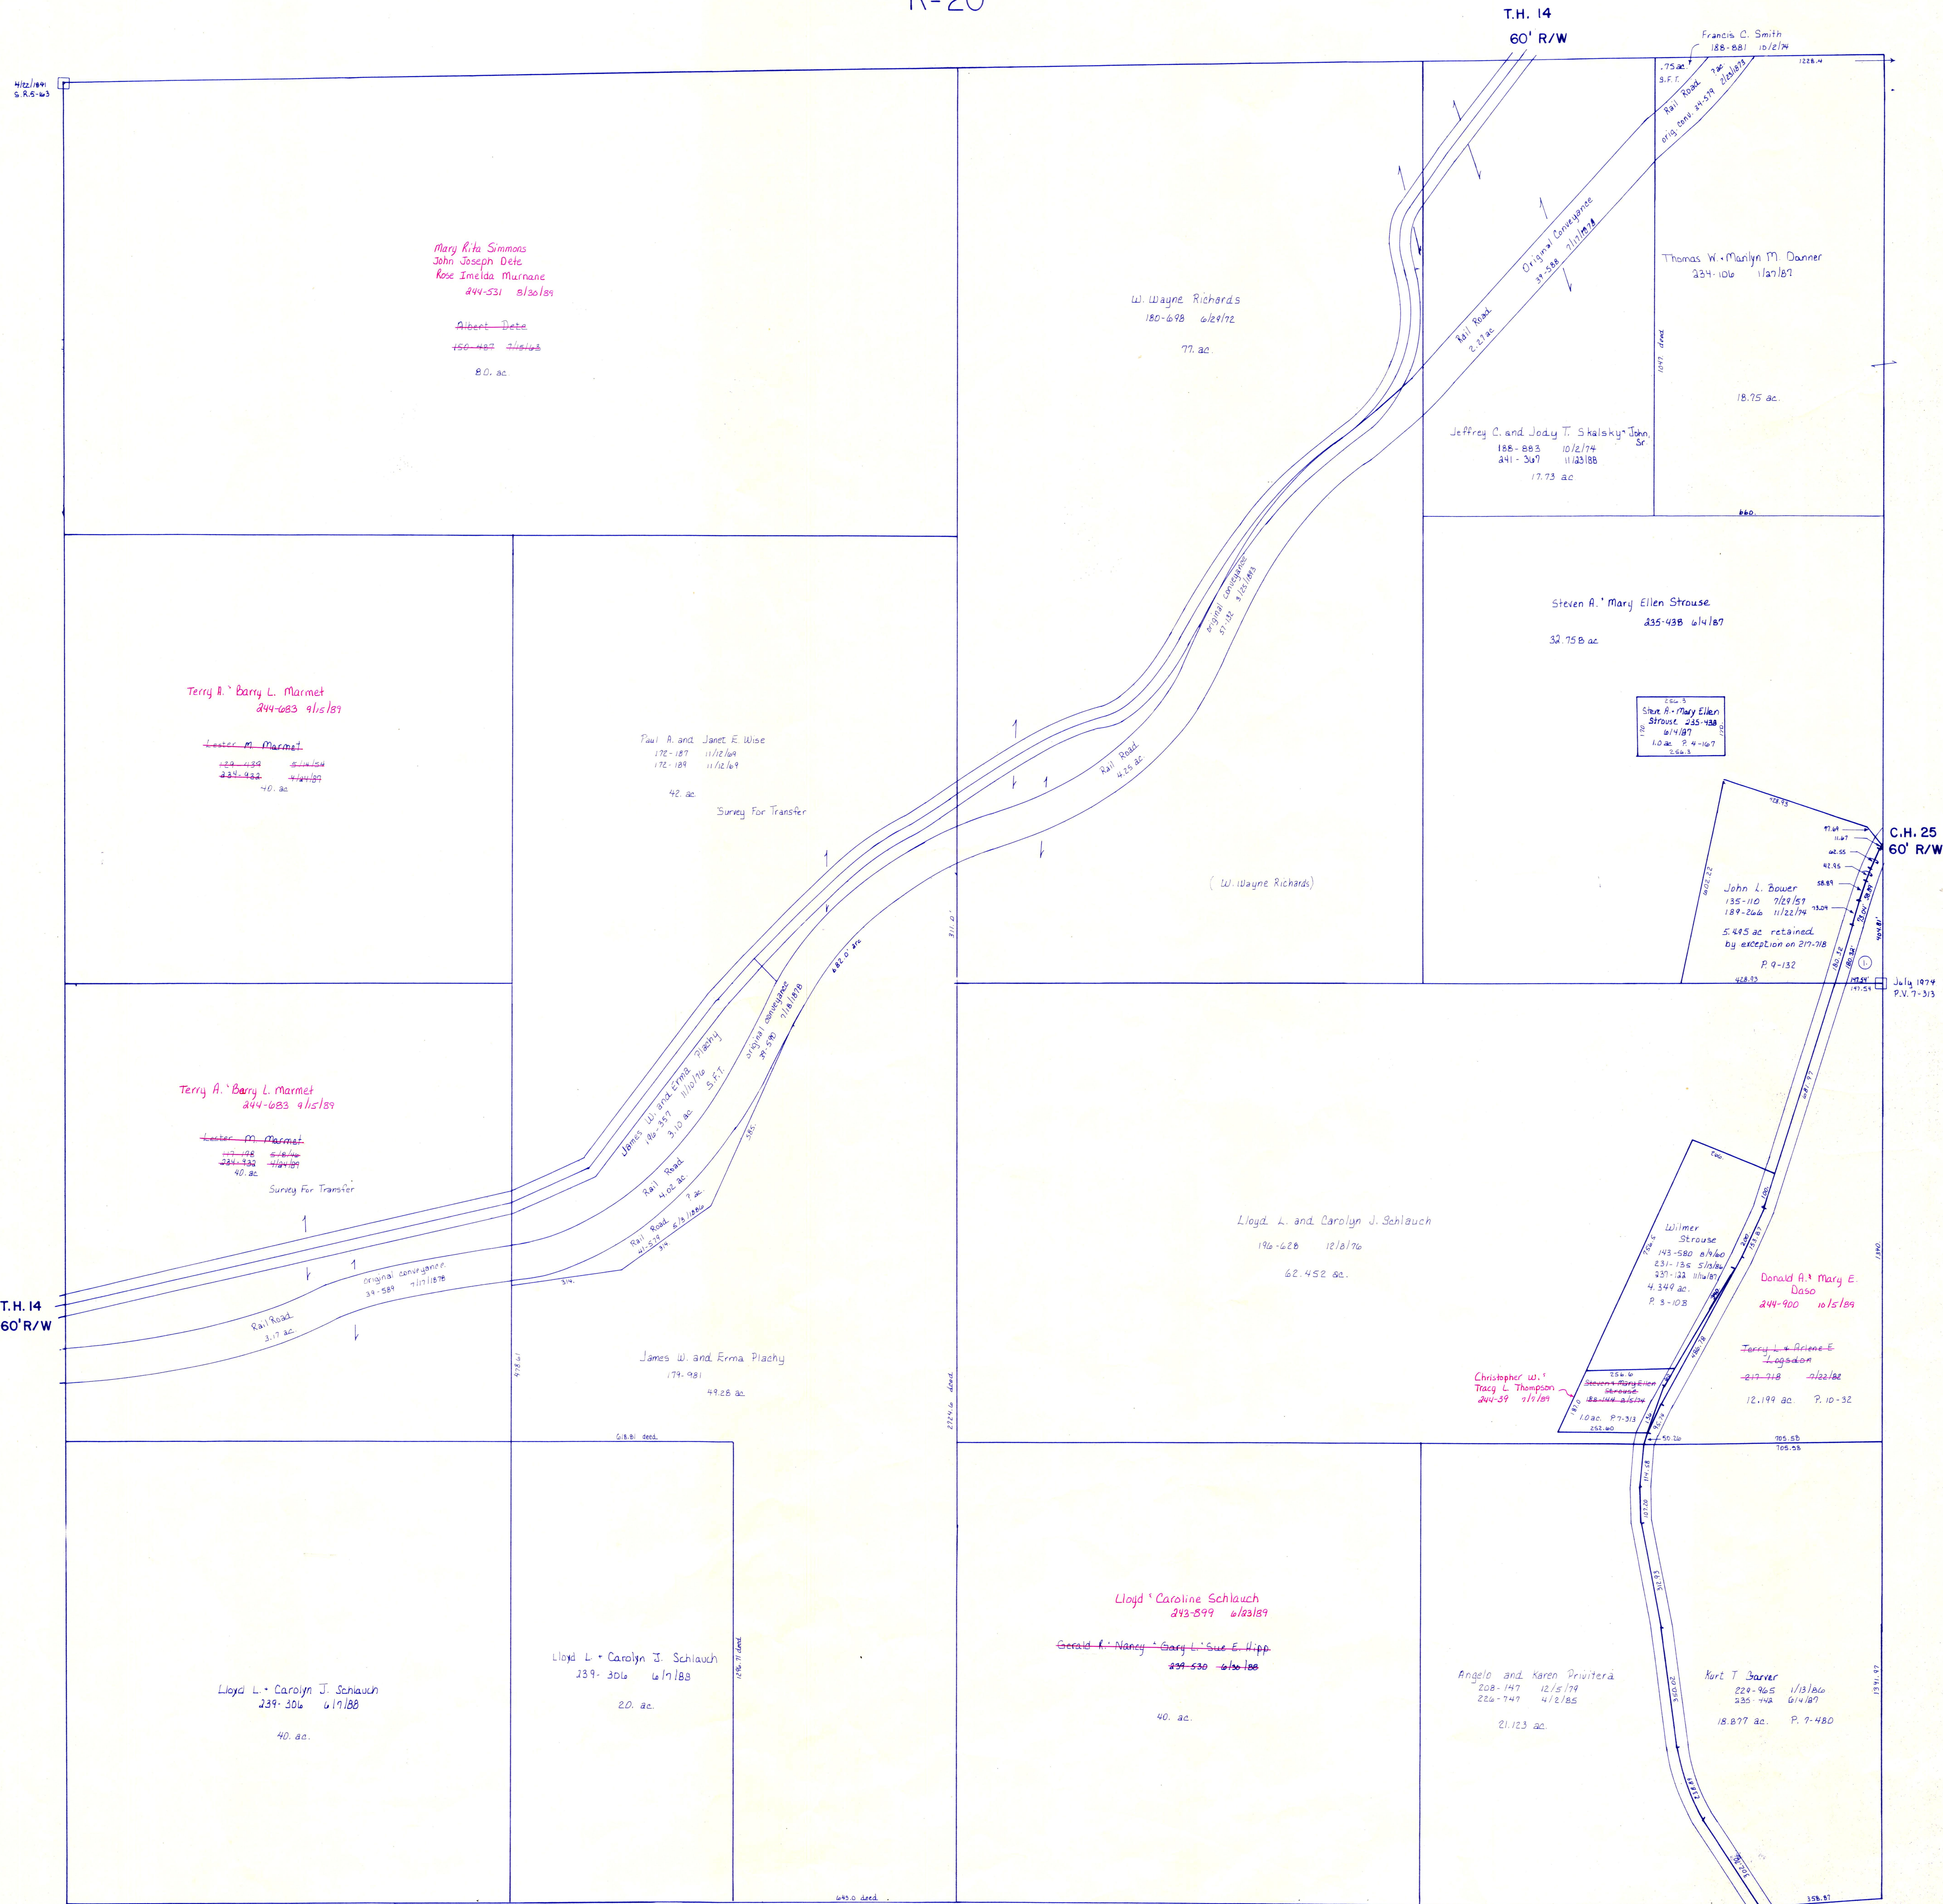

Section 8  
R-14

Section 10  
R-24

Donald A. & Mary E. Dase 244-900 10/1/89  
Terry L. & Arlene S. Logsdon 217-718 7/22/82 747 ac. ex. ex. on 235-438 p. 11-144

Section 12  
R-18

T-8, R-9, Sec. 9  
RICHLAND TWP.  
SCALE 1" = 200'

LET IT BE KNOWN, THIS MAP HAS BEEN PREPARED AS A REFERENCE GUIDE TO PROPERTY OWNERSHIP. WE BELIEVE THIS INFORMATION TO BE CORRECT AND CURRENT, HOWEVER, IT IS NOT INTENDED FOR ANY LEGAL USE, WHETHER IT BE IN SALES, TRANSFERS, TRADES, LEASES OF ANY TYPE, ETC., AND DO NOT ACCEPT RESPONSIBILITY FOR ERRORS OF ANY NATURE OR OMISSIONS CONTAINED HEREIN.

R-19