

Monroe Twp.

T.H. 221 60'R/W
OLD T.H. 278


C.H. 51
60'R/W

T.H. 251 40'R/W
OLD T.H. 284

T.H. 36 R/W-Unknown
OLD T.H. 283

Section 1
R-25

Section 4
R-35

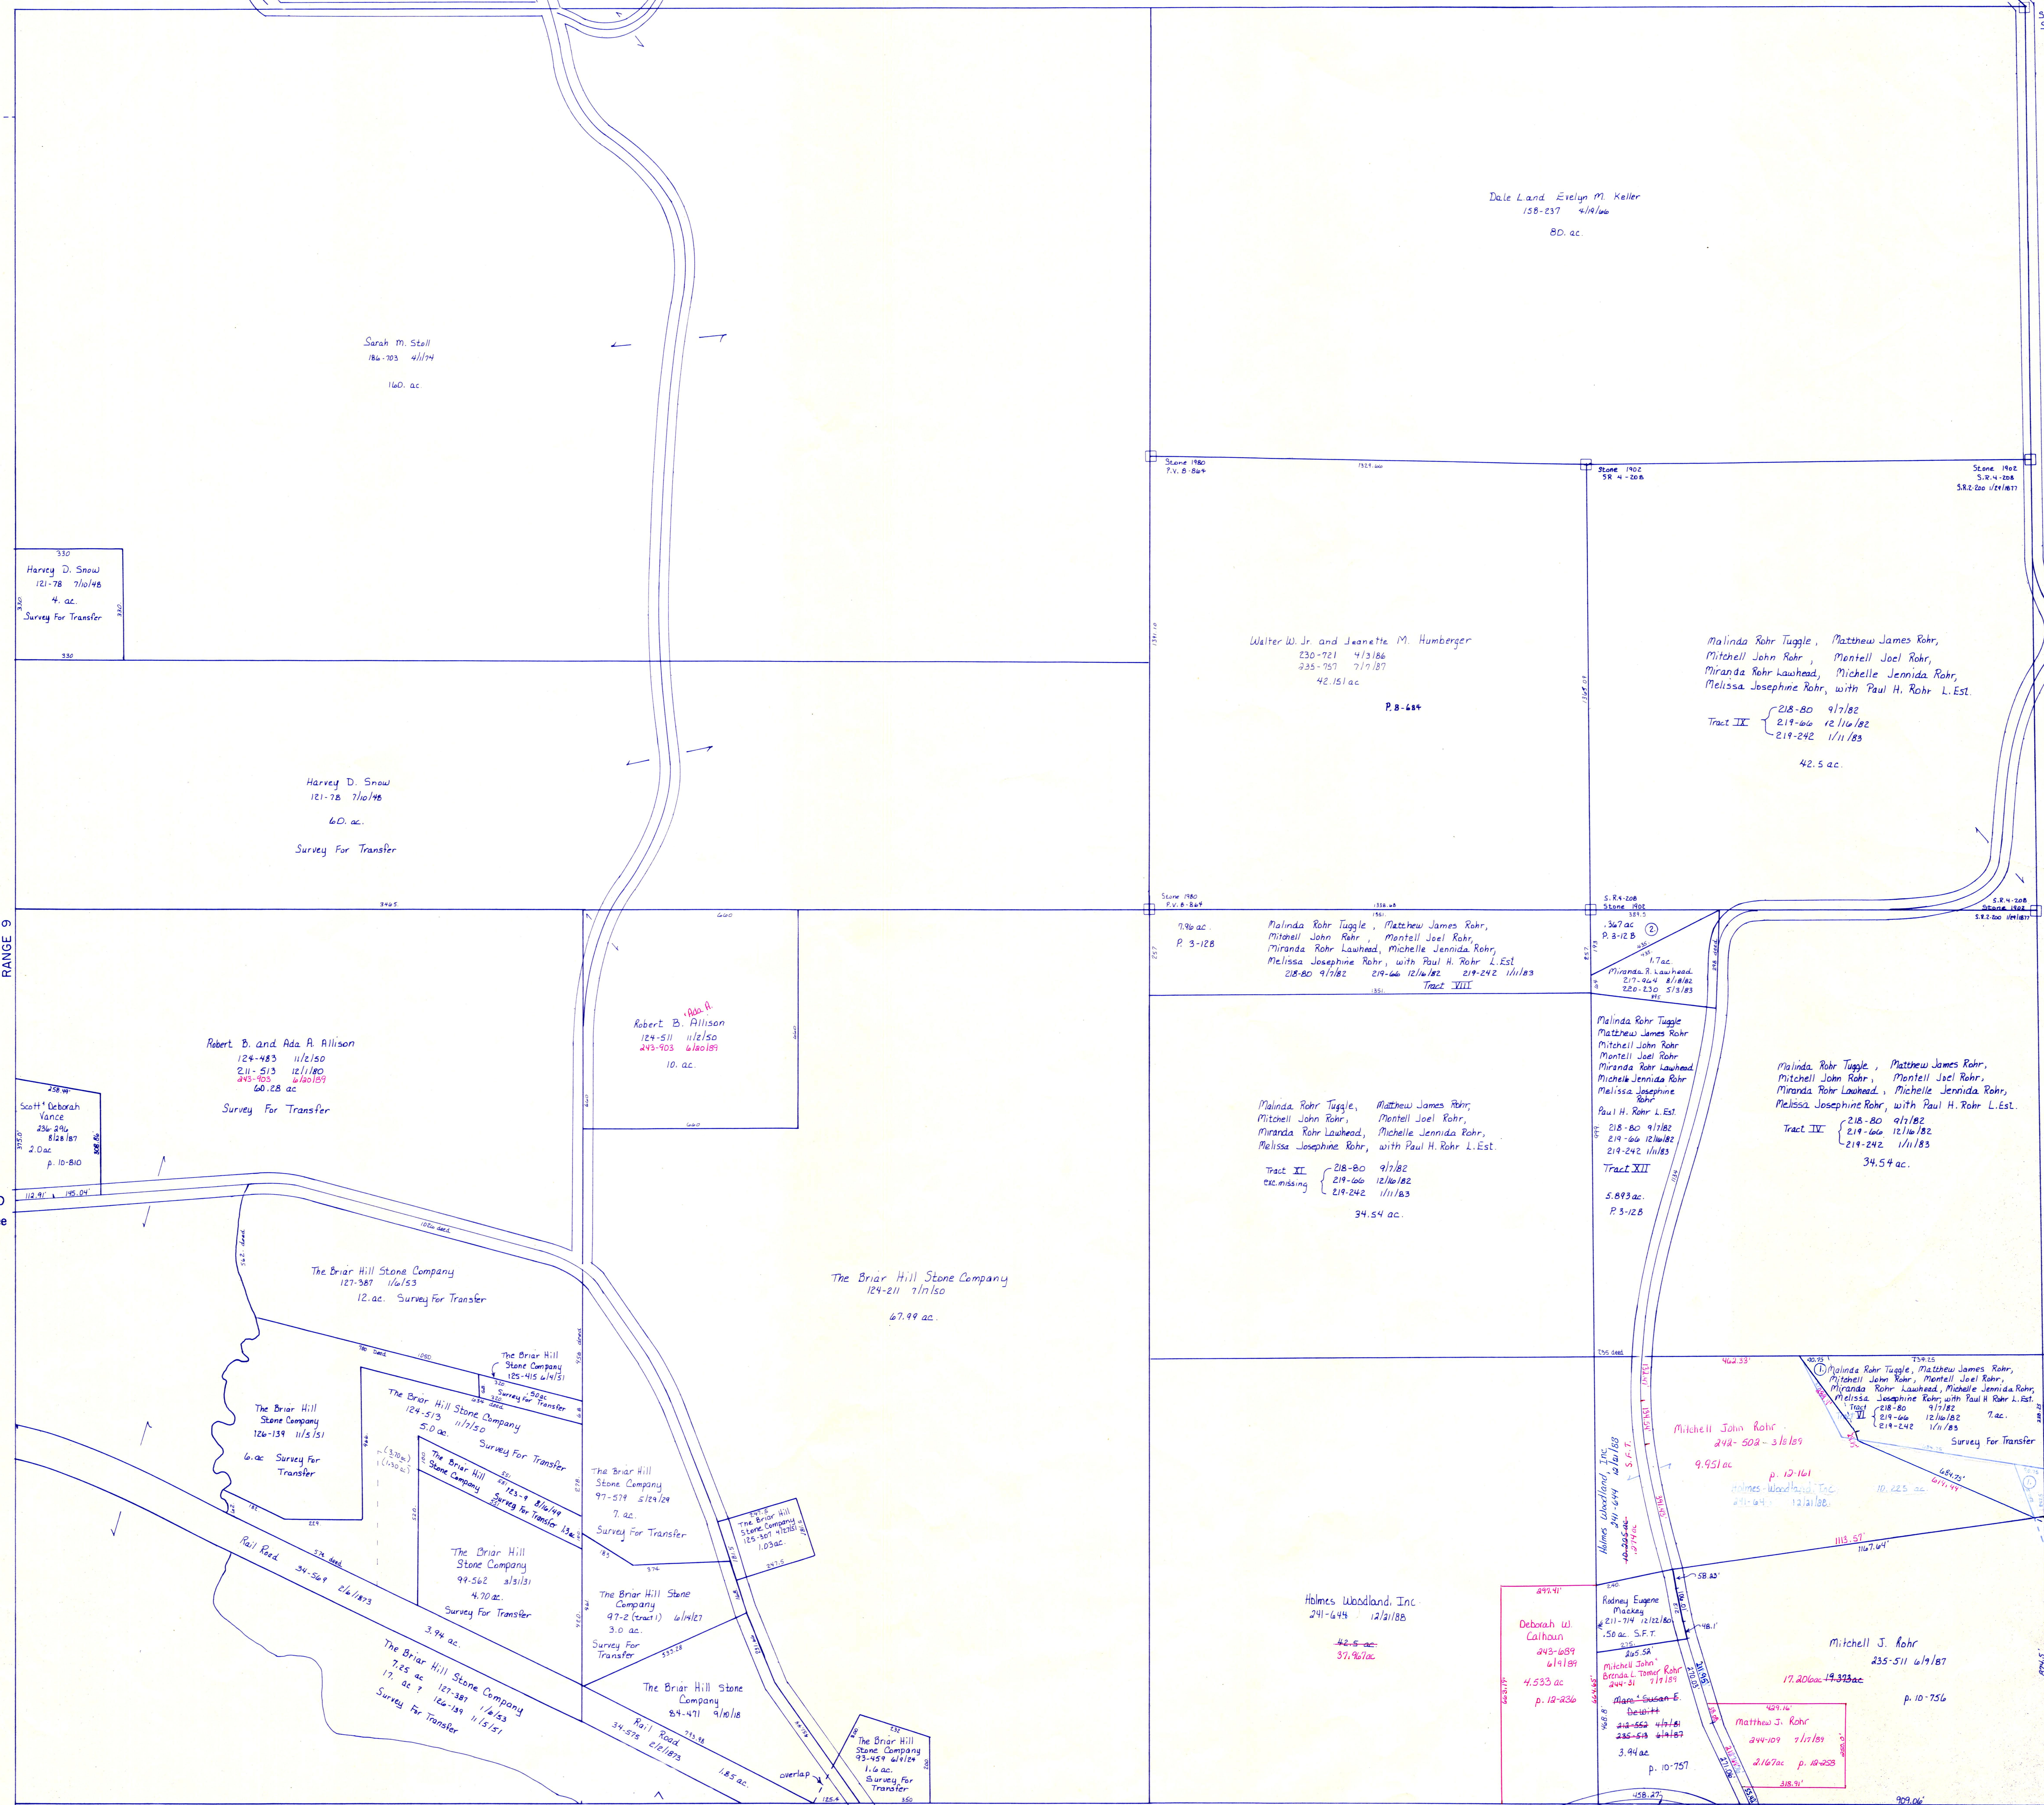

① .275 ac (94 rods) Survey For Transfer
 Malinda Rohr Tuggle, Matthew James Rohr,
 Mitchell John Rohr, Montell Joel Rohr,
 Miranda Rohr Lawhead, Michelle Jennida Rohr,
 Melissa Josephine Rohr, with Paul H. Rohr L. Est.
 (Tract VIII)

② .367 ac. P. 3-2/B Malinda Rohr Tuggle, Matthew James Rohr,
 Mitchell John Rohr, Montell Joel Rohr,
 Miranda Rohr Lawhead, Michelle Jennida Rohr,
 Melissa Josephine Rohr, with Paul H. Rohr L. Est.
 (Tract X)

Section 6
R-29

T-8, R-8, Sec. 5
RICHLAND TWP.
SCALE 1" = 200'

LET IT BE KNOWN, THIS MAP HAS BEEN PREPARED
 AS A REFERENCE GUIDE TO PROPERTY OWNERSHIP.
 WE BELIEVE THIS INFORMATION TO BE CORRECT
 AND CURRENT, HOWEVER, IT IS NOT INTENDED
 FOR ANY LEGAL USE, WHETHER IT BE IN SALES,
 TRANSFERS, TRADES, LEASES OF ANY TYPE, ETC.,
 AND DO NOT ACCEPT RESPONSIBILITY FOR ERRORS
 OF ANY NATURE OR OMISSIONS CONTAINED HEREIN.

R-30