


Section 4  
R-35

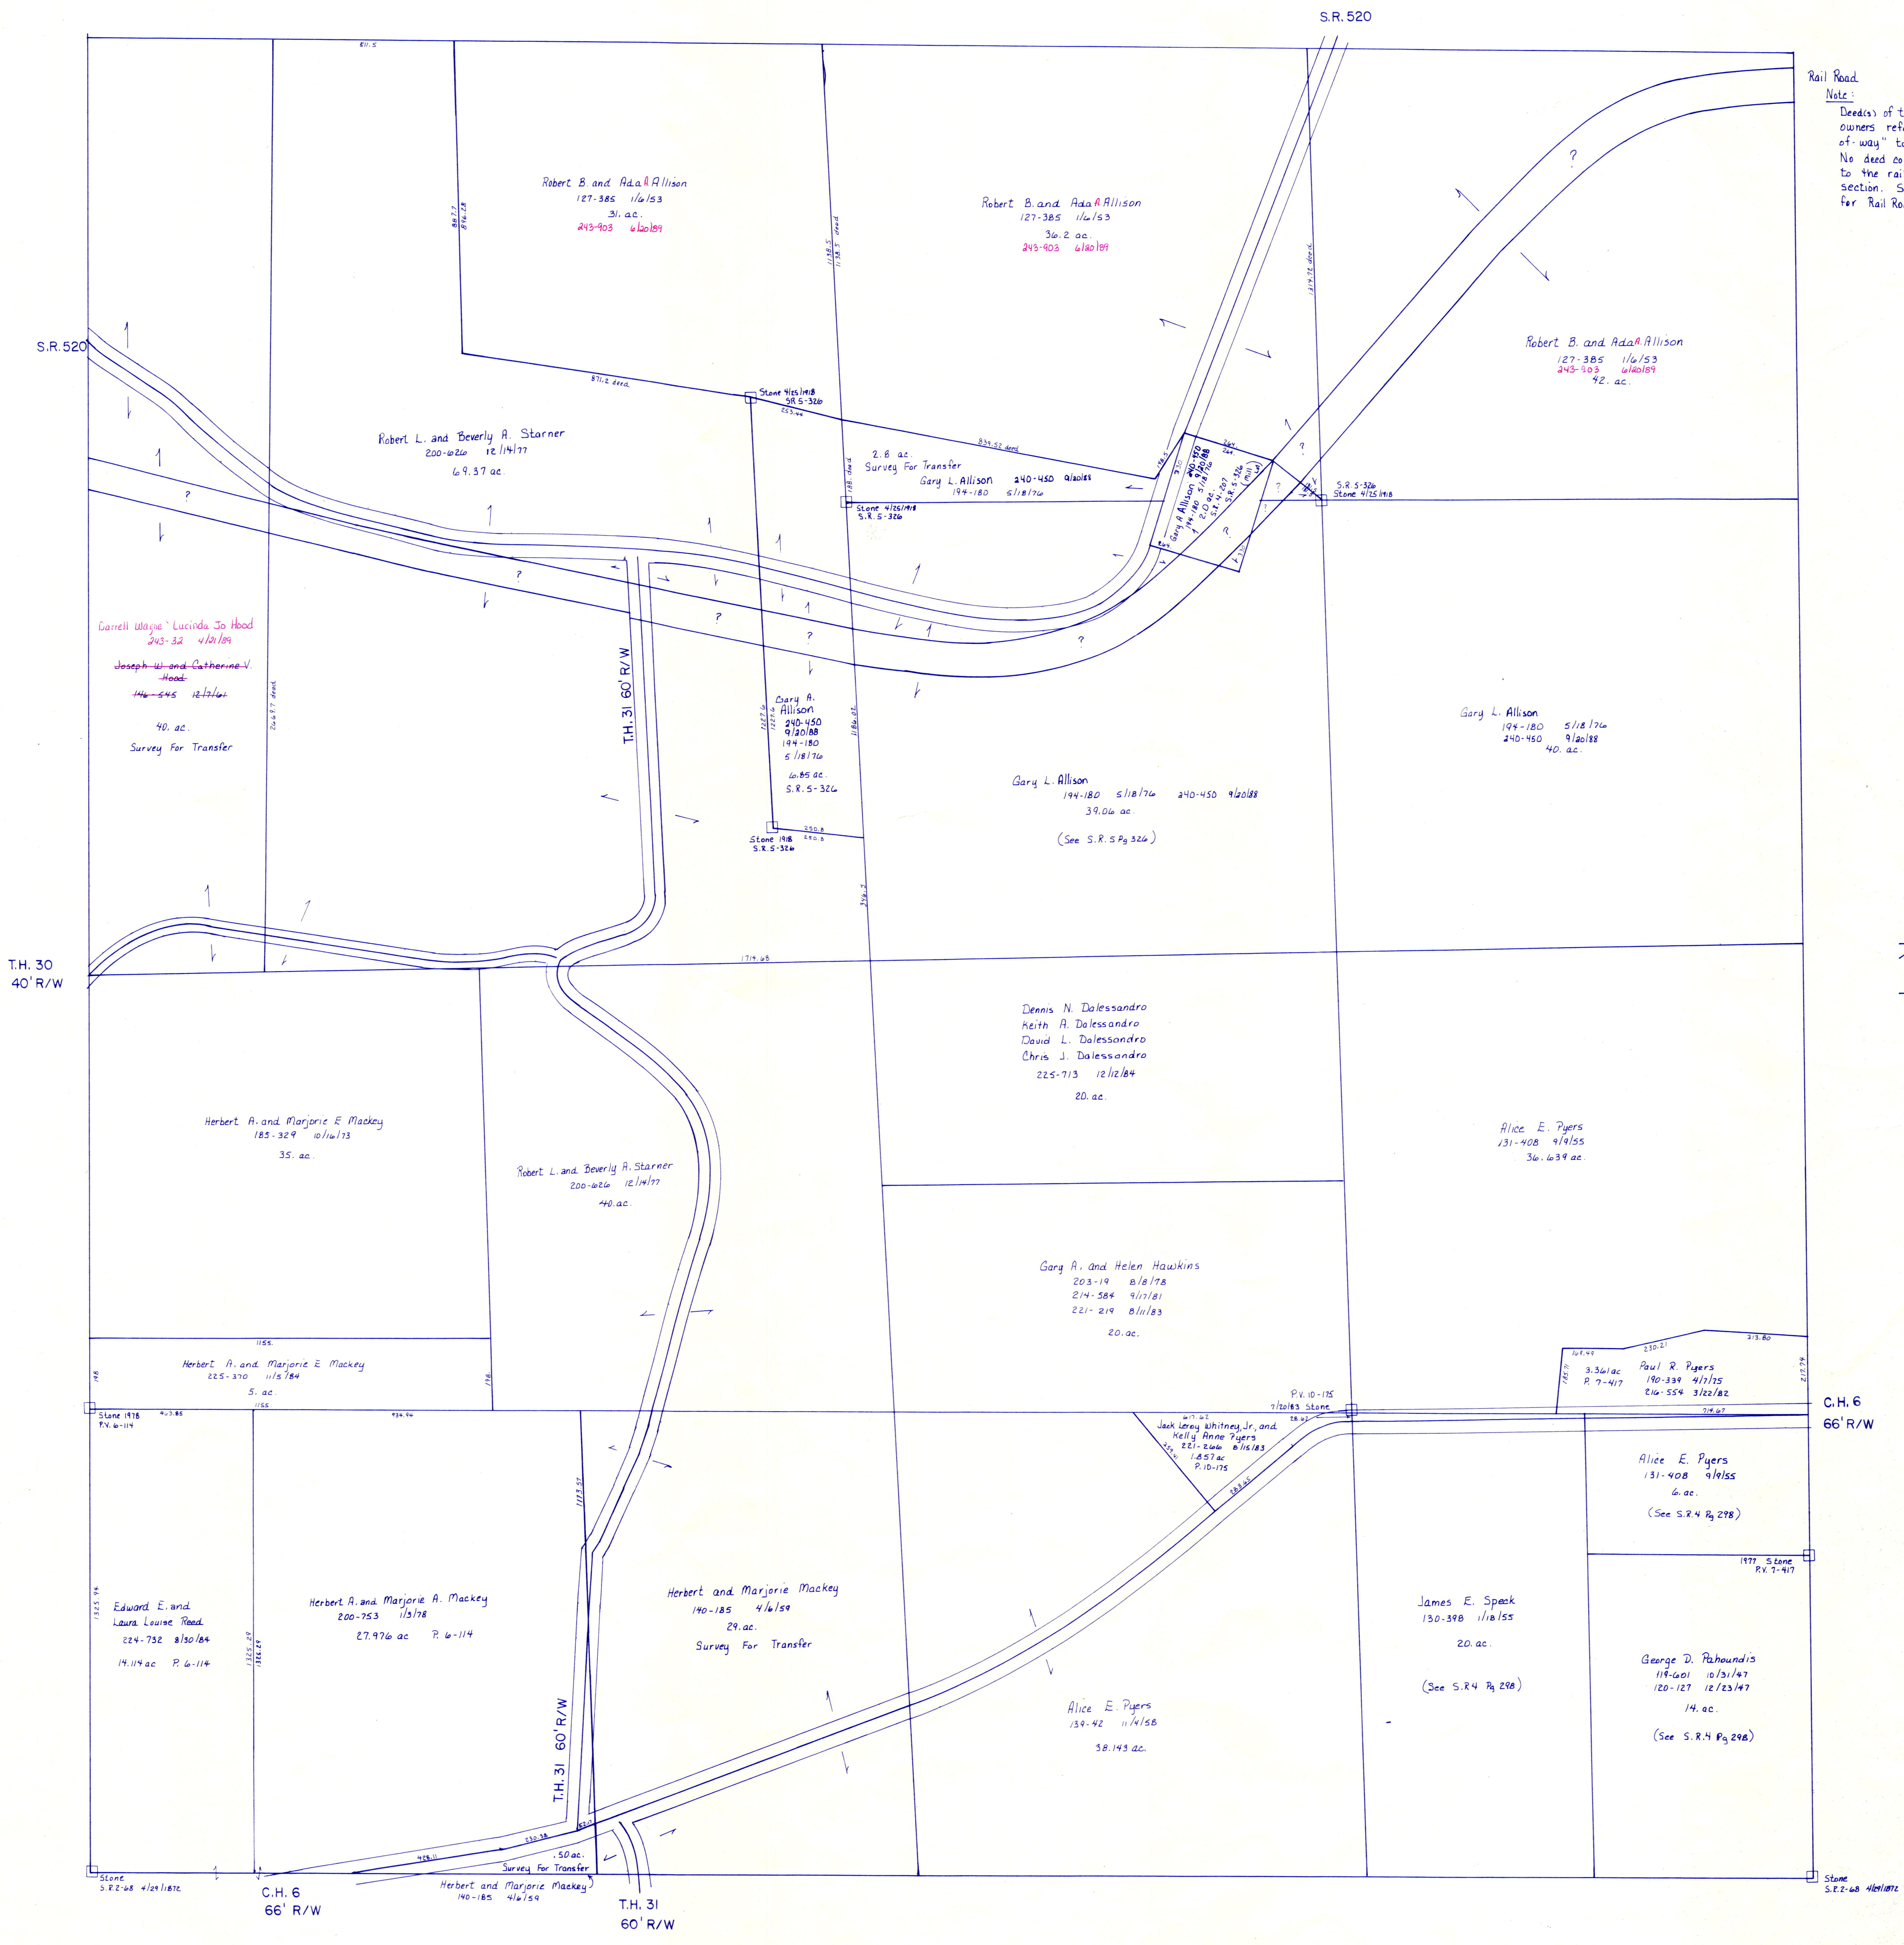

Rail Road  
Note:  
Deeds of the property owners refer to a "right-of-way" to the rail road. No deed could be found to the rail road in this section. See deed schedule for Rail Road Track Plans.

Section 6  
R-29

Kilbuck Twp.  
K-4

Section 14  
R-33

T-8, R-8, Sec. 7  
RICHLAND TWP.  
SCALE 1" = 200'

R-34

LET IT BE KNOWN, THIS MAP HAS BEEN PREPARED AS A REFERENCE GUIDE TO PROPERTY OWNERSHIP. WE BELIEVE THIS INFORMATION TO BE CORRECT AND CURRENT, HOWEVER, IT IS NOT INTENDED FOR ANY LEGAL USE, WHETHER IT BE IN SALES, TRANSFERS, TRADES, LEASES OF ANY TYPE, ETC., AND DO NOT ACCEPT RESPONSIBILITY FOR ERRORS OF ANY NATURE OR OMISSIONS CONTAINED HEREIN.