


Section 13  
R-13

C.H. 75  
60' R/W

S.R. 3-63  
9/11/1897

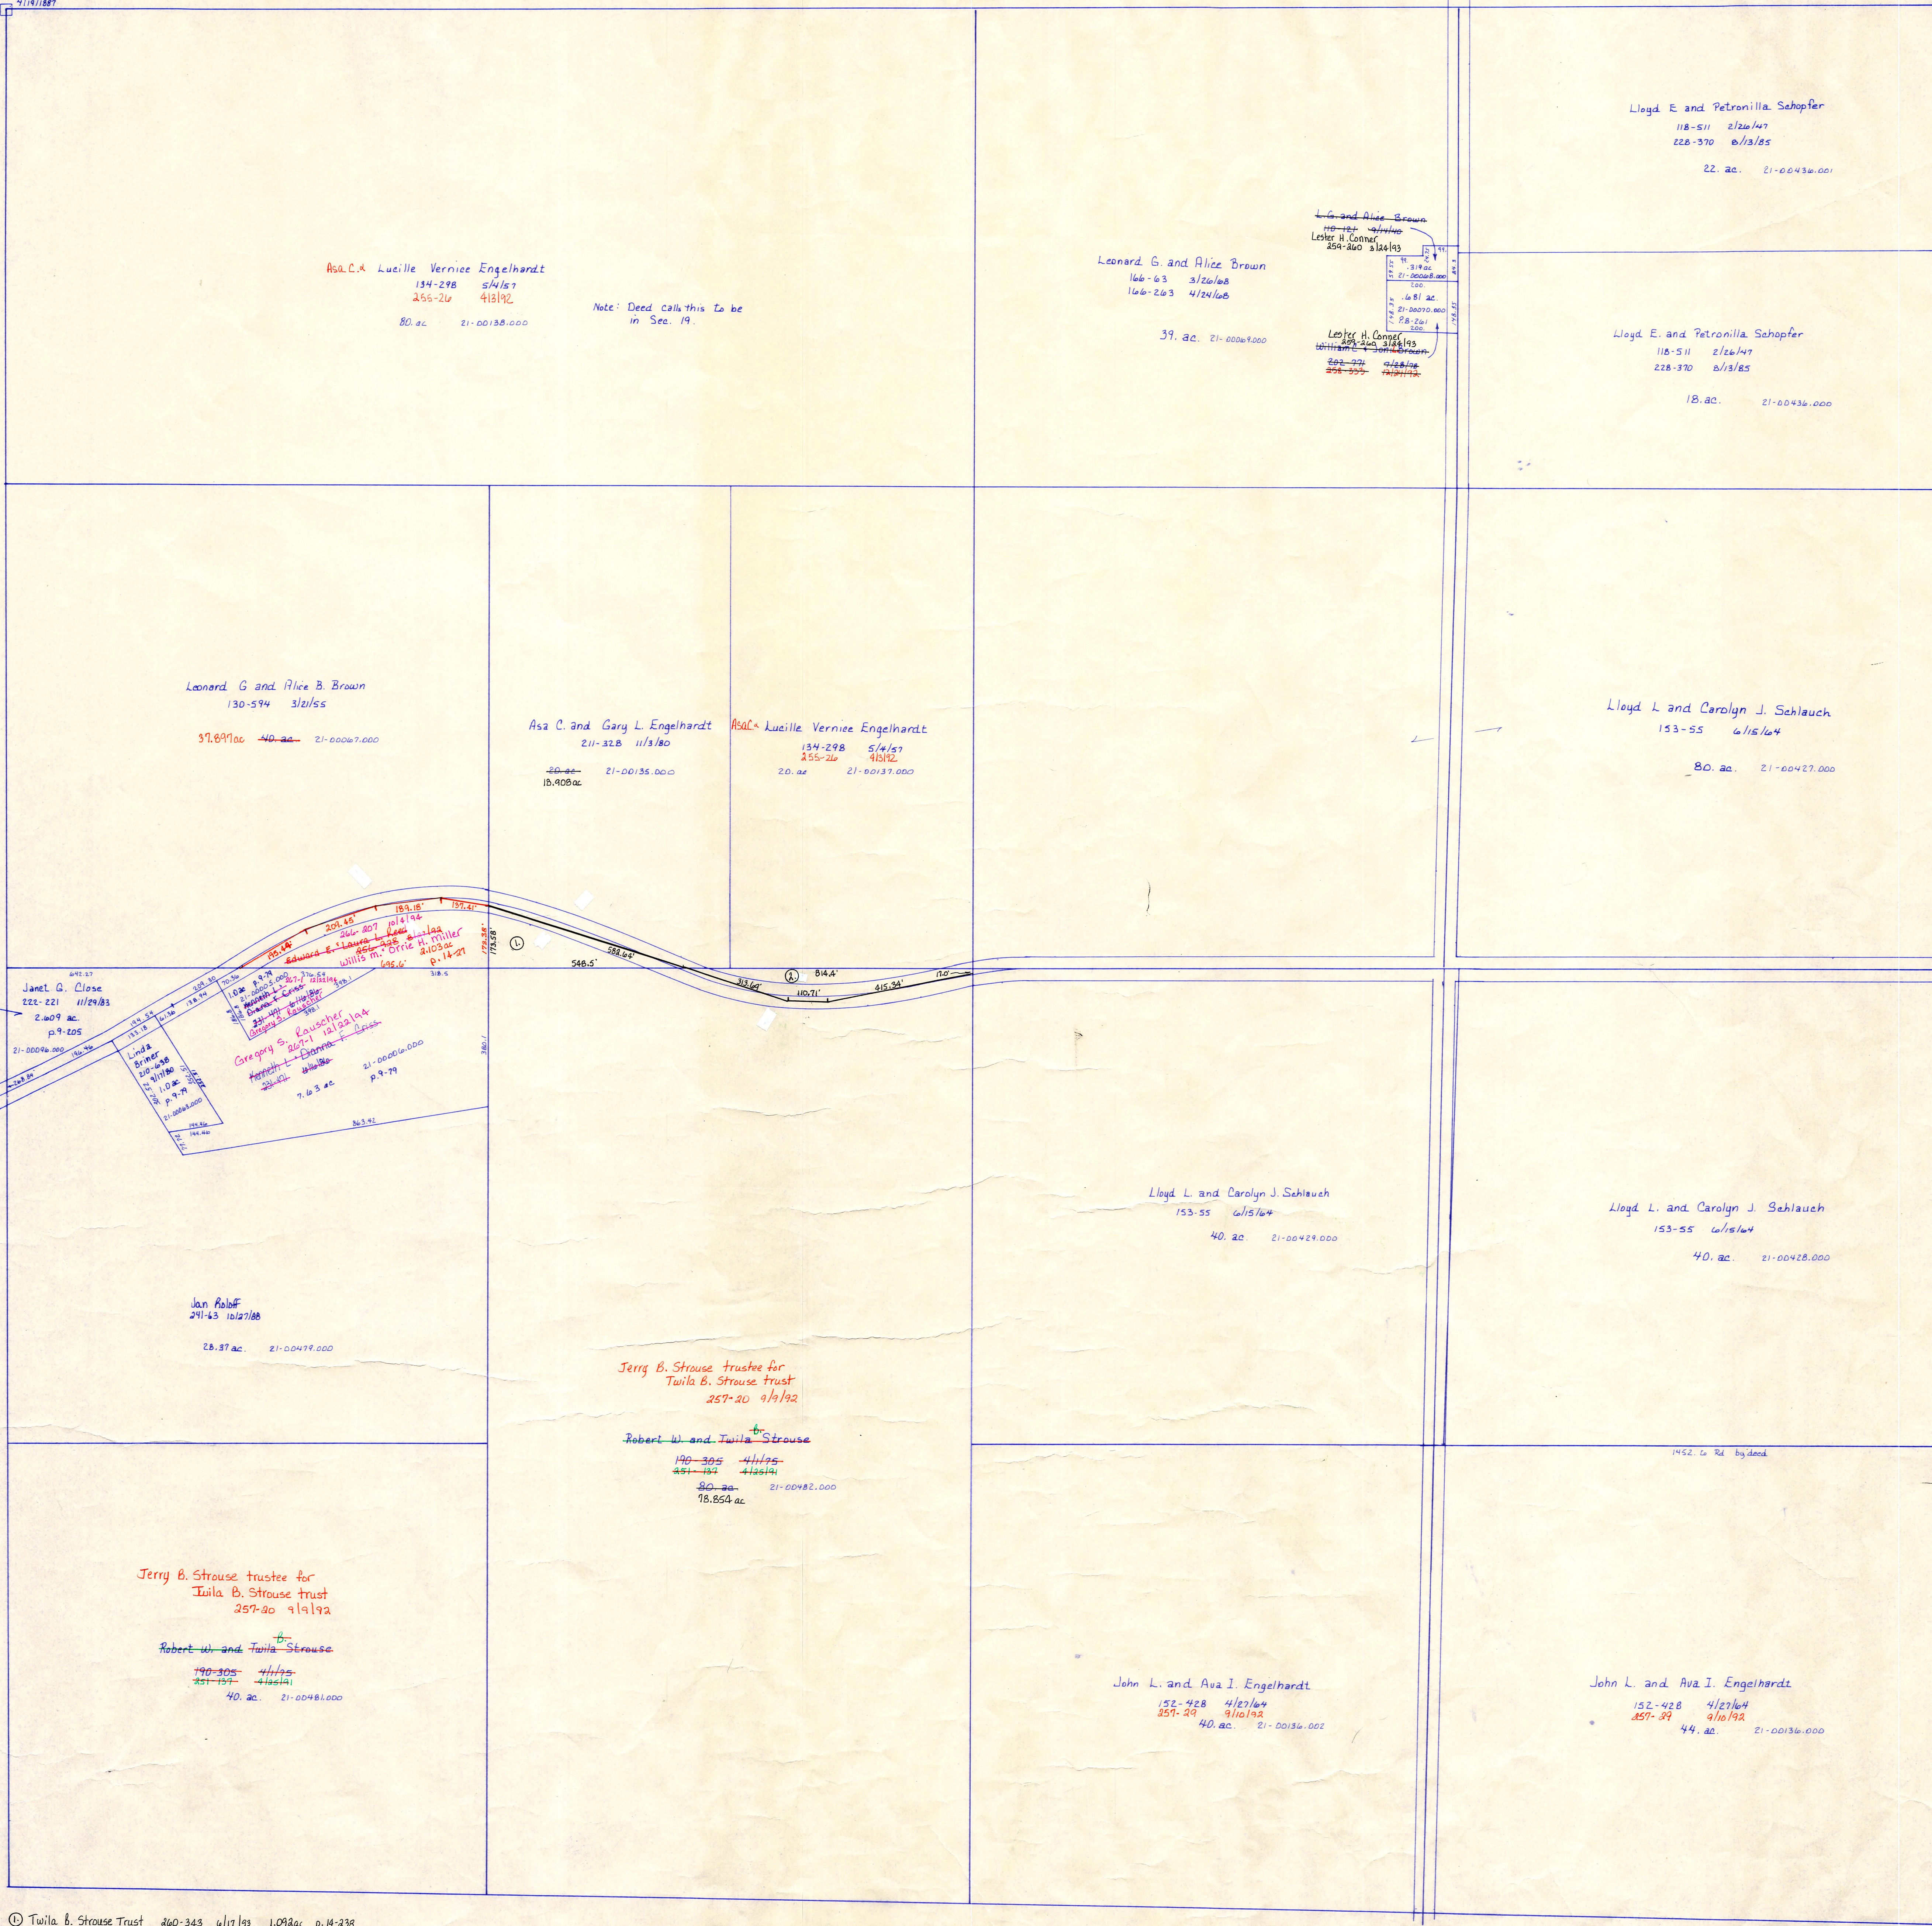

Section 17  
R-7

Section 19  
R-17

C.H. 25  
66' R/W

T.H. 13  
OLD T.H. 6  
66' R/W


C.H. 25  
60' R/W

Ⓢ Twila B. Strouse Trust 260-343 6/17/93 1.092ac p.14-238  
 Ⓢ Asa C. & Lucille V. Engelhardt 260-361 6/17/93 1.166ac p.14-238

Section 23  
R-11

T-8, R-9, Sec. 18  
 RICHLAND TWP.  
 SCALE 1" = 200'

LET IT BE KNOWN, THIS MAP HAS BEEN PREPARED AS A REFERENCE GUIDE TO PROPERTY OWNERSHIP. WE BELIEVE THIS INFORMATION TO BE CORRECT AND CURRENT, HOWEVER, IT IS NOT INTENDED FOR ANY LEGAL USE, WHETHER IT BE IN SALES, TRANSFERS, TRADES, LEASES OF ANY TYPE, ETC. AND DO NOT ACCEPT RESPONSIBILITY FOR ERRORS OF ANY NATURE OR OMISSIONS CONTAINED HEREIN.

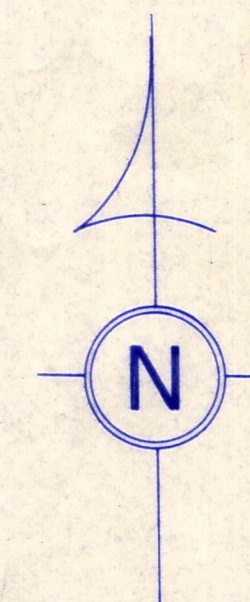

R-12