


Section 8  
R-14

T.H. 7  
60' R/W

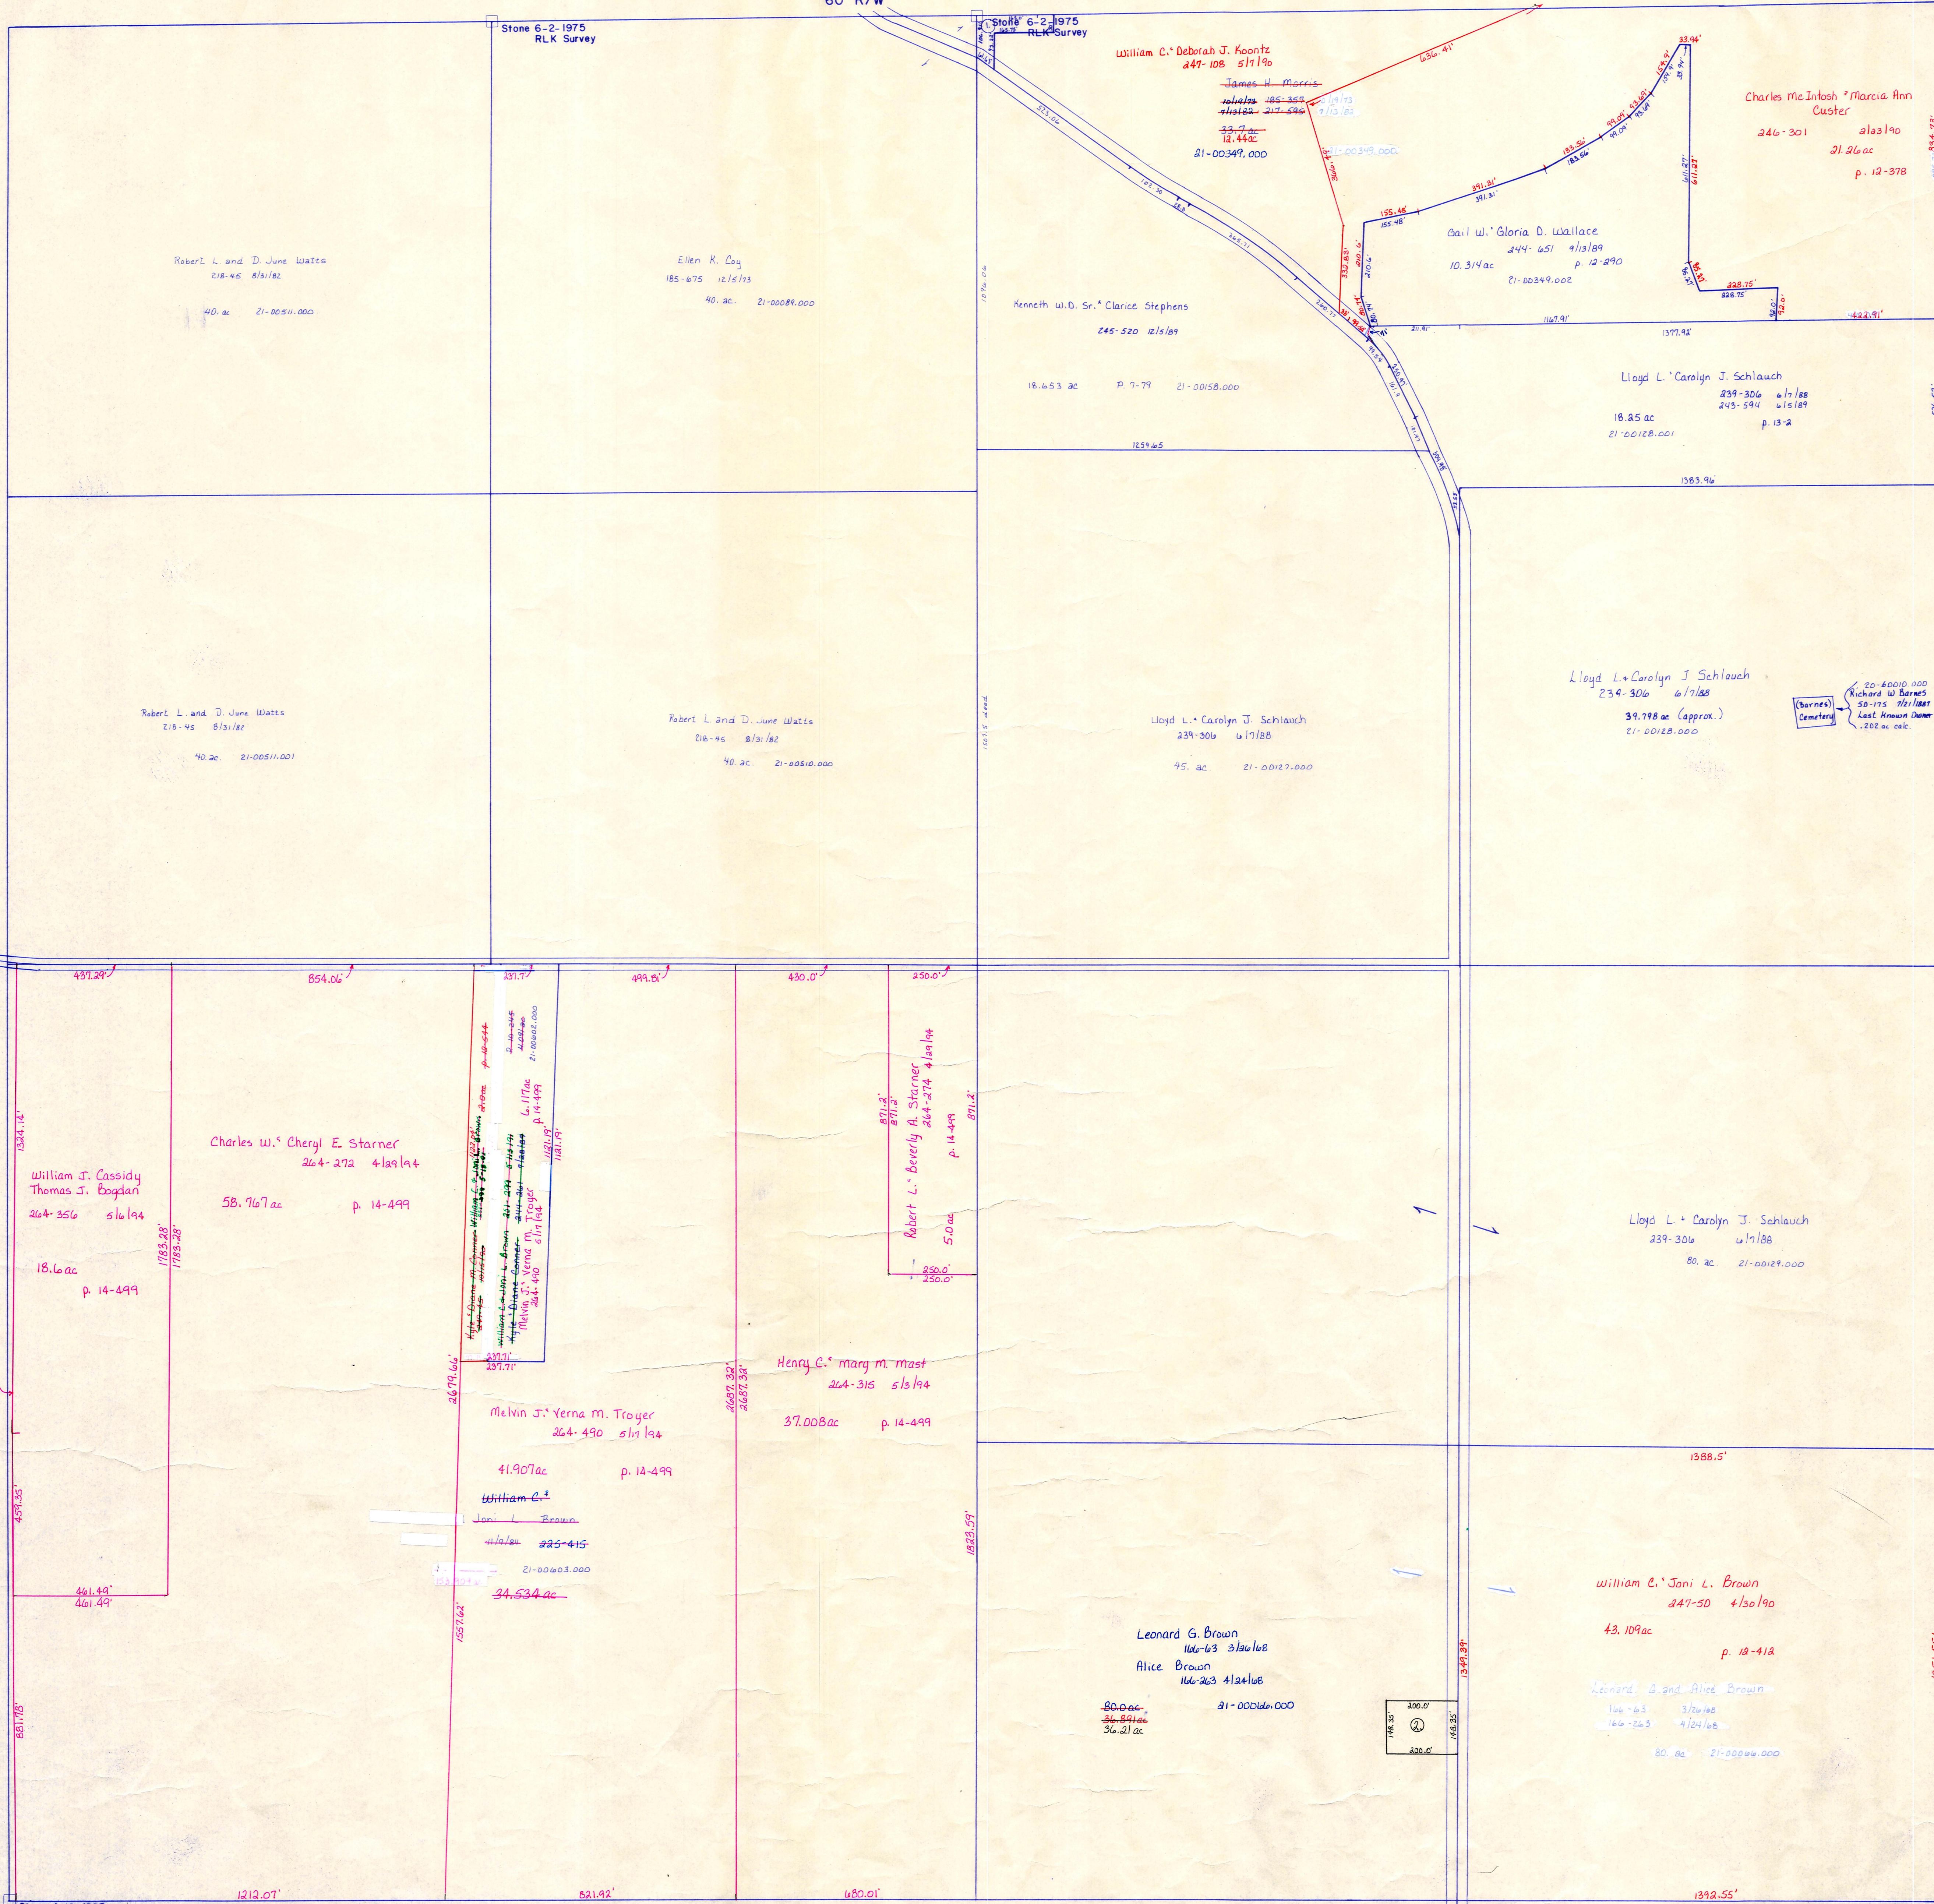

Section 14  
R-8

C.H. 75  
30' R/W

Section 12  
R-18

① William C. Deborah J. Koonitz 247-108 5/11/90 333 ac p. 12-2  
21-00349.000

② William C. Jani L. Brown 259-263 3/24/93 .681 ac p. 14-123

C.H. 75  
60' R/W

Section 18  
R-12

T-8, R-9, Sec 13  
RICHLAND TWP.  
SCALE 1" = 200'

LET IT BE KNOWN, THIS MAP HAS BEEN PREPARED AS A REFERENCE GUIDE TO PROPERTY OWNERSHIP. WE BELIEVE THIS INFORMATION TO BE CORRECT AND CURRENT, HOWEVER, IT IS NOT INTENDED FOR ANY LEGAL USE, WHETHER IT BE IN SALES, TRANSFERS, TRAILS, LEASES OF ANY TYPE, ETC., AND DO NOT ACCEPT RESPONSIBILITY FOR ERRORS OF ANY NATURE OR OMISSIONS CONTAINED HEREIN.

R-13