


Knox Twp.
KX-9

T.H. 225
NO R/W FOUND
OLD T.H. 279

T.H. 20
50' R/W OLD T.H. 380
30' R/W OLD T.H. 279

Section 4
R-10

Section 2
R-20

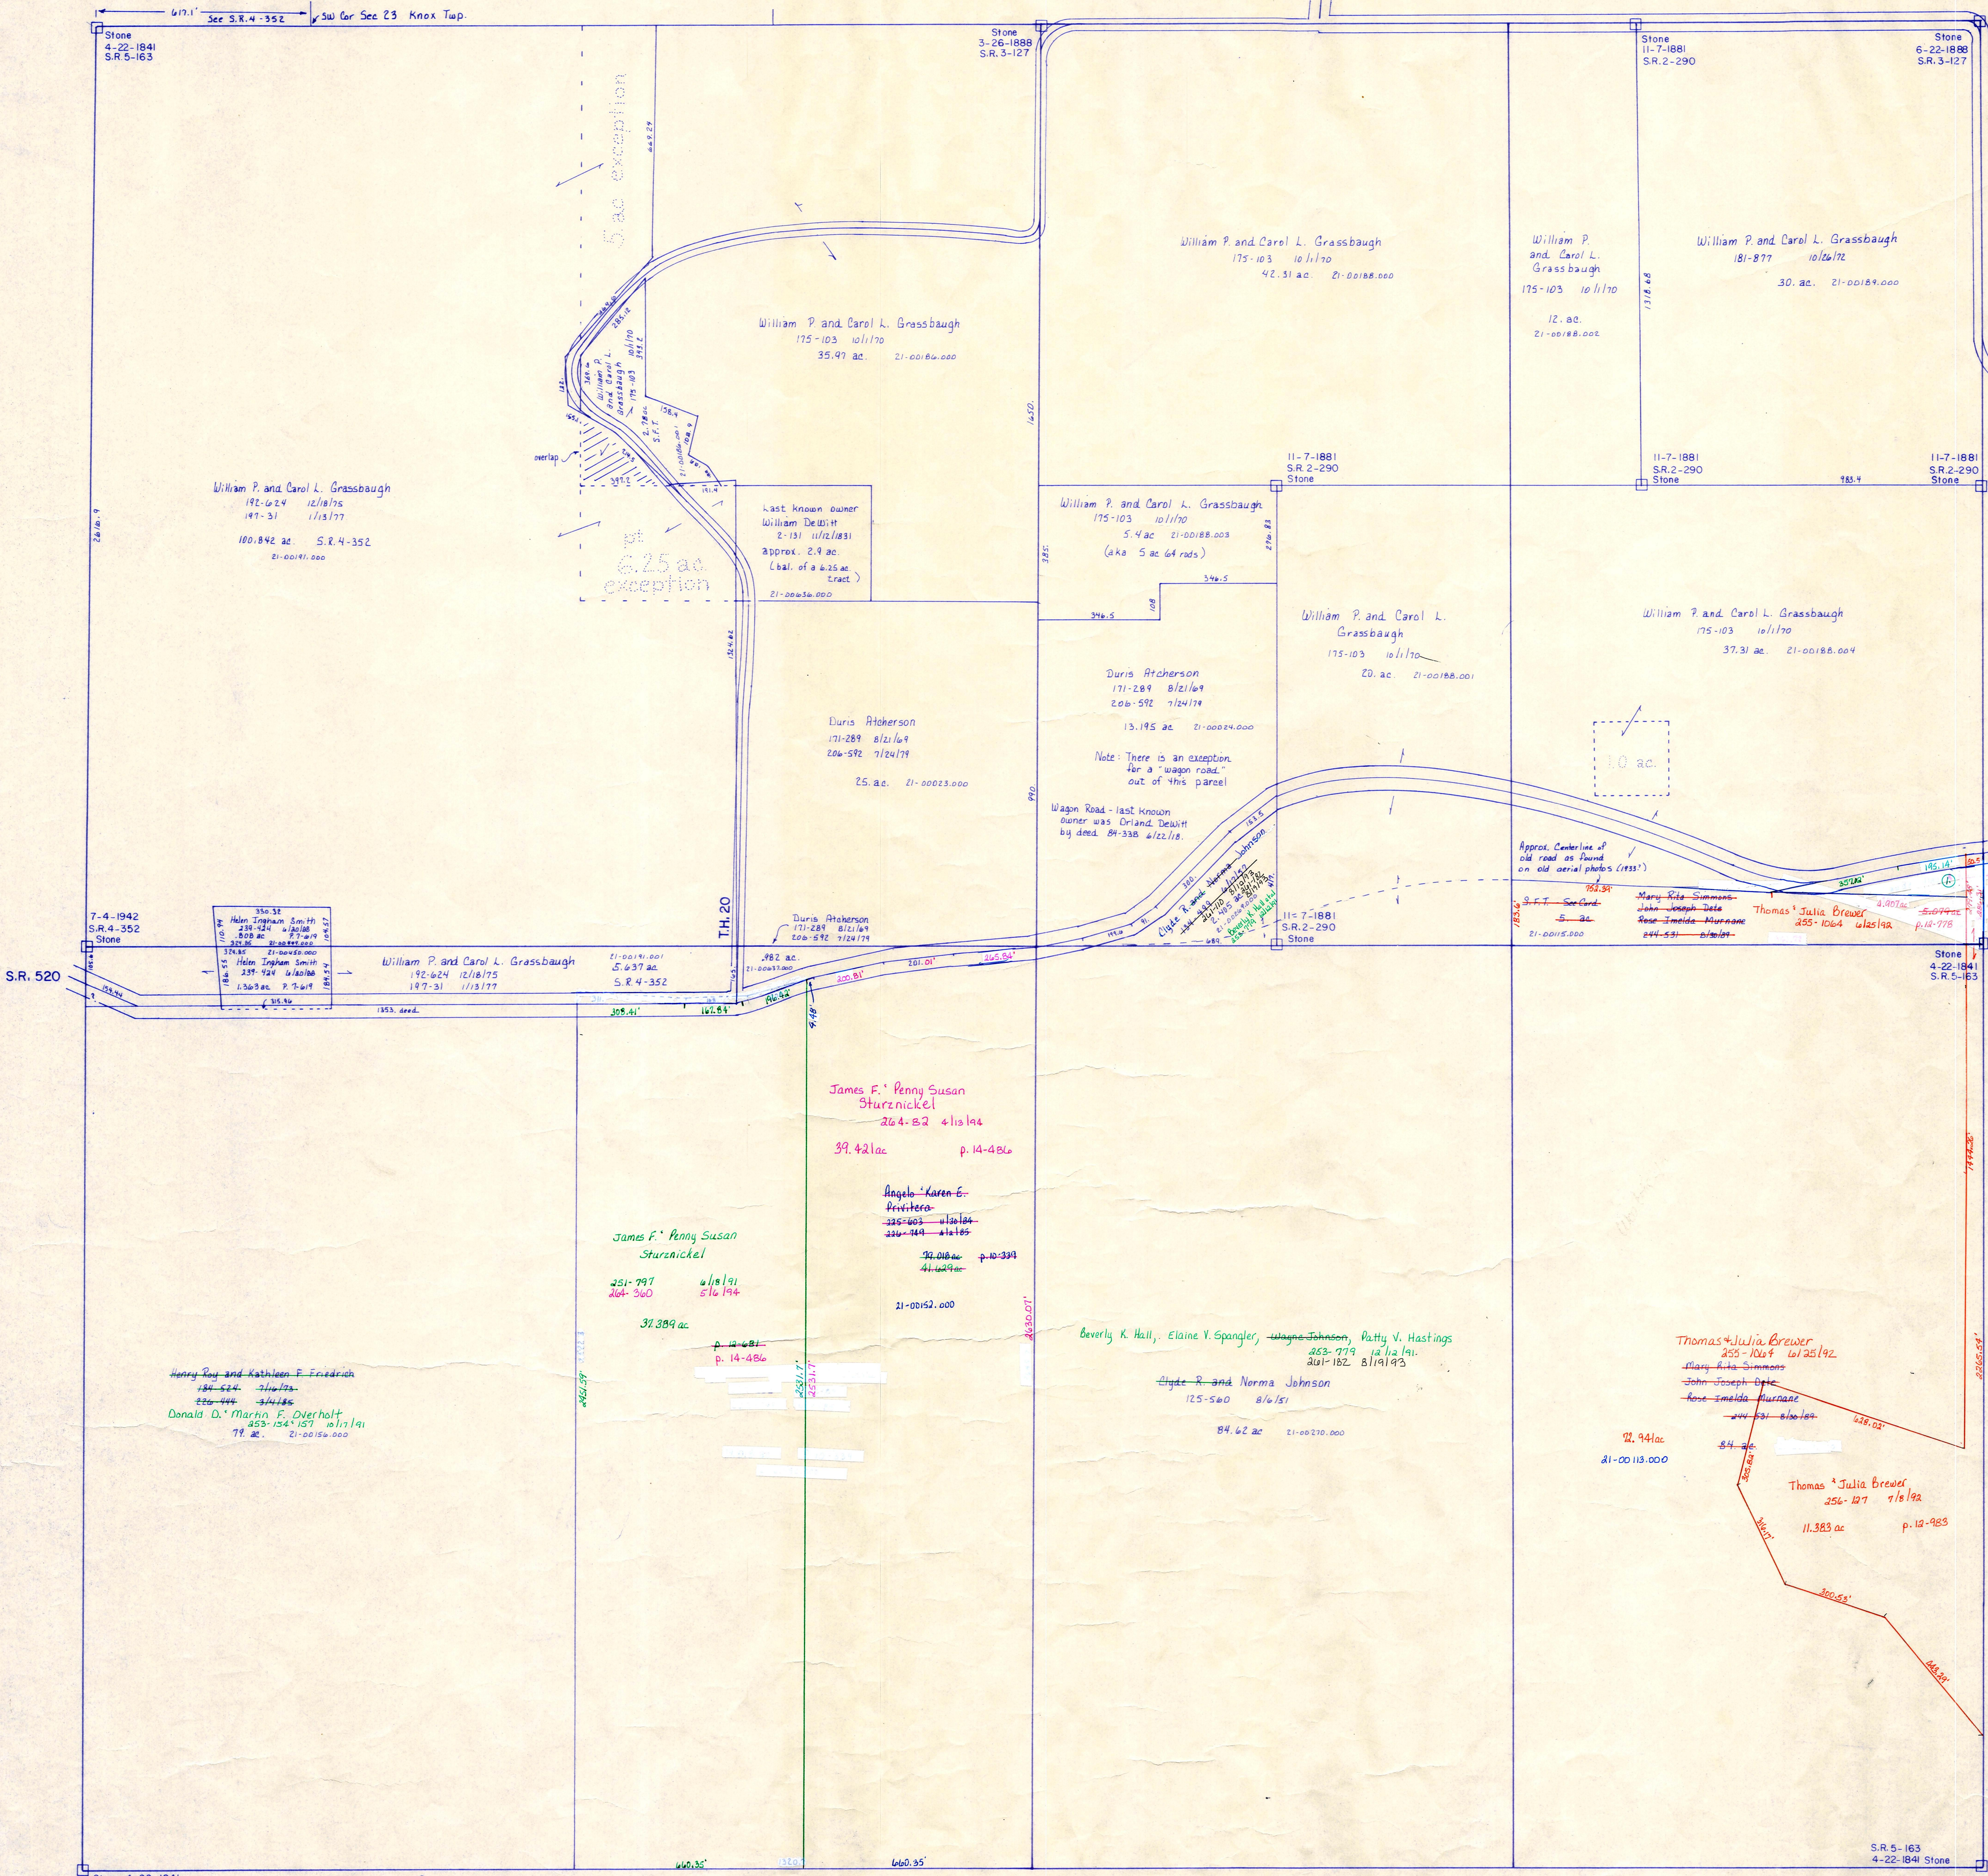

Thomas & Julia Brewer 255-1062 6/25/92 890 ac p. 12-778
Herbert E. & Mary D. Simmons 263-206 6/28/94 1230 ac p. 12-778

Section 8
R-14

T-8, R-9, Sec. 3
RICHLAND TWP.
SCALE 1"=200'

LET IT BE KNOWN, THIS MAP HAS BEEN PREPARED AS A REFERENCE GUIDE TO PROPERTY OWNERSHIP. WE BELIEVE THIS INFORMATION TO BE CORRECT AND CURRENT, HOWEVER, IT IS NOT INTENDED FOR ANY LEGAL USE, WHETHER IT BE IN SALES, TRANSFERS, TRADES, LEASES OF ANY TYPE, ETC., AND DO NOT ACCEPT RESPONSIBILITY FOR ERRORS OF ANY NATURE OR OMISSIONS CONTAINED HEREIN.

R-15