


Section 2
R-20

Section 8
R-14

Section 10
R-24

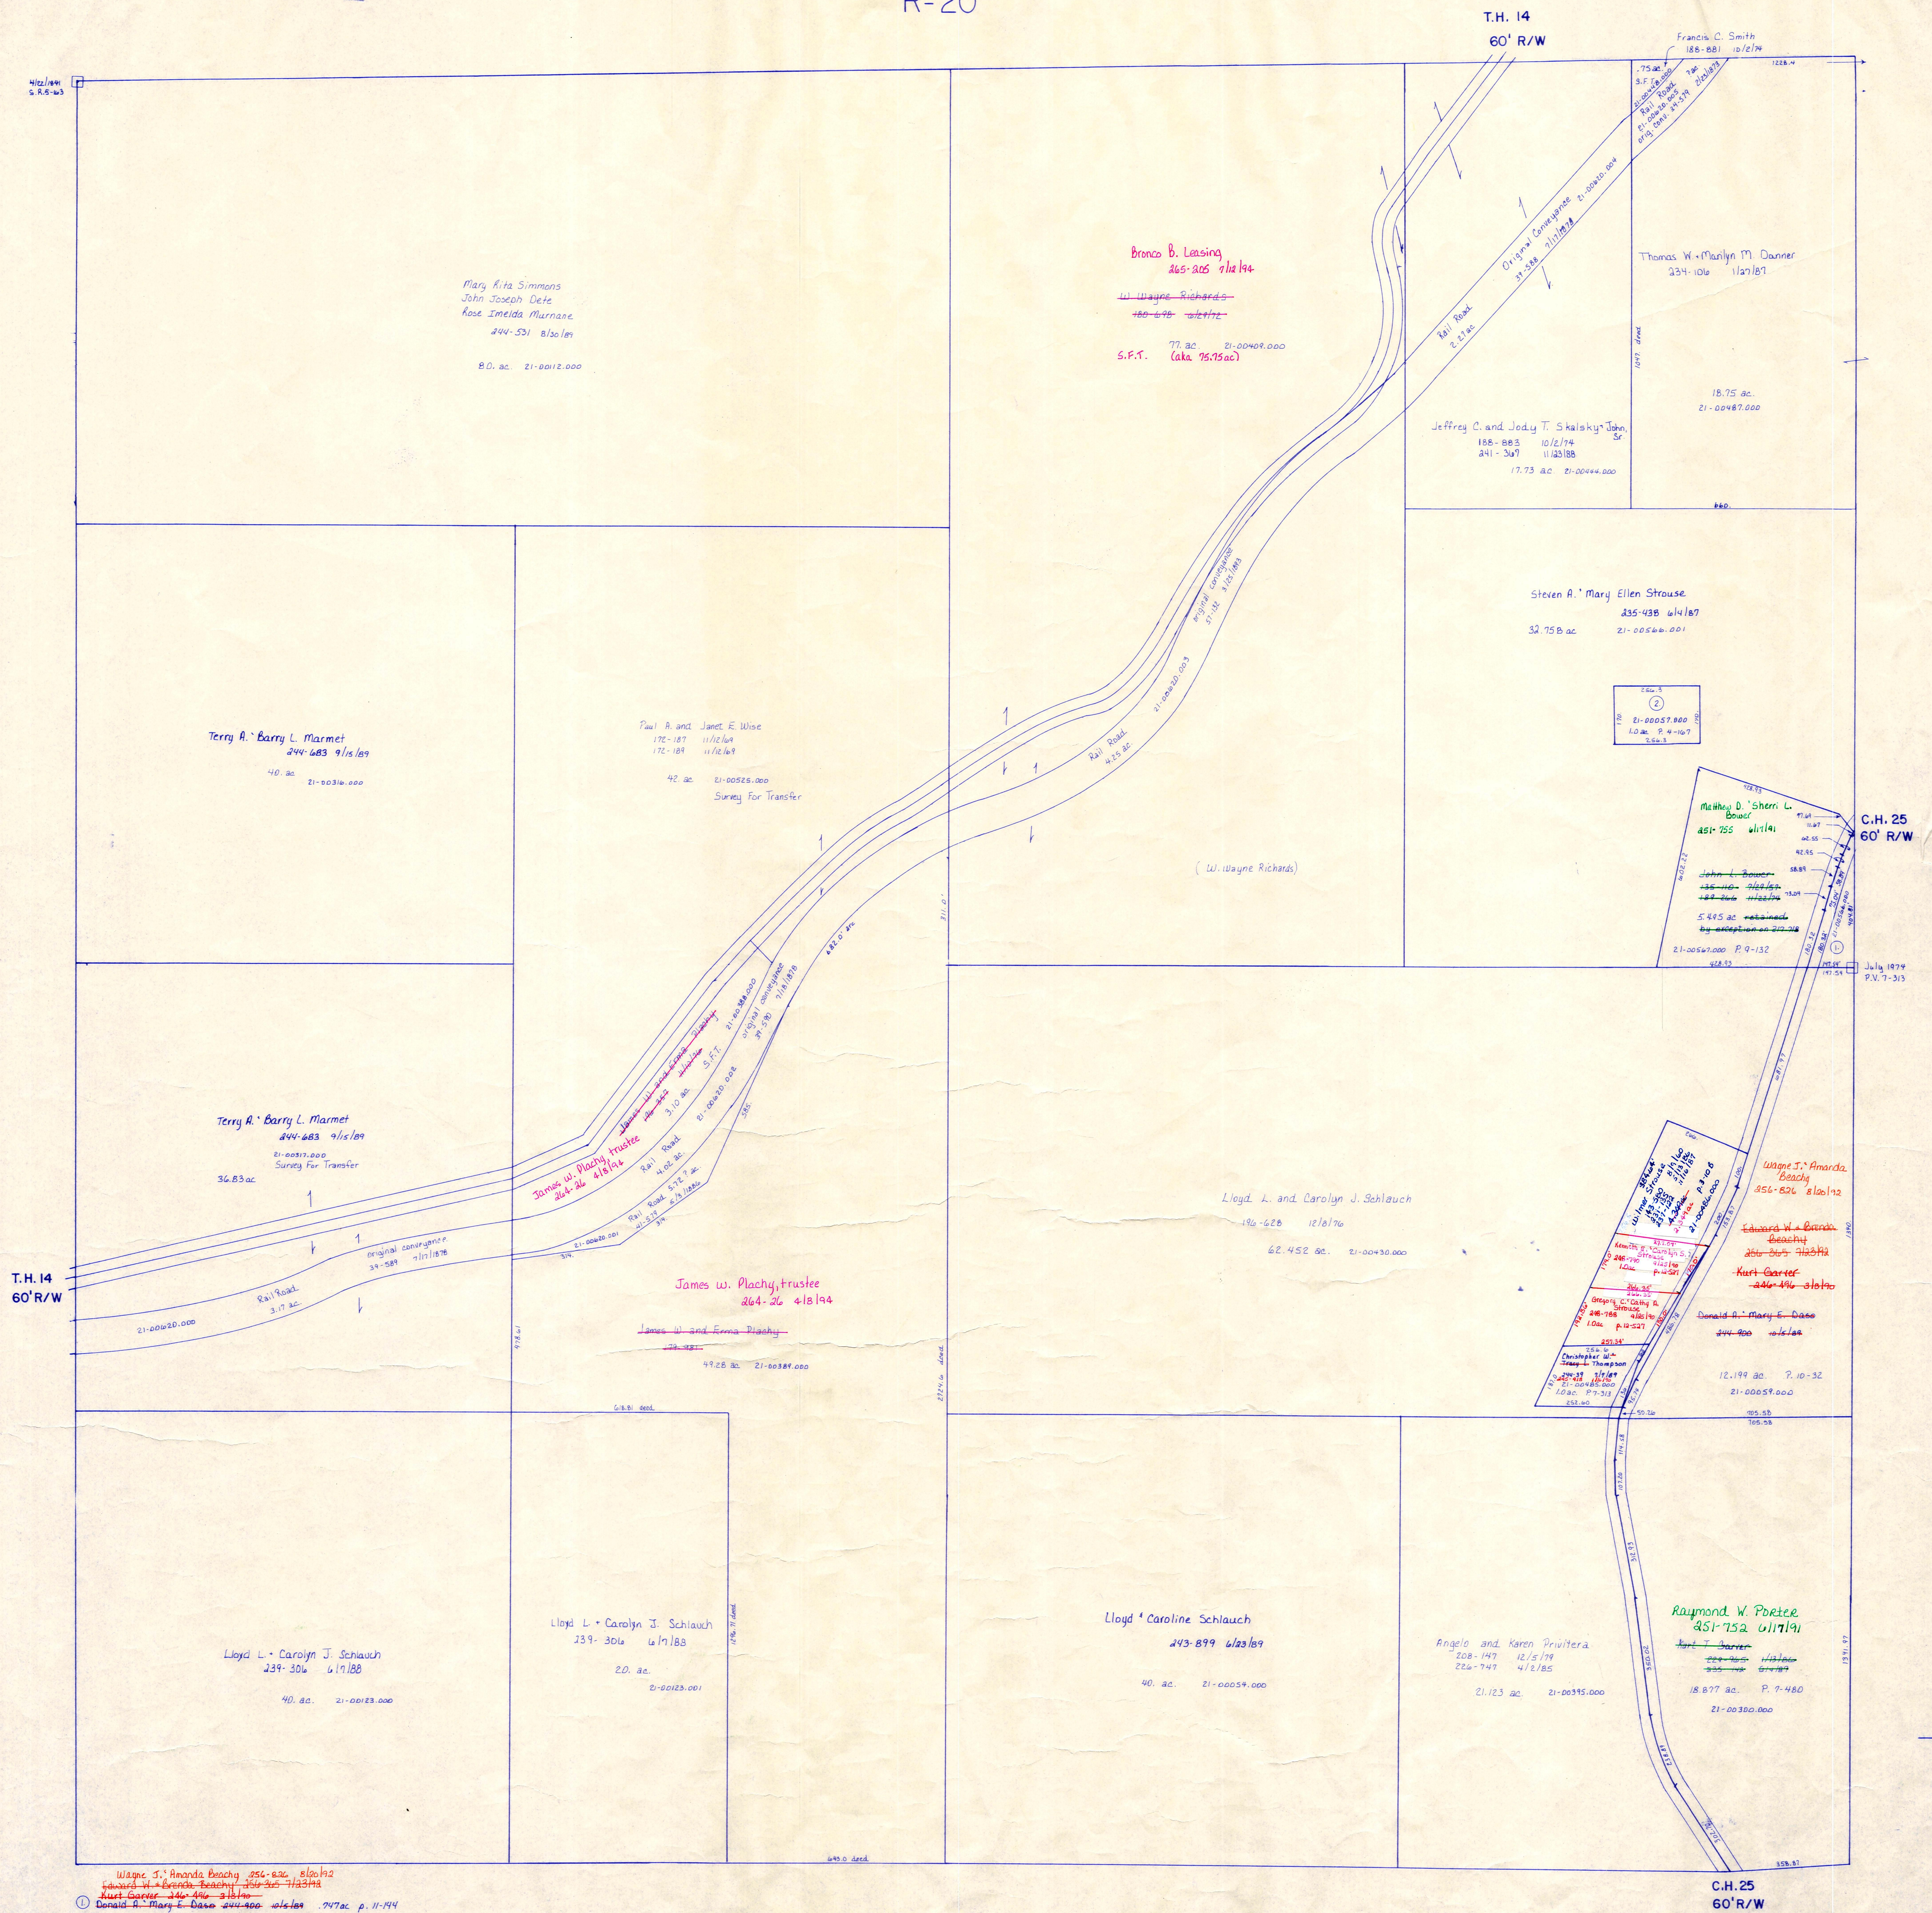

- ① Wayne S. Amada Beachy 256-626 8/20/92
- Edward W. Beachy 206-225 7/23/92
- Kurt Carter 246-416 8/18/90
- Donald R. Mary E. Dase 200-800 6/16/88 797 ac. p. 11-194
- ② Steven A. Mary Ellen Strouse 235-438 6/14/87 1.0 ac. P. 4-107

T-8, R-9, Sec. 9
RICHLAND TWP.
 SCALE 1" = 200'

Section 12
 R-18

LET IT BE KNOWN, THIS MAP HAS BEEN PREPARED AS A REFERENCE GUIDE TO PROPERTY OWNERSHIP. WE BELIEVE THIS INFORMATION TO BE CORRECT AND CURRENT, HOWEVER, IT IS NOT INTENDED FOR ANY LEGAL USE, WHETHER IT BE IN SALES, TRANSFERS, TRADES, LEASES OF ANY TYPE, ETC. AND DO NOT ACCEPT RESPONSIBILITY FOR ERRORS OF ANY NATURE OR OMISSIONS CONTAINED HEREIN.

R-19