

Section 5
R-30


T.H. 36 R/W-Unknown
OLD T.H. 283

SR. 520

S.R. 520

Section 10
R-24

Section 7
R-34
T.H. 30
40' R/W
See C.J. 26
Pg. 7 and 174
For Partial
Vacation of
T.H. 30

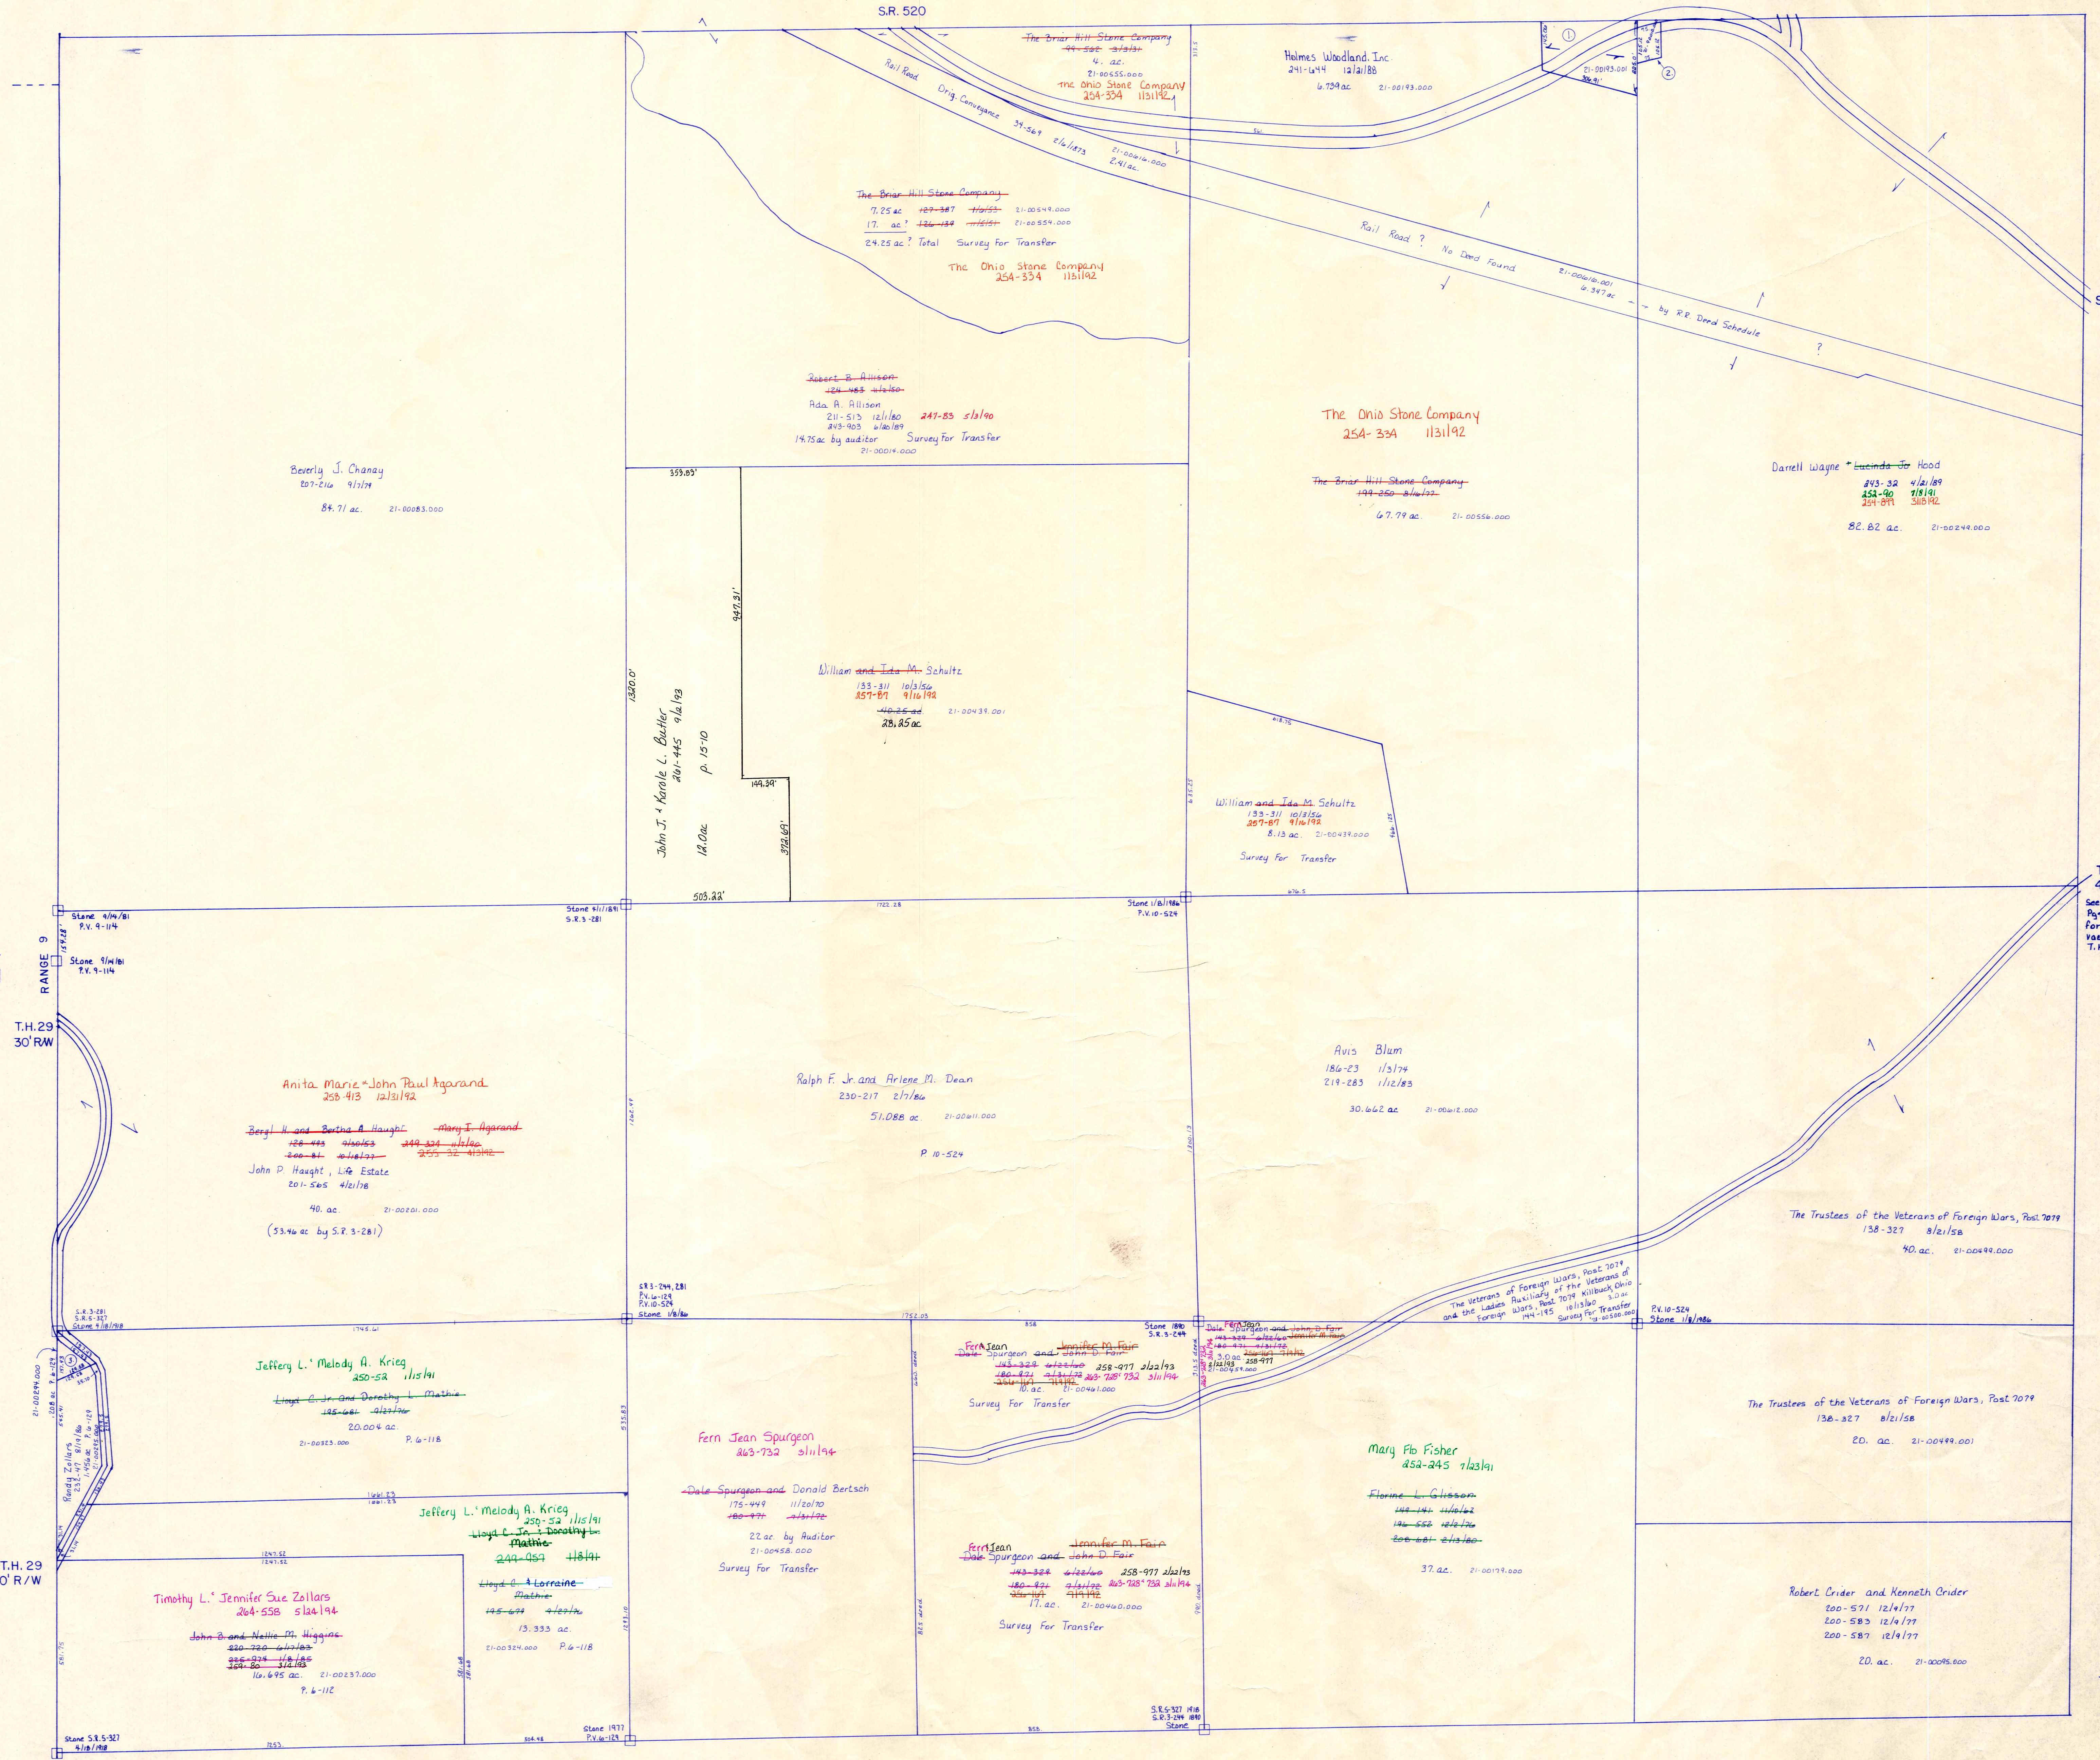

- ① Deborah W. Calhoun 243-689 4/6/89 1.261 ac P. 10-236
- ② Ohio Power Company 95-449 12/1/82 1.8 ac
- ③ Randy Zellars 232-47 8/18/86 .206 ac P. 6-129

Section 15
R-28

T-8, R-8, Sec. 6
RICHLAND TWP.
SCALE 1" = 200'

LET IT BE KNOWN, THIS MAP HAS BEEN PREPARED AS A REFERENCE GUIDE TO PROPERTY OWNERSHIP. WE BELIEVE THIS INFORMATION TO BE CORRECT AND CURRENT; HOWEVER, IT IS NOT INTENDED FOR ANY LEGAL USE, WHETHER IT BE IN SALES, TRANSFERS, TRADES, LEASES OF ANY TYPE, ETC., AND DO NOT ACCEPT RESPONSIBILITY FOR ERRORS OF ANY NATURE OR OMISSIONS CONTAINED HEREIN.

R-29